


WALWORTH COUNTY
SURVEYING & MAPPING
LAKE GENEVA, WISCONSIN

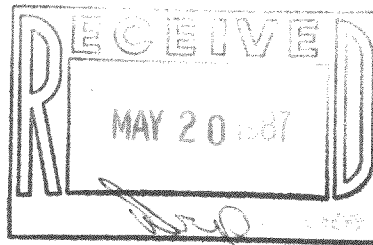


ACACIA ROAD

100.00'

DAISY DRIVE

200.00'

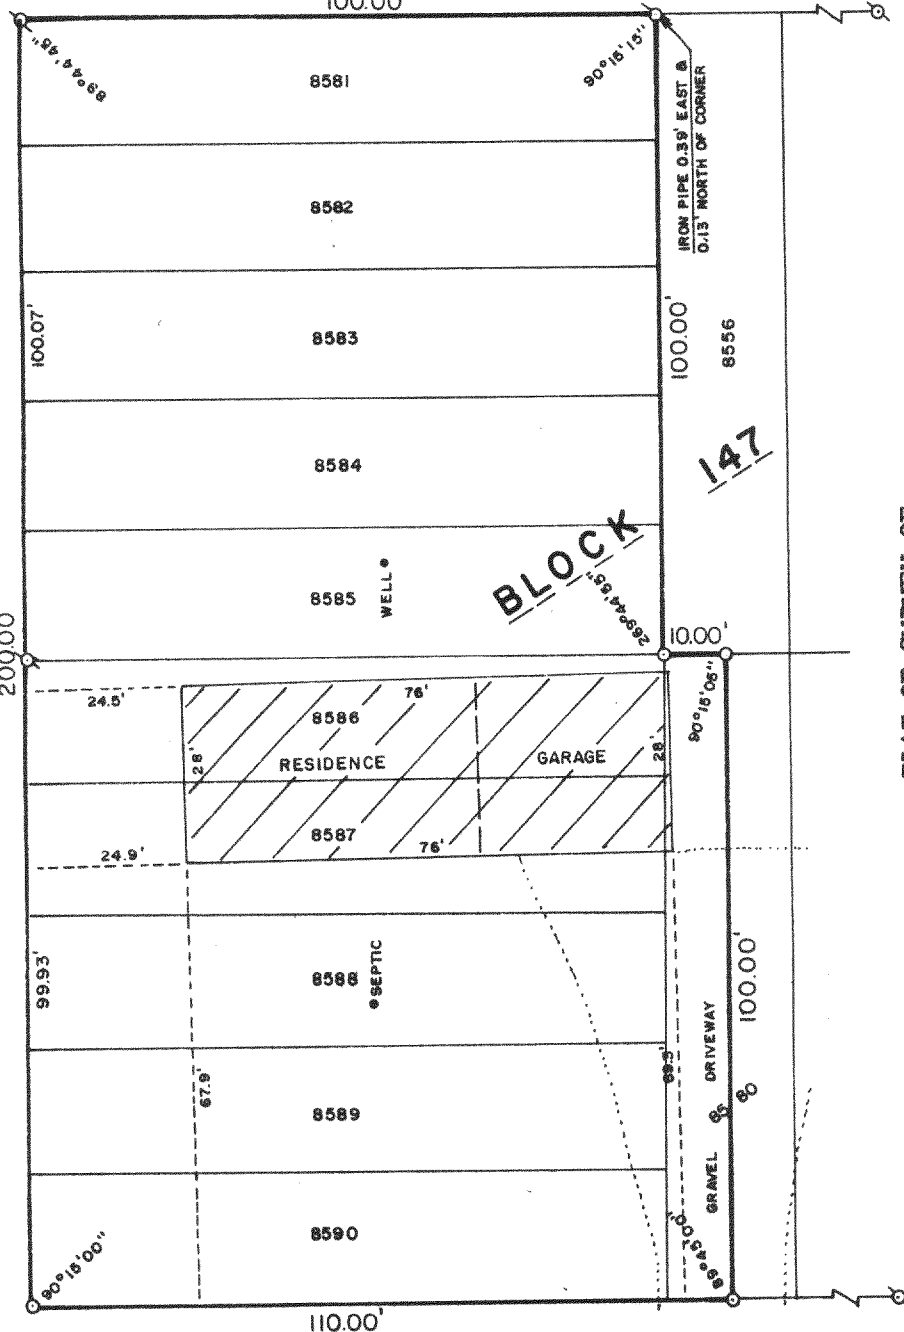

BLOCK 147


PLAT OF SURVEY OF

THE NORTH 1/2 OF LOT 8580 AND ALL OF LOTS
8581-8590, BLOCK 147 OF LAKE COMO BEACH, A
SUBDIVISION LOCATED IN T 2 N, R 17 E,
WALWORTH COUNTY, WISCONSIN.

ORDERED BY: KEEFE REAL ESTATE
704 MAIN STREET
LAKE GENEVA, WISCONSIN 53147

BEACH ROAD

110.00'

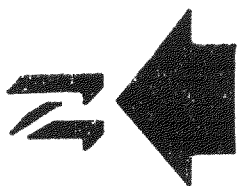

SCALE: 1"=30'

○ - IRON PIPE FOUND
○ - IRON ROD PLACED

I, ROBERT M. BAERENWALD, DO HEREBY CERTIFY THAT I
HAVE SURVEYED THE PROPERTY HEREON DESCRIBED ACCORDING
TO THE OFFICIAL RECORDS AND THAT THE PLAT HEREON IS A
CORRECT REPRESENTATION OF THE PROPERTY LINES TO THE
BEST OF MY KNOWLEDGE AND BELIEF.

Robert M. Baerenwald
ROBERT M. BAERENWALD
WISCONSIN REGISTERED LAND SURVEYOR, S-1508

Feb. 22, 1987
DATE JOB NO. 0932

NOTE: THIS IS NOT A CERTIFIED COPY UNLESS SEALED.

JLB-1837

217-673