


WALWORTH COUNTY  
SURVEYING & MAPPING  
LAKE GENEVA, WISCONSIN

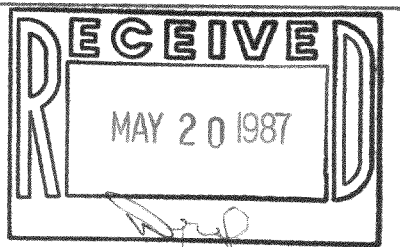

47

(N89°18'00"W 251.33')  
251.27'


89°00'30"



45

(N4°56'E 186.00')  
185.99'

111.1'

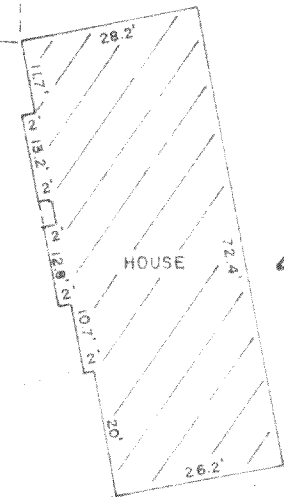

44

(175.00')

225.09'  
265.10'  
(S1°41'W)

BLACKTOP DRIVEWAY

40.04'  
(S89°46'E 40.00')

40.00'  
(90°17'30"W)  
80.00'

42

220.92'  
(S89°22'30"E 220.95')

NORTH 40' LOT 43

219.96'

43

91°03'25"

CORNER FALLS ON CONCRETE AT  
BASE OF FENCE POST

WILDWOOD DRIVE


6.0'

PLAT OF SURVEY OF

LOT 44 AND THE NORTH 40 FEET OF LOT 43 OF  
WILDWOOD SUBDIVISION, LOCATED IN SECTION  
34, T 2 N, R 17 E, WALWORTH COUNTY, WISCONSIN.

NOTE: INSERTS ARE NOT TO  
SCALE.

ORDERED BY: ASSURED REALTY  
P. O. BOX 367  
WILLIAMS BAY, WISCONSIN 53191

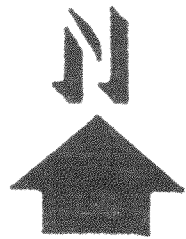

SCALE: 1"=40'

Ø - IRON PIPE FOUND  
∅ - IRON ROD FOUND  
○ - IRON ROD PLACED  
( ) - RECORDED AS

I, ROBERT M. BAERENWALD, DO HEREBY CERTIFY THAT I  
HAVE SURVEYED THE PROPERTY HEREON DESCRIBED ACCORDING  
TO THE OFFICIAL RECORDS AND THAT THE PLAT HEREON IS A  
CORRECT REPRESENTATION OF THE PROPERTY LINES TO THE  
BEST OF MY KNOWLEDGE AND BELIEF.

*Robert M. Baerenwald*  
ROBERT M. BAERENWALD

WISCONSIN REGISTERED LAND SURVEYOR, S-14008

DATE Feb. 12, 1987 JOB NO. 0913

Jws-42

217-678