


DUNHAM SURVEYING, S.C.  
SURVEYING & SUBDIVIDING  
DELAVER, WISCONSIN 53115

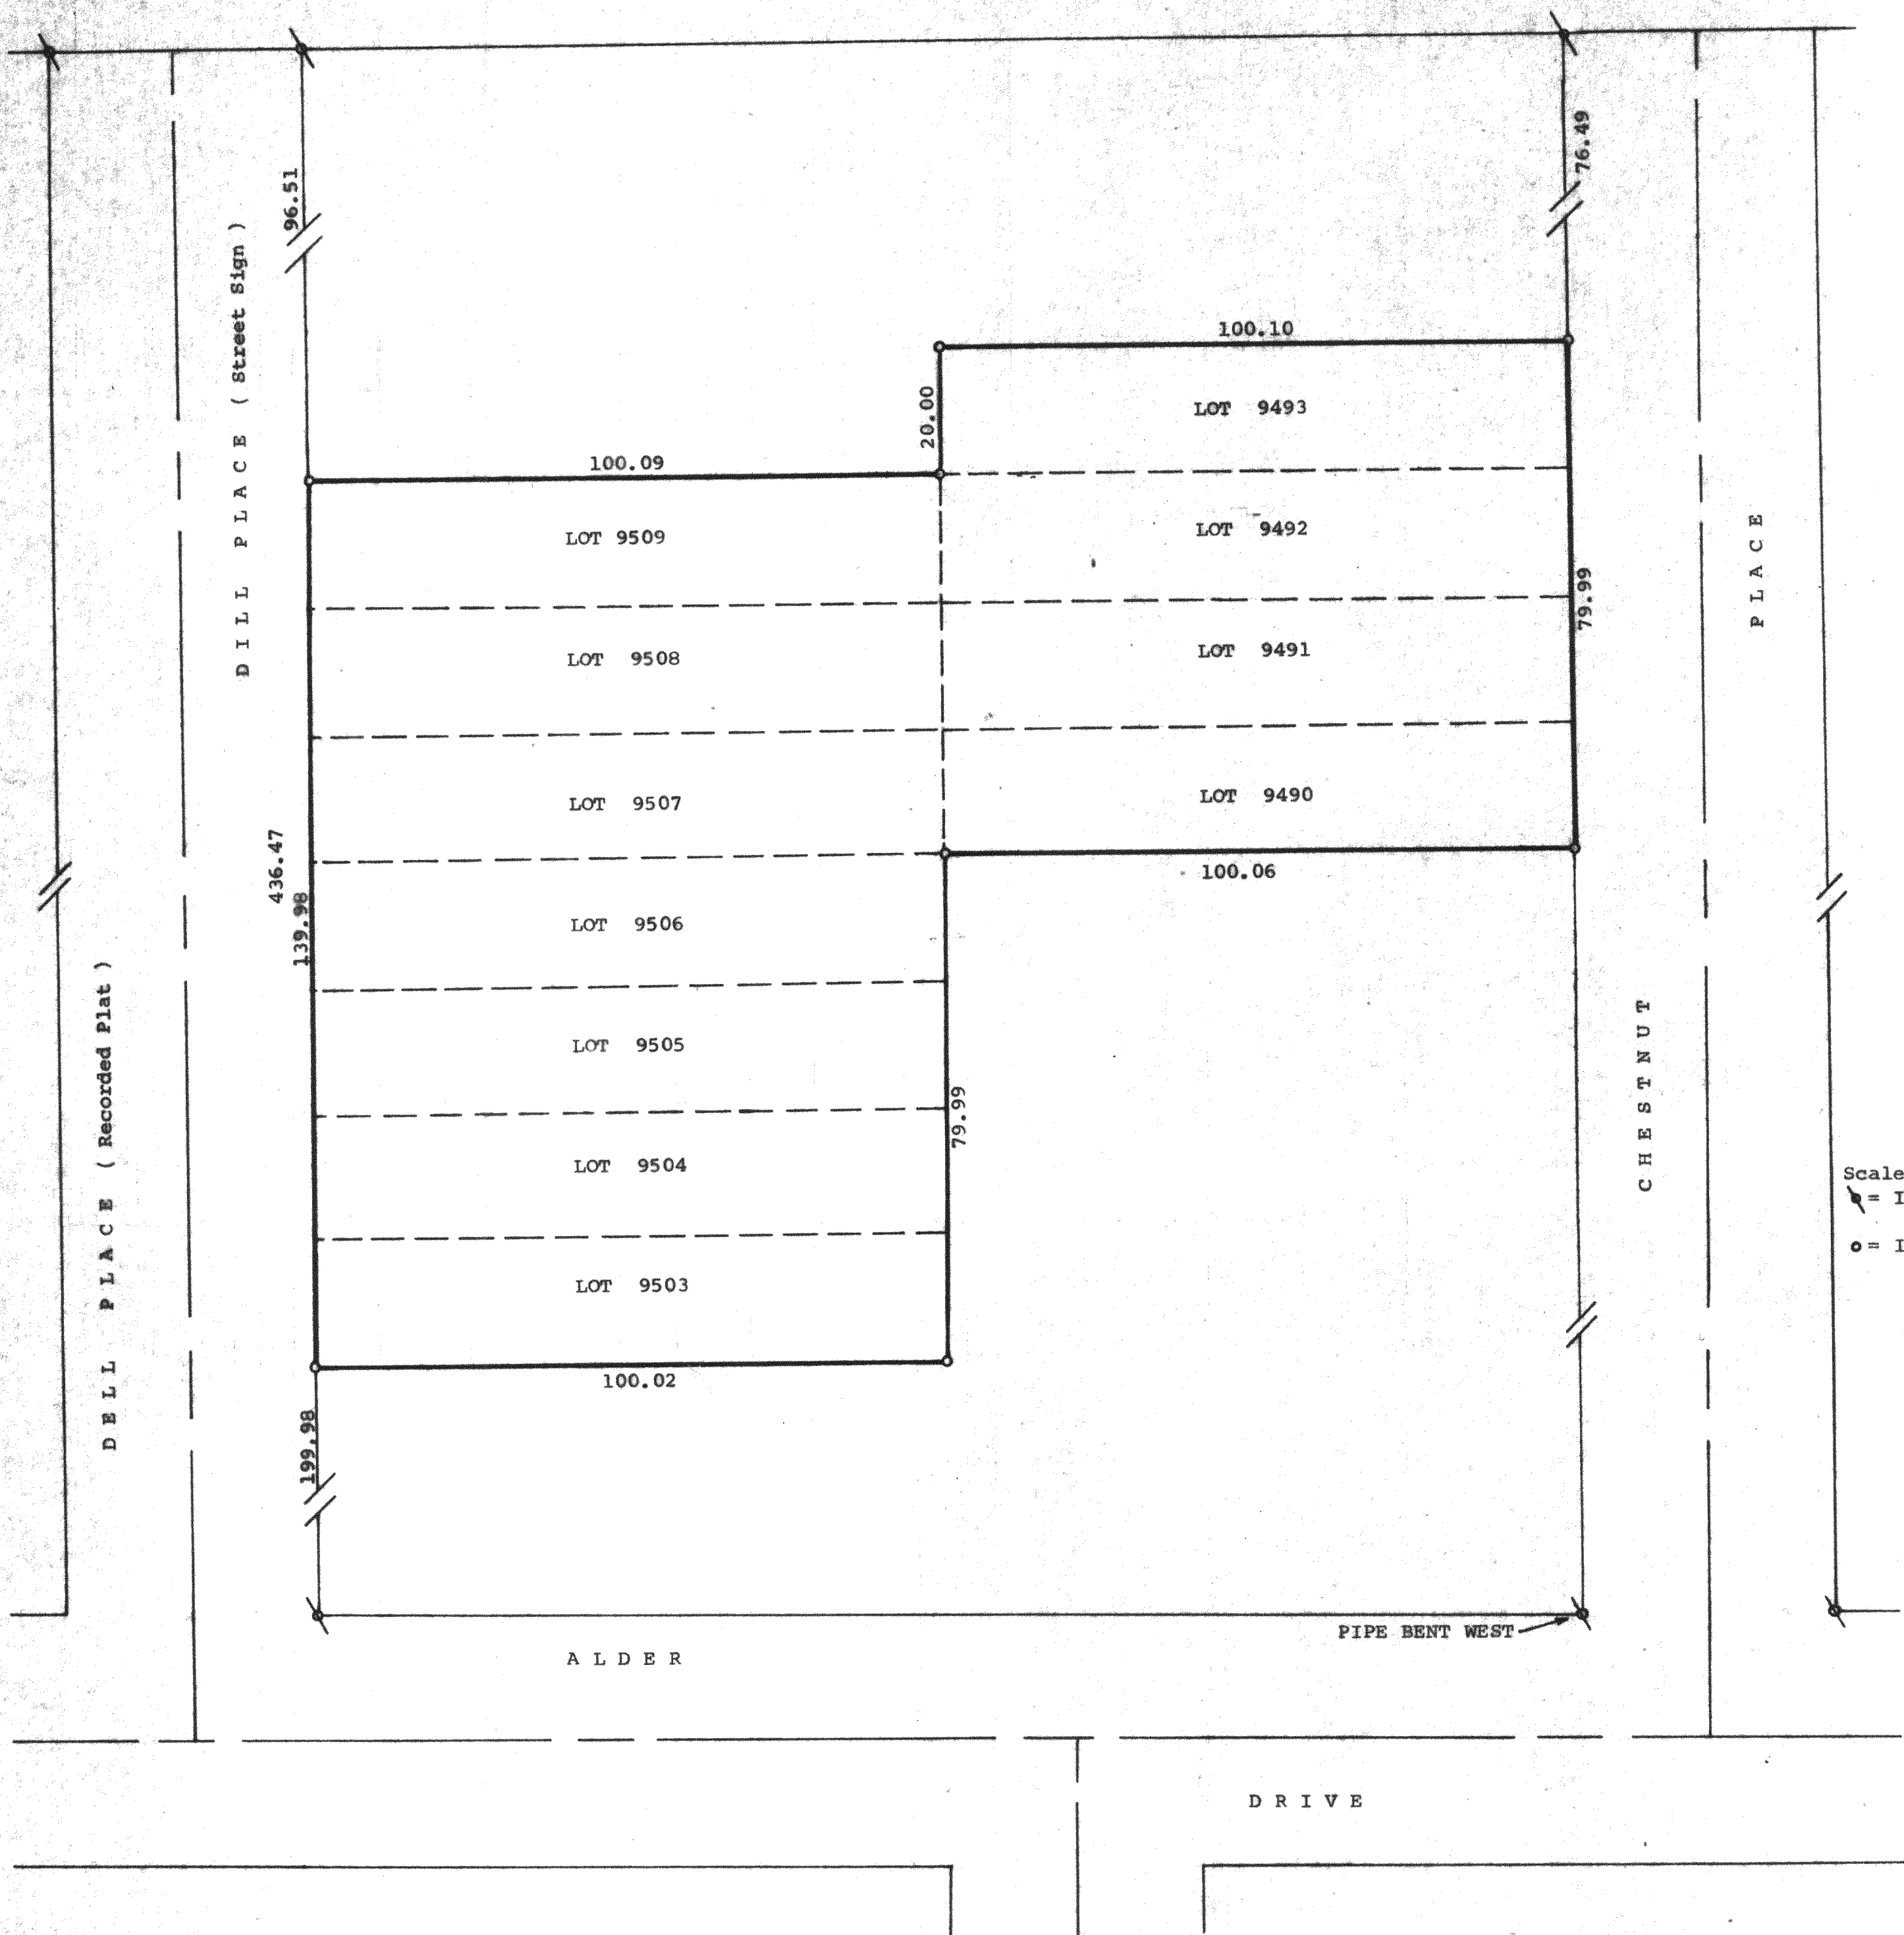

Plat of survey of:  
Lots 9503 through 9509 inclusive and Lots 9490 through 9493  
inclusive all of Block 171 in Lake Como Beach Subdivision,  
located in Section 21, T 2 N, R 17 E, Walworth County, Wisconsin.  
June 14, 1978

*George T. Dunham*  
George T. Dunham, Surveyor

