


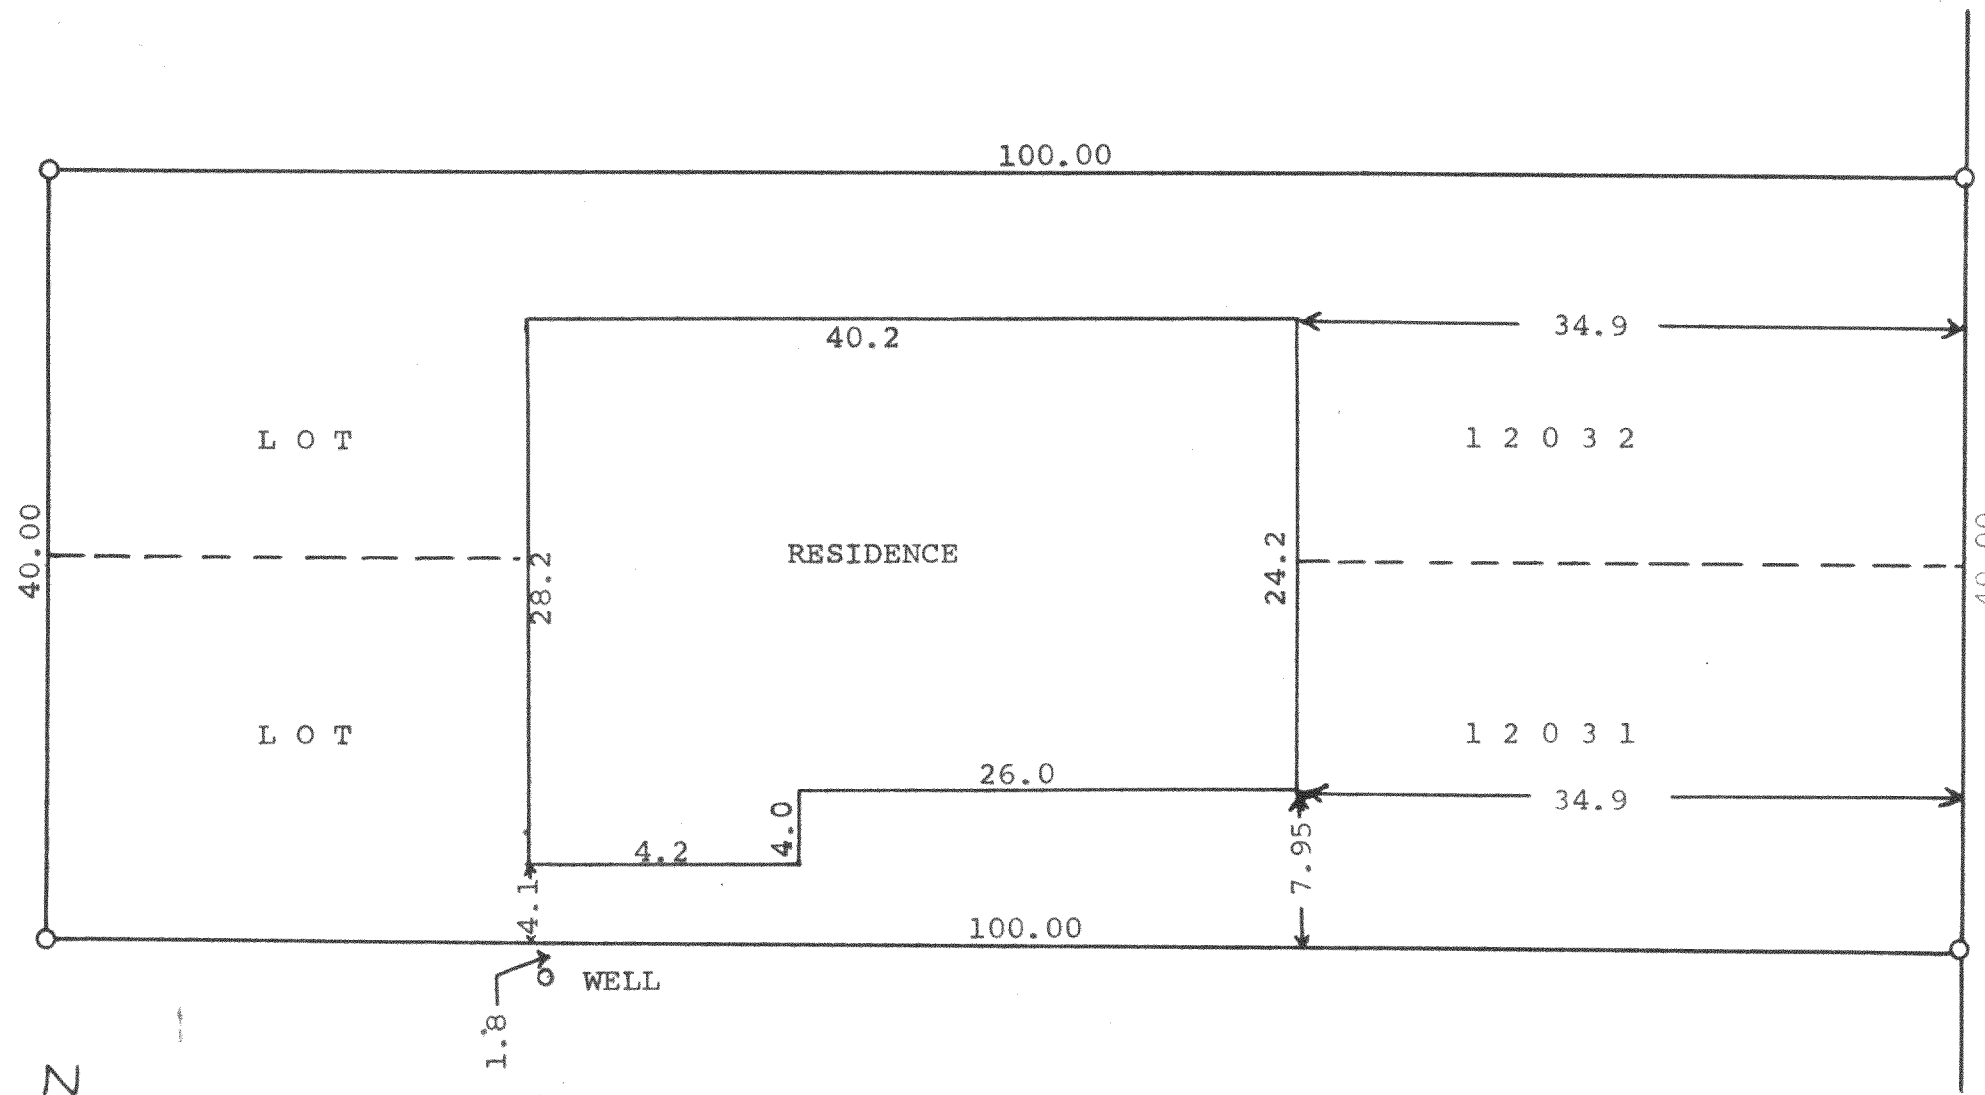

CANARY

ROAD

STATE OF WISCONSIN)
WALWORTH COUNTY,) ss

I, George T. Dunham, do hereby certify that I have surveyed the property described as follows,

Lots 12031 and 12032 of the Subdivision known as Lake Como Beach as designated and delineated on the map entitled "Fifth Map of Lake Como Beach, Walworth County, Wisconsin, recorded in the Register of Deeds Office for Walworth County, Wisconsin

and that the plat shown is a correct representation of the property lines and of the improvements located thereon.

September 14, 1962

Scale - 1" = 10'
O = Iron Pipe

5778-2617

George T. Dunham
George T. Dunham, Surveyor
Delavan, Wisconsin

217-70