



WALWORTH COUNTY
SURVEYING & MAPPING
LAKE GENEVA, WISCONSIN

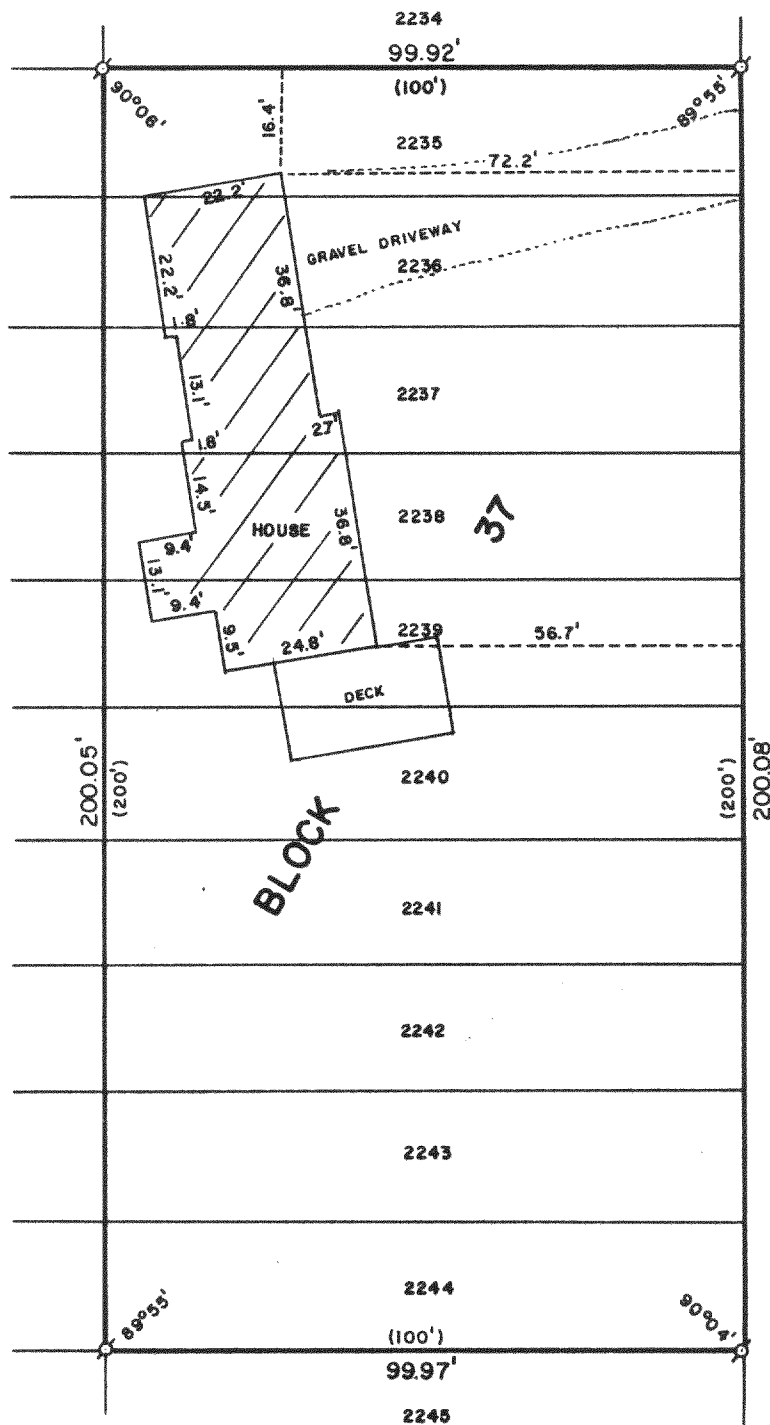

QUEEN ROAD



40' WIDE

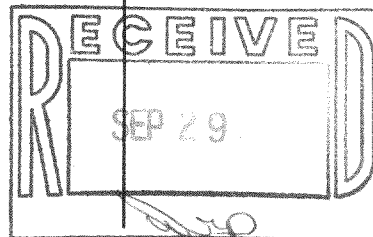

PLAT OF SURVEY OF

LOTS 2235-2244, BLOCK 37 OF LAKE COMO BEACH
SUBDIVISION, T 2 N, R 17 E, WALWORTH COUNTY,
WISCONSIN.

ORDERED BY: GARY HUMPHREY
C/O KENOSHA SAVINGS & LOAN
410 BROAD STREET
LAKE GENEVA, WISCONSIN 53147

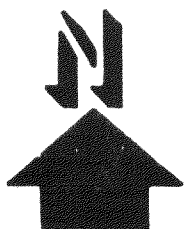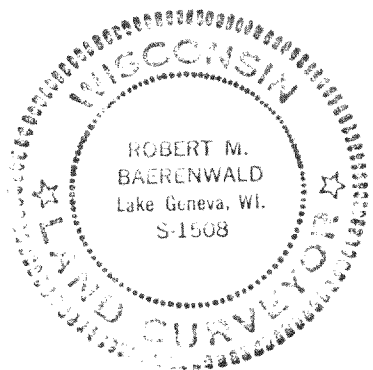

SCALE: 1"=30'

Ø-IRON PIPE FOUND
()-RECORDED AS

I, ROBERT M. BAERENWALD, DO HEREBY CERTIFY THAT I
HAVE SURVEYED THE PROPERTY HEREON DESCRIBED ACCORDING
TO THE OFFICIAL RECORDS AND THAT THE PLAT HEREON IS A
CORRECT REPRESENTATION OF THE PROPERTY LINES TO THE
BEST OF MY KNOWLEDGE AND BELIEF.

Robert M. Baerenwald
ROBERT M. BAERENWALD
WISCONSIN REGISTERED LAND SURVEYOR, S-1508

DATE *January 10, 1985*
JOB NO. 0186
REVISED DATE: AUG. 17, 1987