

WISCONSIN

DANIEL D.
COOPER

S-1464


WIS.

LAND SURVEYOR

D. D. COOPER & CO., INC.
Daniel D. Cooper
Rt. 4 Box 508B
Elkhorn, WI 53121

LINCOLN DR.

RECEIVED

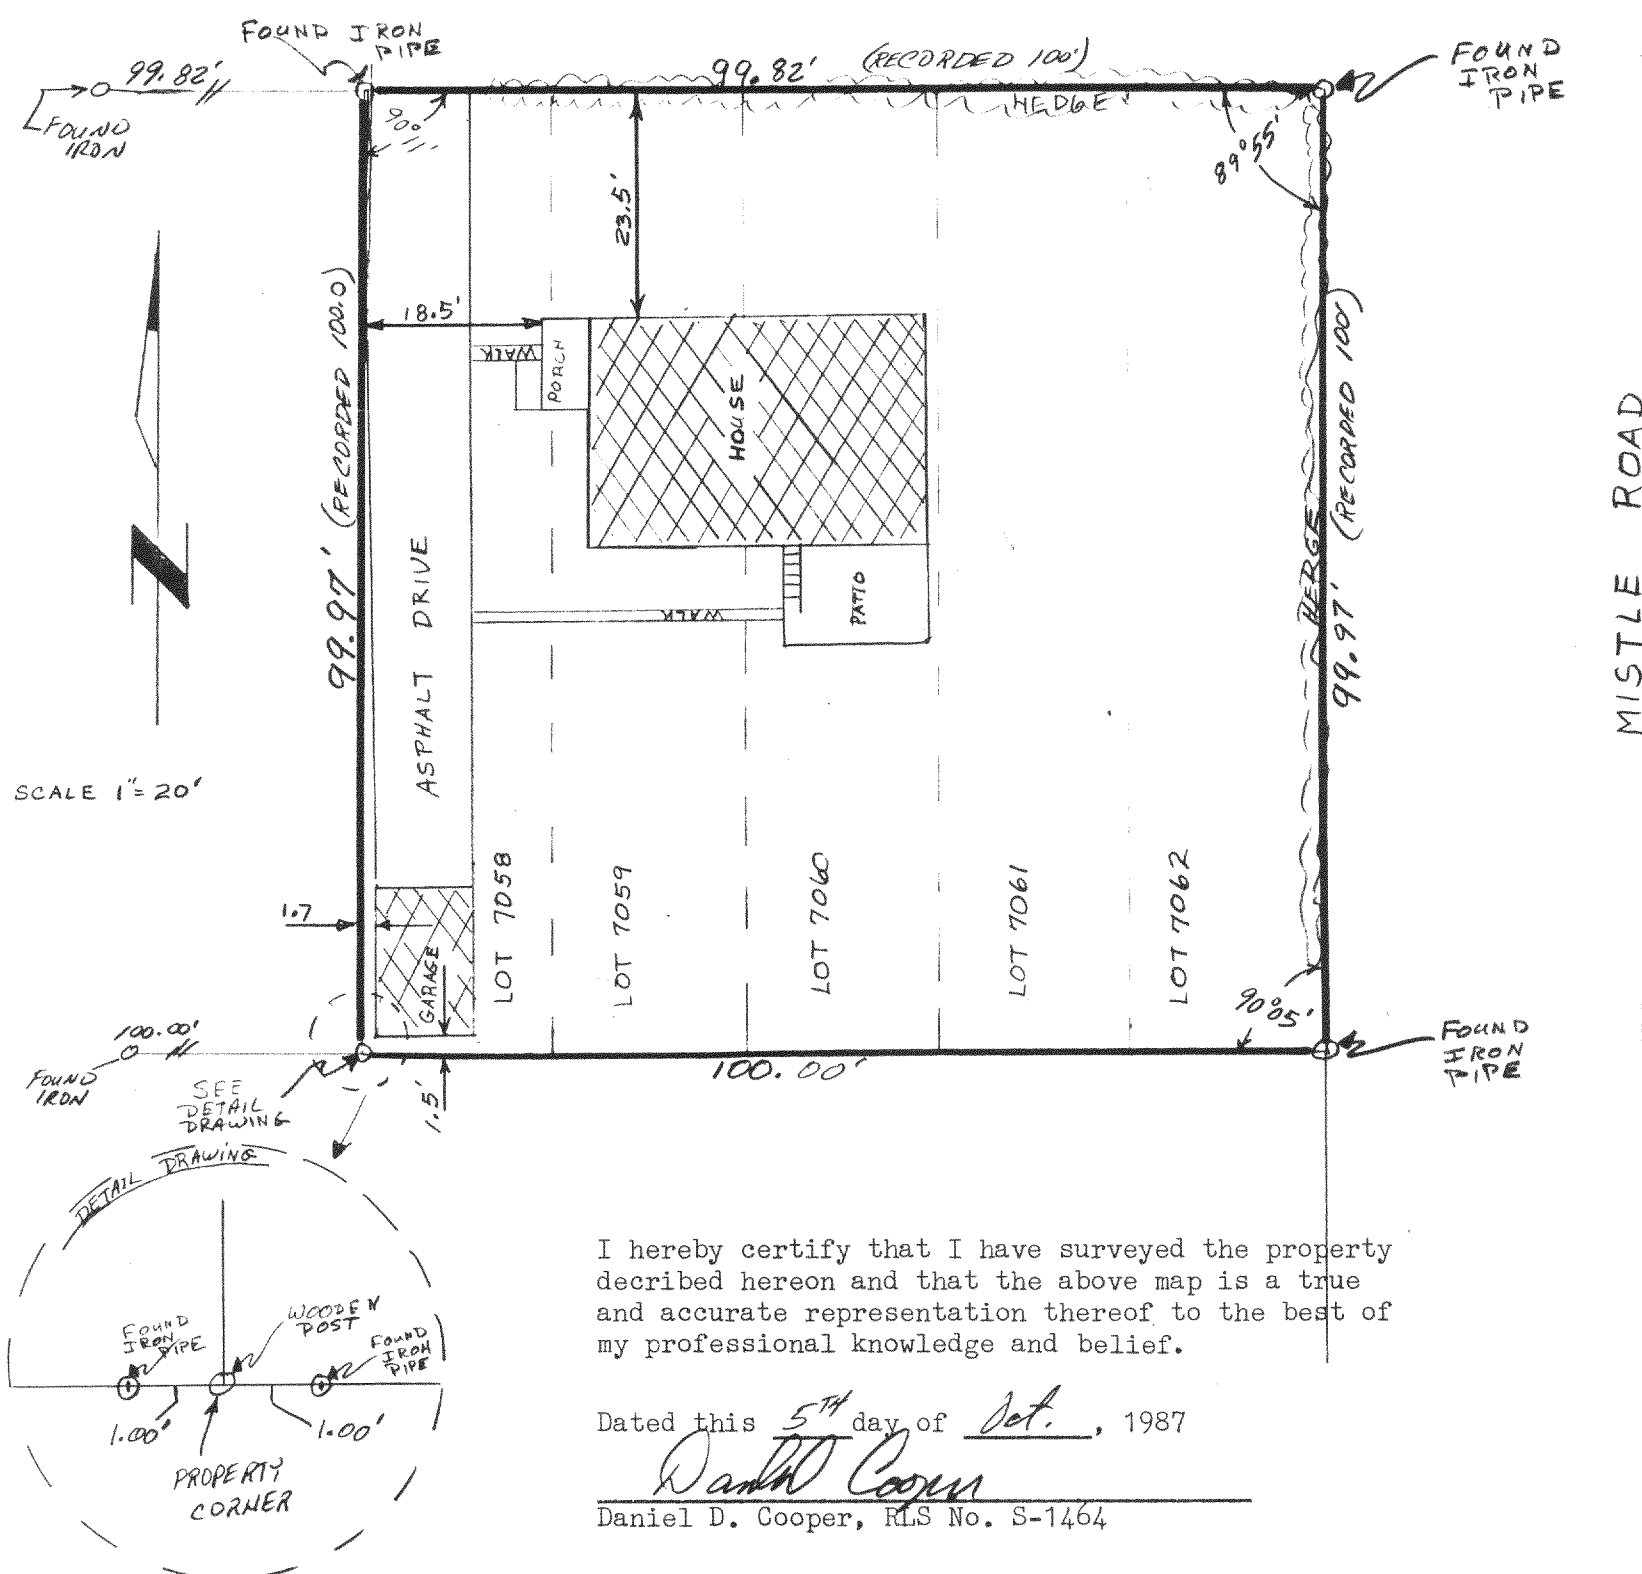

I hereby certify that I have surveyed the property described hereon and that the above map is a true and accurate representation thereof to the best of my professional knowledge and belief.

Dated this 5TH day of Oct., 1987

Daniel D. Cooper
Daniel D. Cooper, RLS No. S-1464

Drawing No. 1358-11-25

JLCB.14A3

217-727