


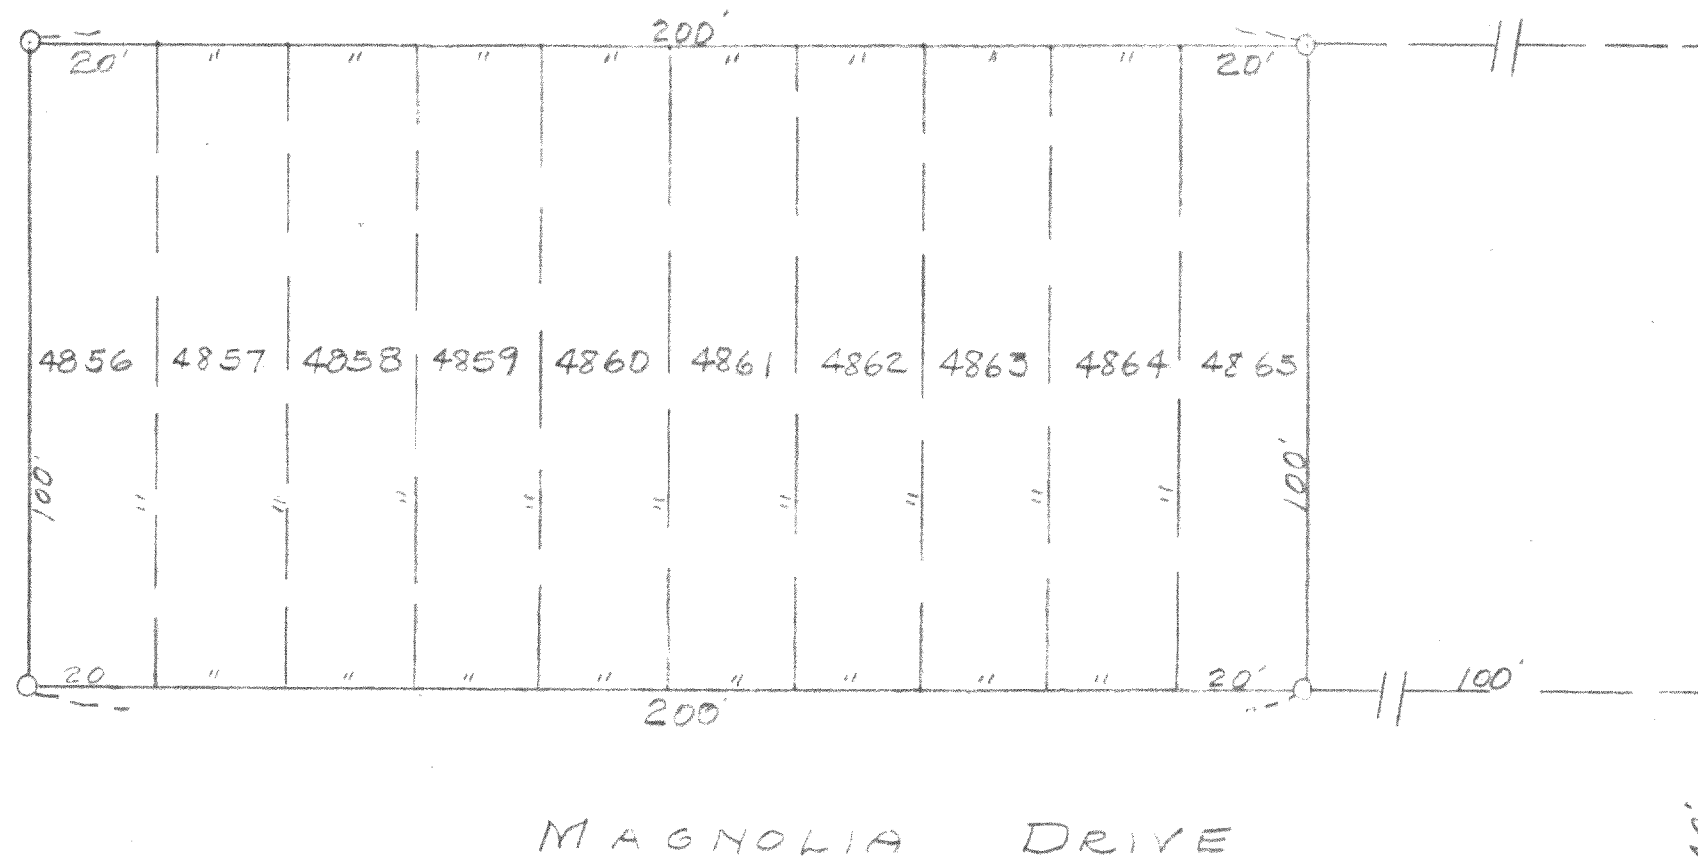

40'

0-IRON PIPE

PLAT OF SURVEY OF

LOTS 4856 TO 4865 OF LAKE
COMO BEACH SUBDIVISION,
TOWN OF GENEVA, WALWORTH
COUNTY WISCONSIN.

Lloyd L. Jensen
SURVEYOR

SCALE 1" = 30'

DATE FEB. 1957

JLCB-966

217-74.1