



Rural - Residential - Commercial

Route 3, Box 255 :: Elkhorn, Wisconsin 53121

Phone (414) 723-6265

SURVEYING & PLANNING
SUBDIVISIONS - LOT SURVEYS
CONSTRUCTION STAKING - MAPPING


Survey of Lots 1114-1118, Lake Como Beach
Subdivision, T2N, R17E, Walworth County Wisconsin.

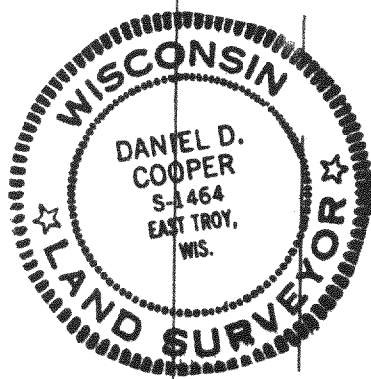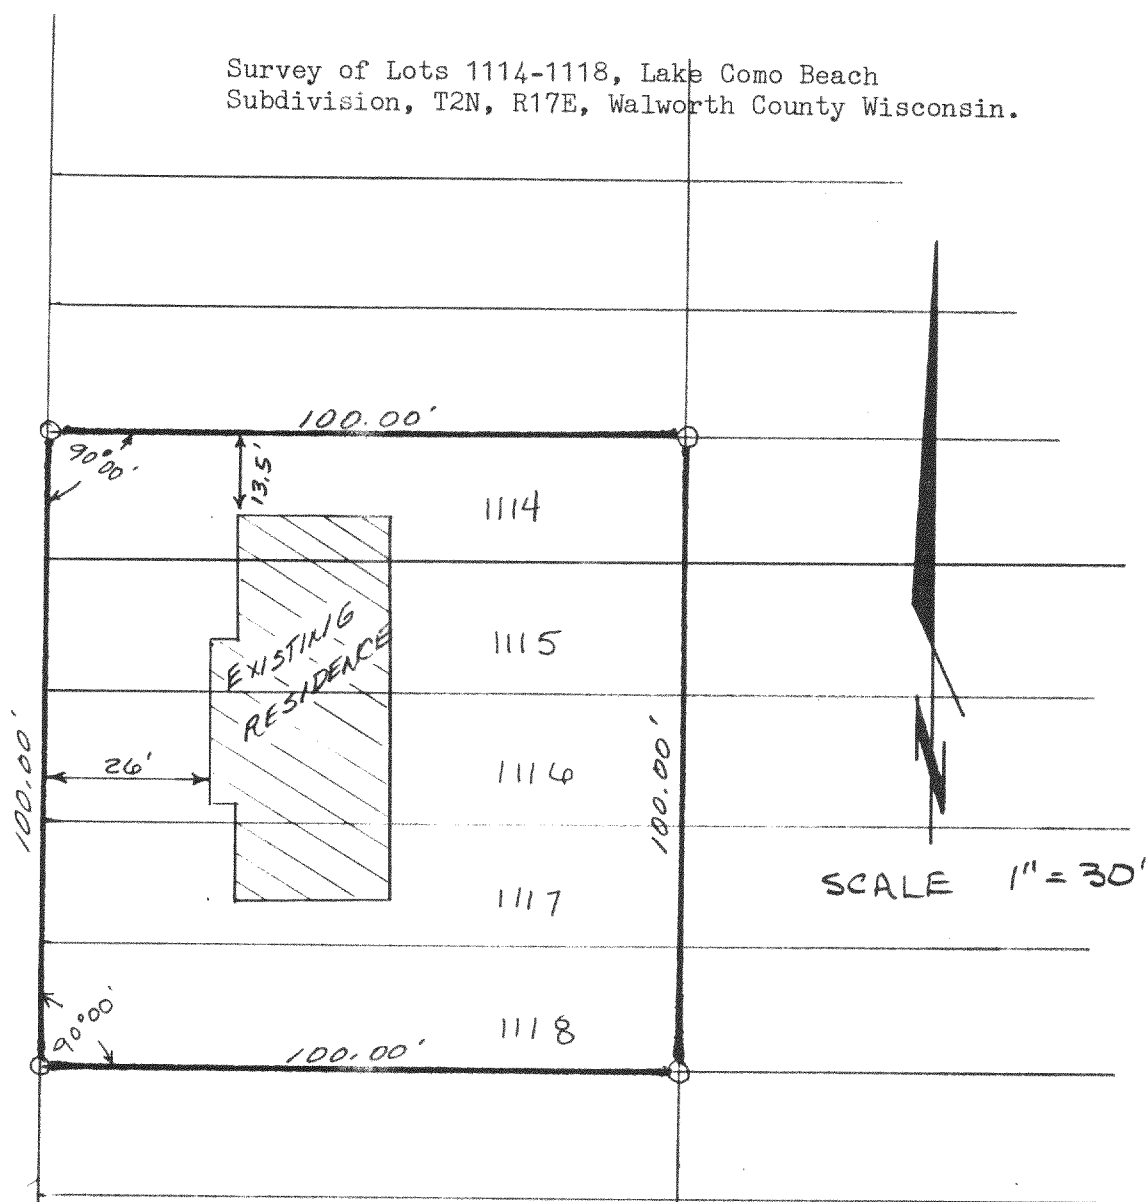

I hereby certify that I have surveyed the property described hereon and that the above map is a true ~~and accurate representation~~ thereof to the best of my professional knowledge and belief.

Dated this 12 day of Sept, 1983

Daniel D. Cooper, RLS No. s-1464

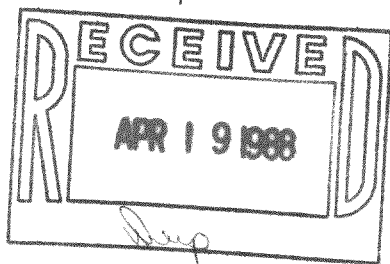

1865

317-748