
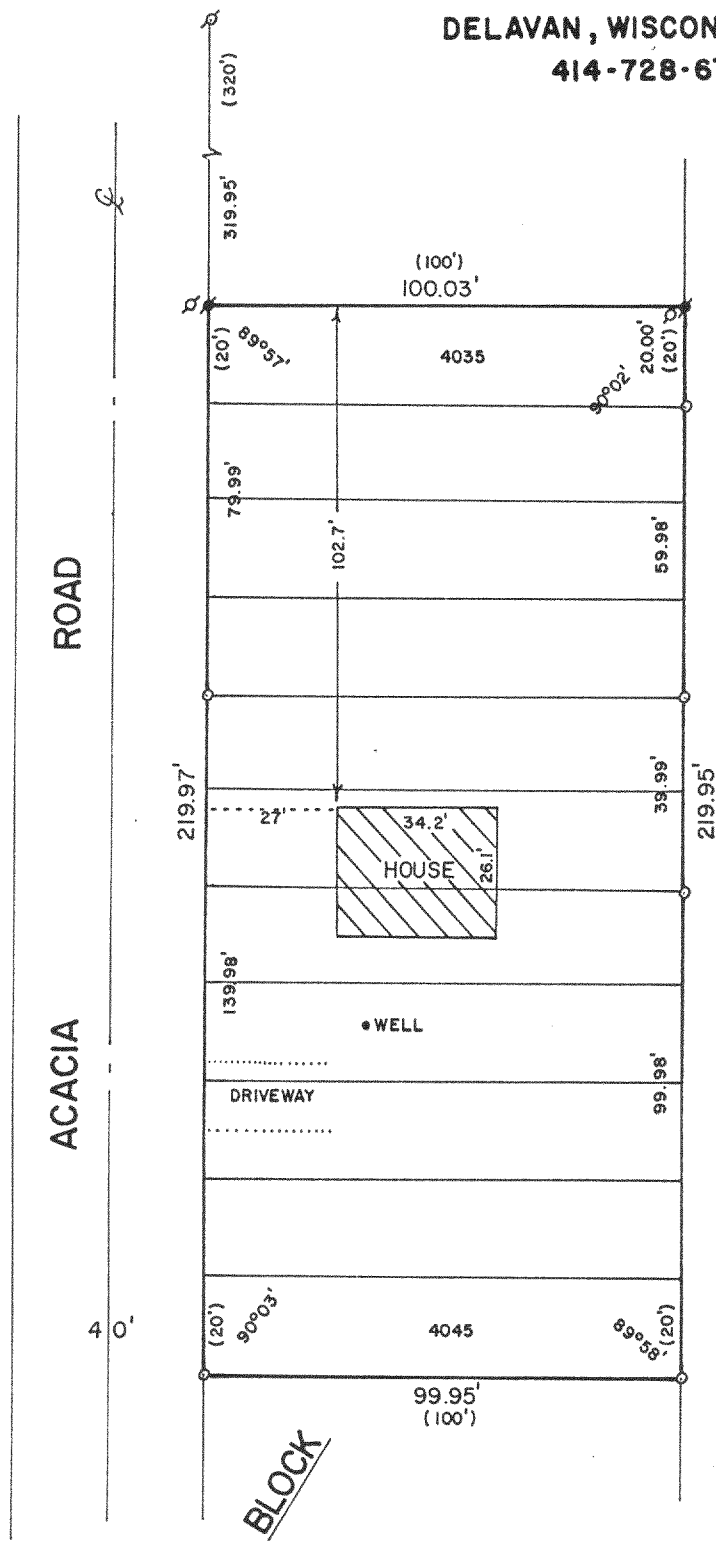


ABELL
SURVEYING & MAPPING
DELAVAN, WISCONSIN 53115
414-728-6737

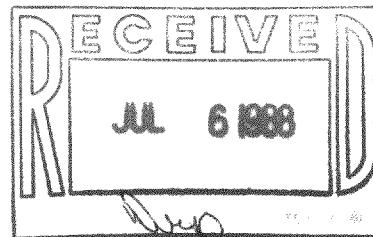

69

PLAT OF SURVEY OF

LOTS 4035-4045, BLOCK 69, LAKE
COMO BEACH SUBDIVISION, T2N,
R17E, WALWORTH COUNTY, WISCONSIN

ORDERED BY: CENTURY 21 - GENEVA
LAKE
503 CENTER ST.
LAKE GENEVA, WI.
53147



SCALE - 1"=40'

LEGEND

- ⊗ - IRON PIPE FOUND
- ⊙ - IRON ROD FOUND
- - IRON ROD SET
- () - RECORDED AS

I, DAVID F. ABELL, DO HEREBY CERTIFY
THAT I HAVE SURVEYED THE PROPERTY
HEREON DESCRIBED ACCORDING TO THE
OFFICIAL RECORDS AND THAT THE PLAT
HEREON IS A CORRECT REPRESENTATION
OF THE PROPERTY LINES TO THE BEST OF
MY KNOWLEDGE AND BELIEF.

David F. Abell

DAVID F. ABELL
WISCONSIN REGISTERED LAND SURVEYOR, S-1596

May 11, 1988

DATE JOB NUMBER - 88030

NOTE: THIS IS NOT A CERTIFIED COPY UNLESS SEALED.

JLC6774-110

217-113