


GEORGE T. DUNHAM
SURVEYING & SUBDIVIDING
DELAVER, WISCONSIN

N



Scale - 1" = 30'

○ = Iron Pipe

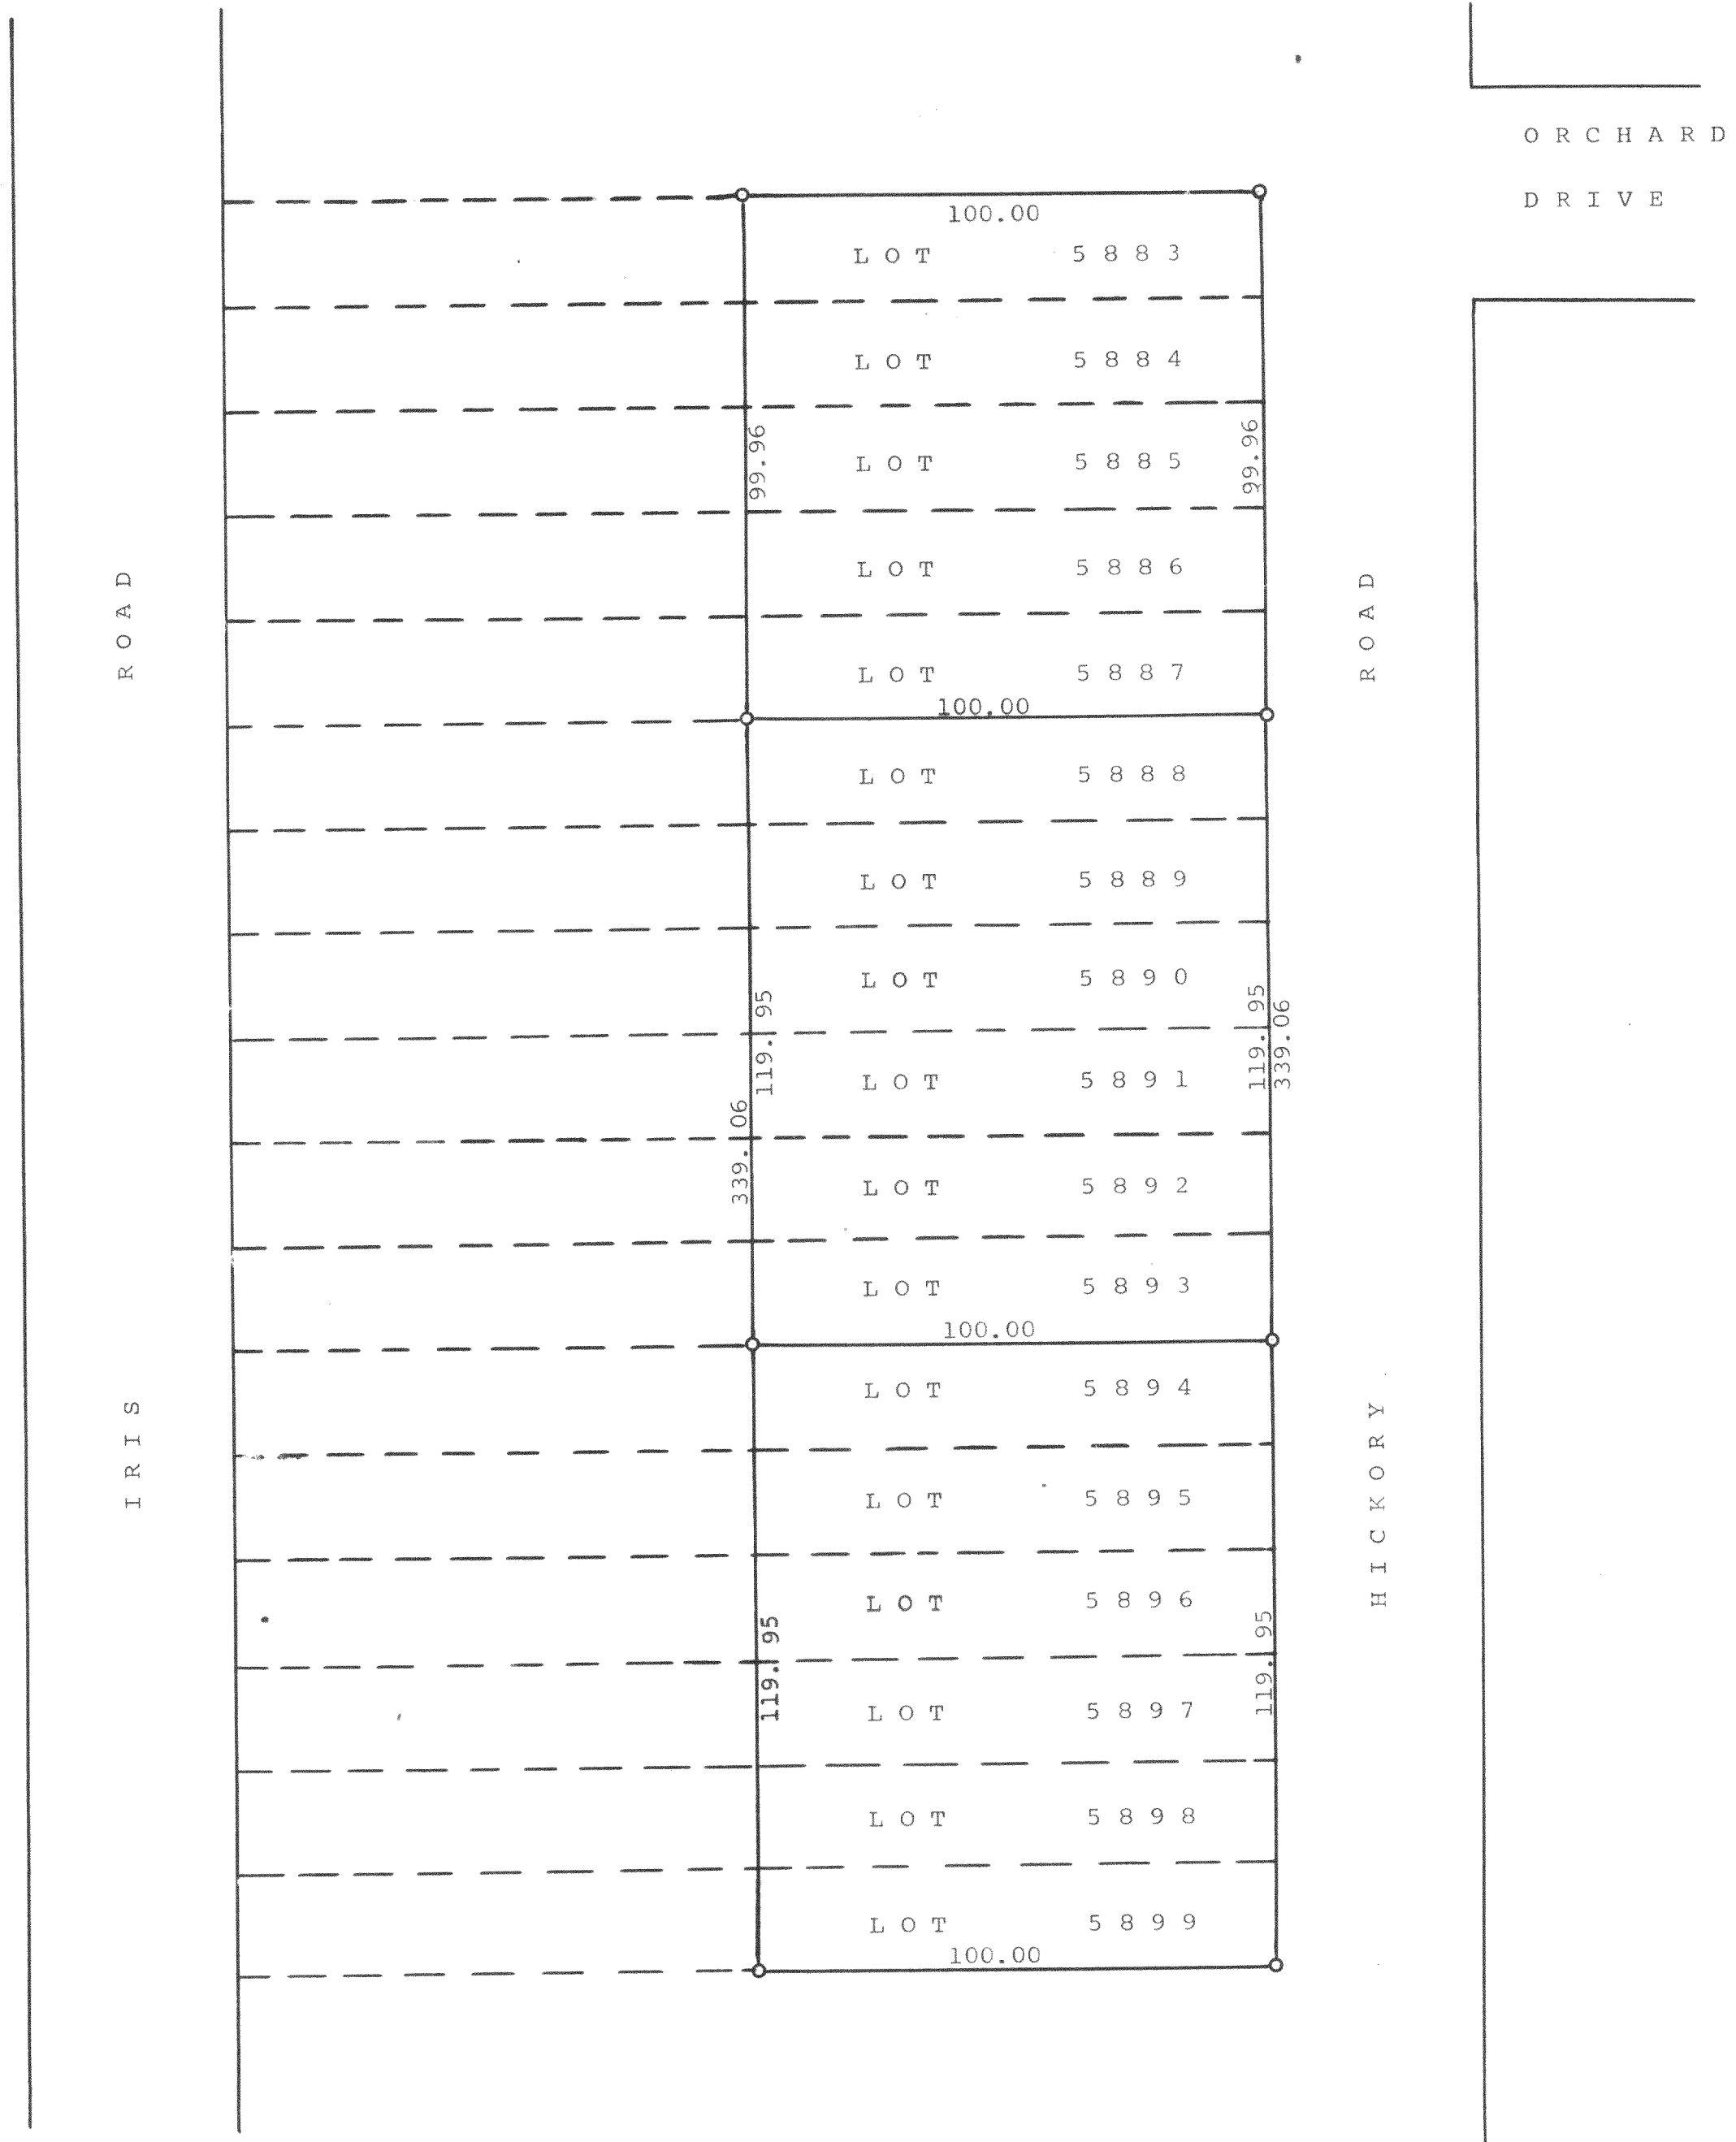

Plat of survey of Lots 5883 - 5899, Lake Como Subdivision, Town of Geneva,
T 2 N R 17 E, Walworth County, Wisconsin.
July 22, 1964

George T. Dunham
George T. Dunham, Surveyor

JLCB-1204