


GEORGE T. DUNHAM
SURVEYING & SUBDIVIDING
DELAVER, WISCONSIN



Scale - 1" = 10'
○ = Iron Pipe

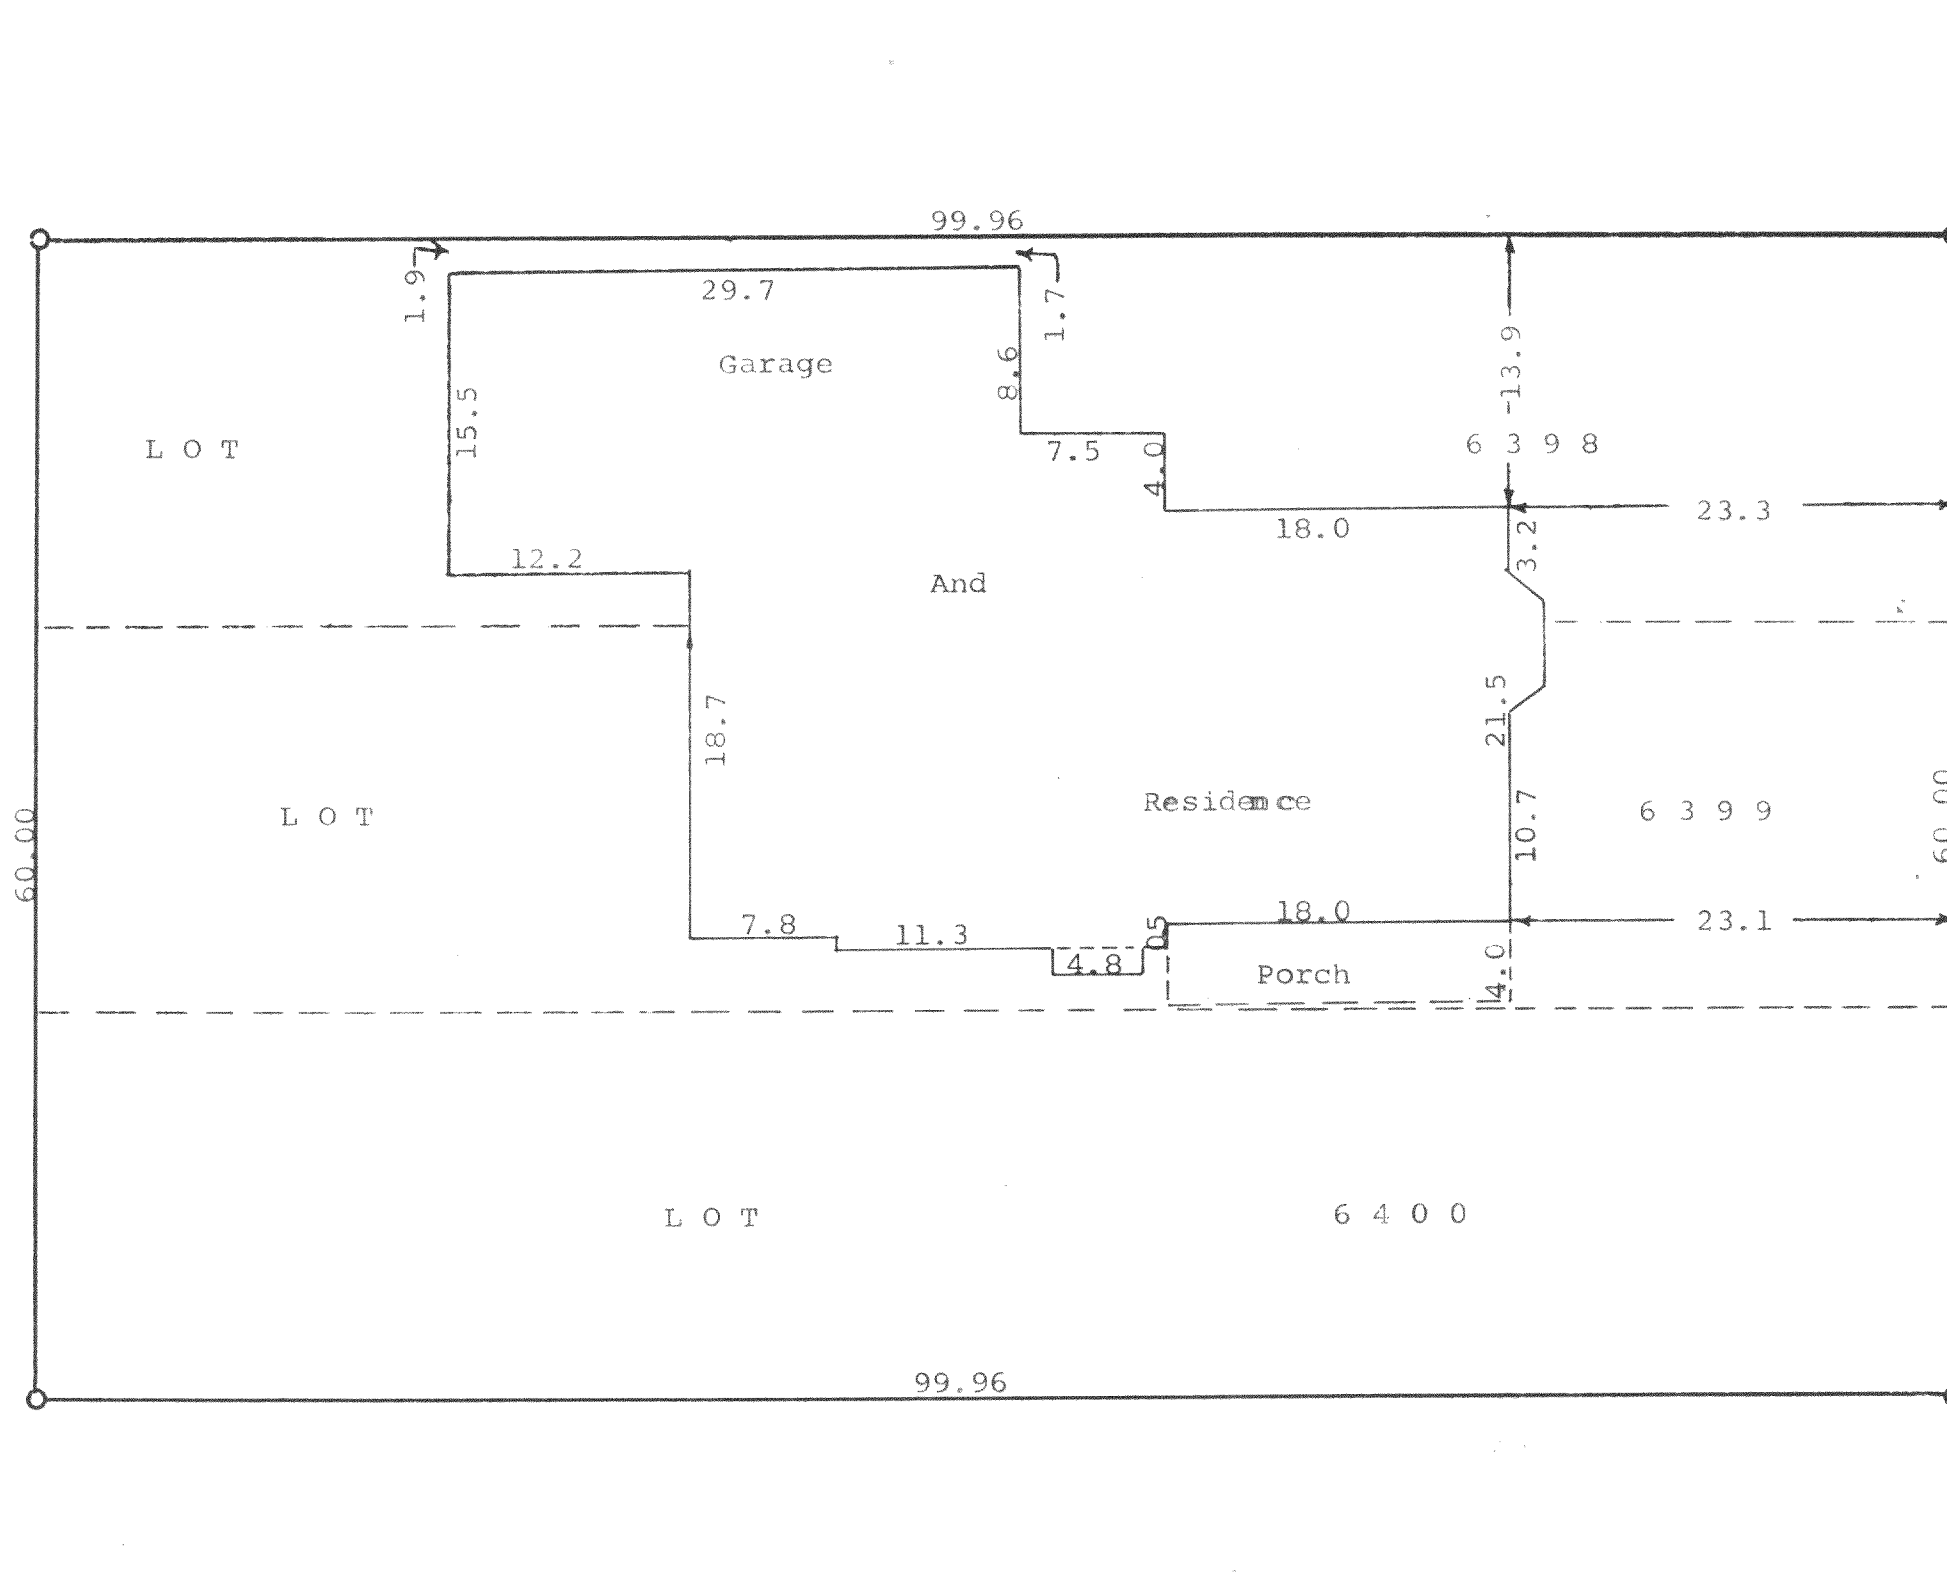

ROAD

JUTE

STATE OF WISCONSIN)
WALWORTH COUNTY) SS
I, George T. Dunham, surveyor, do certify that I have surveyed
the property described as follows,
Lots 6398, 6399, and 6400 in Lake Como Beach, a subdivision
located in the Town of Geneva, Walworth County, Wisconsin
and the above plat is an accurate survey and a true representation
thereof and correctly shows the exterior boundary lines and location
of buildings and the correct measurements thereof.
August 20, 1964

George T. Dunham
George T. Dunham, Surveyor

JLCB-1327