



PROJ 5113 10/05/88 COORDINATES
POINT DESCRIBED NORTH EAST

101 SN	500.07	499.997
101 FP	499.91	470.537
102 FP	499.91	370.537
103 FP	499.91	370.327
104 FP	359.92	370.407
105 FP	359.92	470.387
600 SET ROD	459.92	470.487
700 RES COR	513.96	451.777
701 RES COR	514.13	430.717
702 RES COR	484.85	465.107
703 RES COR	484.85	454.547
704 SHED	502.78	370.477
705 SHED	473.76	401.077
706 SHED	464.55	401.047
707 SHED	501.47	392.667

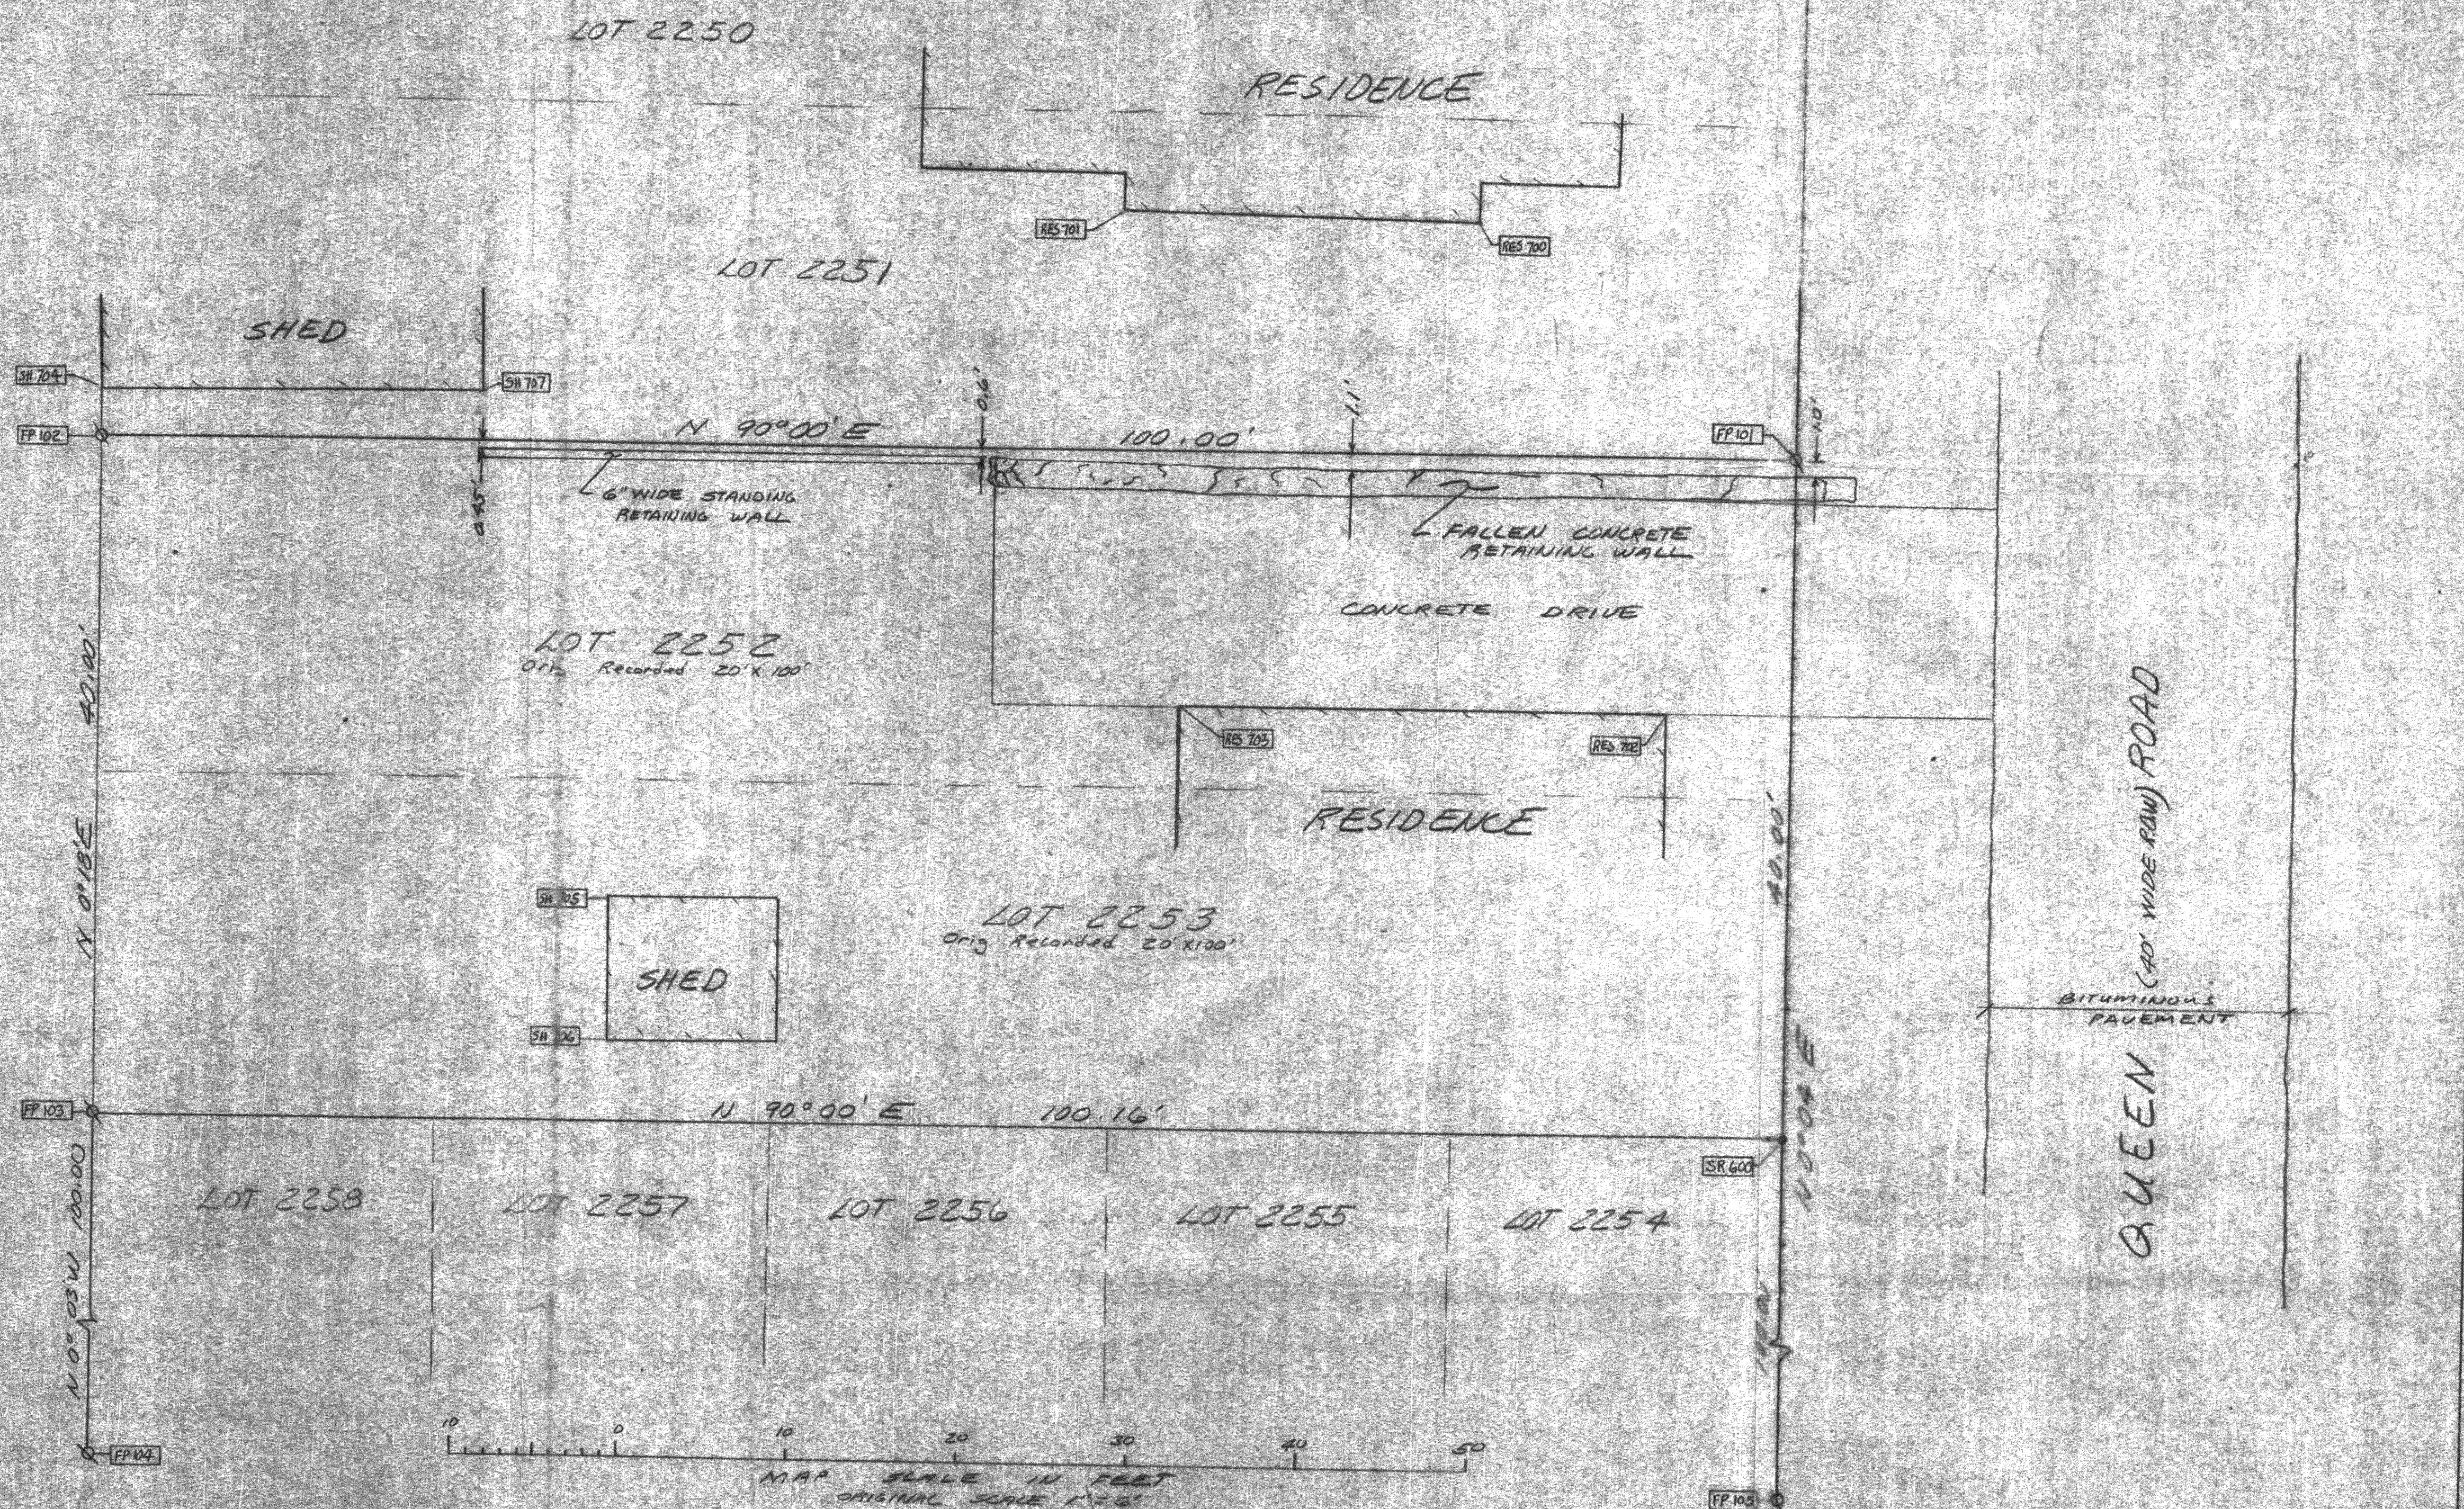

PLAT OF SURVEY OF THE BOUNDARY OF LOTS
2252 & 2253 OF LAKE COMO BEACH SUBDIVISION AND
OF THE LOCATION OF A RETAINING WALL ALONG THE
NORTH LINE OF LOT 2252 FOR MITCH WALKUP
PARCEL LOCATED IN TOWN OF GENEVA, WALWORTH CO., WI.

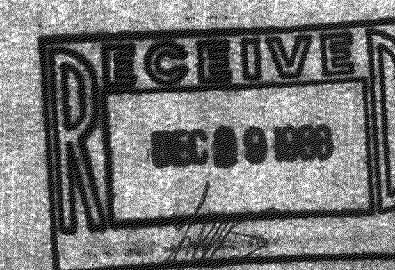

FARRIS, HANSEN & ASSOCIATES, INC.
Engineers, Architects, Surveyors
7 Ridgeway Court P.O. Box 457
ELKHORN, WISCONSIN 53121
Office: (414) 723-2058

PROJECT # 3113
OCT. 5, 1988