

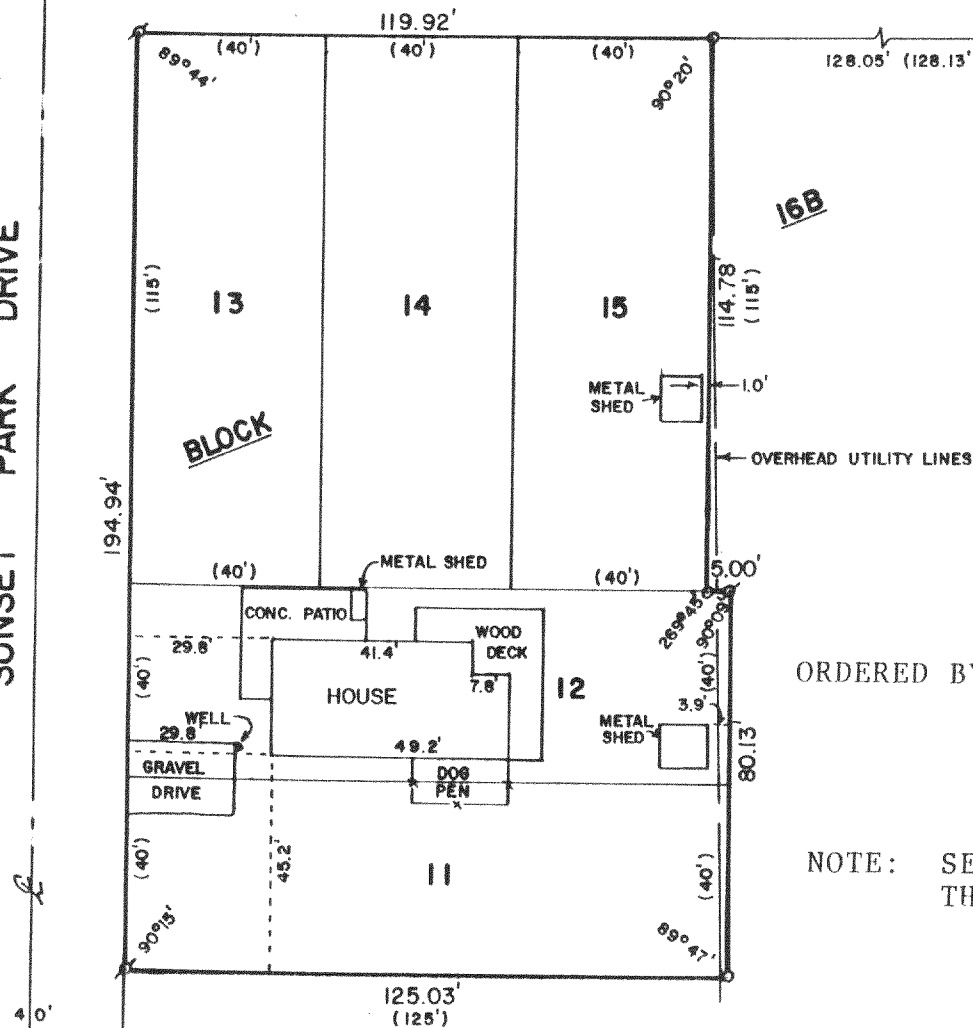


SUNSET PARK DRIVE

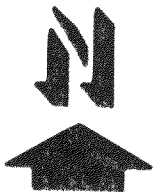

NOTE: SEPTIC TANK IS UNDER
THE WOOD DECK.

LOTS 11-15, BLOCK 16B, SUNSET HILLS, LOCATED
IN T2N,R17E, WALWORTH COUNTY, WISCONSIN.

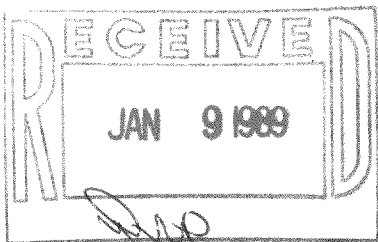

LEGEND

- I HEREBY CERTIFY THAT I HAVE SURVEYED THE ABOVE DESCRIBED PROPERTY AND THAT THE ABOVE MAP IS A TRUE REPRESENTATION THEREOF AND SHOWS THE SIZE AND LOCATION OF THE PROPERTY, ITS EXTERIOR BOUNDARIES, THE LOCATION OF ALL VISIBLE STRUCTURES AND DIMENSIONS OF ALL PRINCIPAL BUILDINGS THEREON, BOUNDARY FENCES, APPARENT EASEMENTS, ROADWAYS AND VISIBLE ENCROACHMENTS, IF ANY, TO THE BEST OF MY KNOWLEDGE AND BELIEF.

David F. Abell

DATE Sept. 22, 1988

DATE 7-22-68 JOB NUMBER - 88214

NOTE: THIS IS NOT A CERTIFIED COPY UNLESS SEALED.