

PLAT OF SURVEY
of
LOTS 12, 13, 14, 15, BLOCK 14, SUNSET HILLS SUBDIVISION
SECTION 32, TOWN OF GENEVA, COUNTY OF WALWORTH, IN THE
STATE OF WISCONSIN.

SURVEYED FOR: WANDA GOLAN
2826 W. LUNDT
CHICAGO ILL. 60645



SURVEYED BY: JENSEN SURVEYING & MAPPING S.C.
25 SOUTH WISCONSIN STREET
P.O. BOX 322
ELKHORN, WISCONSIN. 53121

LEGEND

- o FOUND IRON PIPE
- FOUND POSEY PIN
- o SET 3/4 ROD
- FOUND POSEY PIN
- o RESET 3/4 ROD

MAPPING DATE: OCTOBER, 20, 1988

BEARINGS REFERENCED TO THE WEST LINE OF
LAKEVIEW DRIVE ASSUMED TO BEAR NORTH

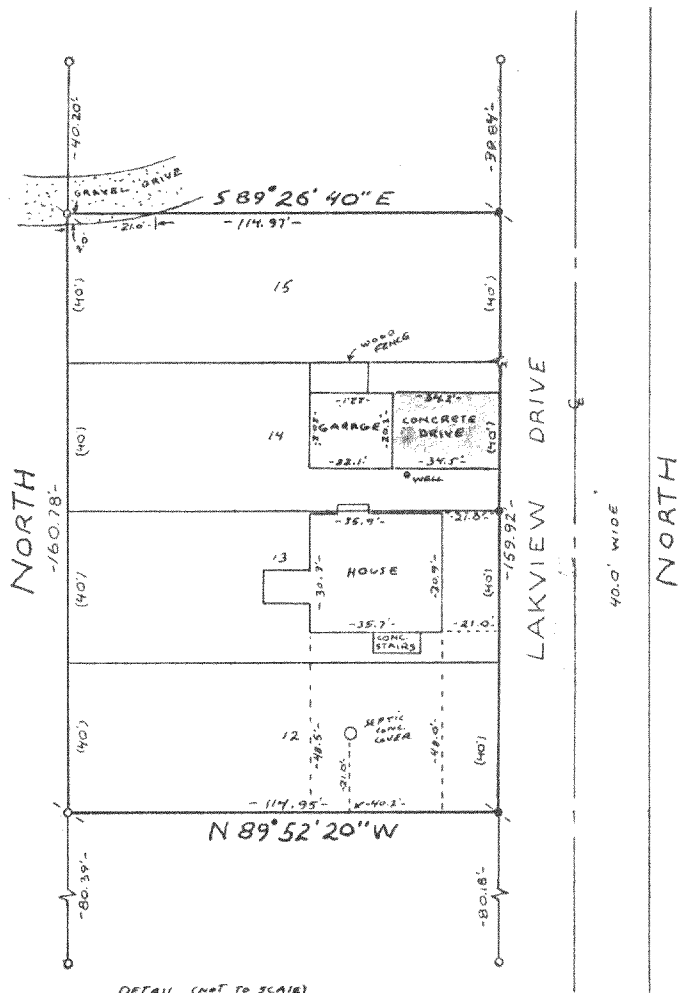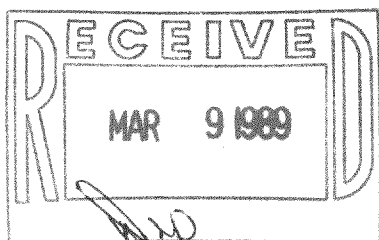

Copyright © 1988 by Jensen Surveying & Mapping S.C.

All rights reserved. No part of this survey plat may be reproduced or transmitted in any form by any means - graphic, electronic, or mechanical, including photocopying, tracing, or information storage and retrieval systems - without permission in writing from Thomas P.A. Jensen, Jensen Surveying & Mapping S.C.

I, Thomas P.A. Jensen, Wisconsin Registered Land Surveyor, do hereby certify that this survey was performed by me, or under my direction, in full compliance with the owner's/agent's instructions and Chapter A-E 5 of the Wisconsin Administrative Code "Minimum Standards For Property Surveys"; and that this map is an accurate representation thereof to the best of my knowledge and belief.

Note: This survey plat is not certified unless signed and sealed in red ink.

Thomas P.A. Jensen R.L.S-1084
Jensen Surveying & Mapping S.C.

JSH-18

217-810

1988.112

