


1812-1813 and 1814-1815 Block 29 of Lake Como Beach  
Municipality, T 2 N, R 17 E, Walworth County, Wisconsin

Jensen Surveying & Mapping S.C.  
45 S. Wisconsin St. P.O. Box 322  
Elkhorn, Wisconsin. 53121  
(414) 723-3434

ORDERED BY:  
Pear Realty, Inc.  
111 S. Pine  
P.O. Box F  
Burlington, WI  
53105

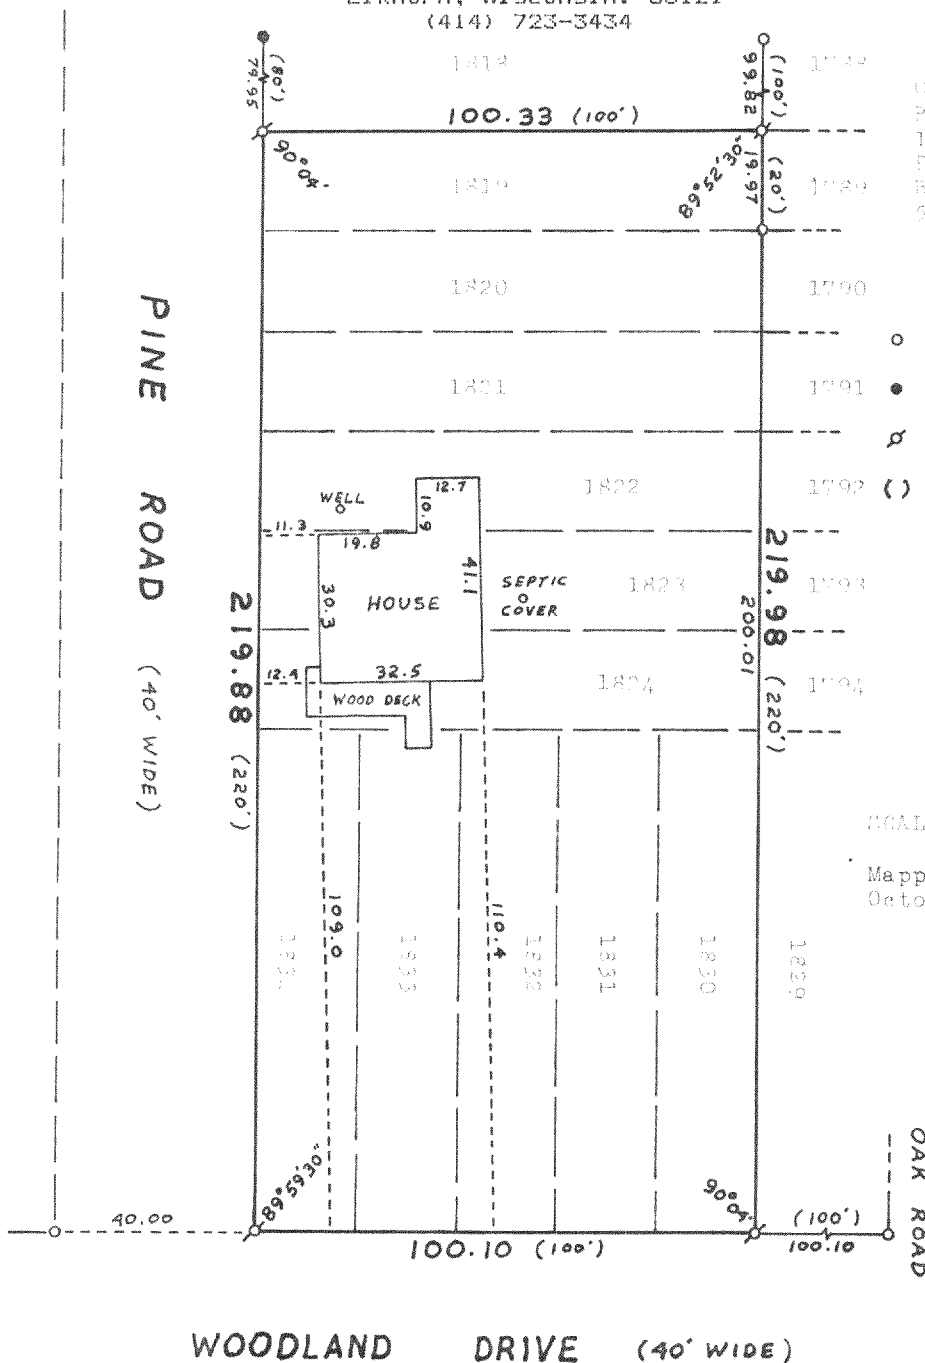


# LEGEND

- Found iron pipe
- Found iron rod
- ⊗ Set Iron pipe
- ( ) Recorded dimension



SCALE: 1" = 40'

Mapping Date:  
October 27, 1988

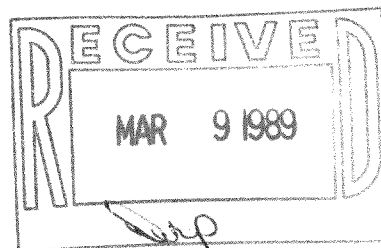

Copyright © 1988 by Jensen Surveying & Mapping S.C.

All rights reserved. No part of this survey plat may be reproduced or transmitted in any form by any means - graphic, electronic, or mechanical, including photocopying, tracing, or information storage and retrieval systems - without permission in writing from Thomas P.A. Jensen, Jensen Surveying & Mapping S.C.

Note: This survey plat is not certified unless signed and sealed in red ink.

3168 826

I, Thomas P.A. Jensen, Wisconsin Registered Land Surveyor, do hereby certify that this survey was performed by me, or under my direction, in full compliance with the owner's/agent's instructions and Chapter A-E 5 of the Wisconsin Administrative Code "Minimum Standards For Property Surveys"; and that this map is an accurate representation thereof to the best of my knowledge and belief.

*Thomas P.A. Jensen*  
Thomas P.A. Jensen R.L.S-1084  
Jensen Surveying & Mapping S.C.

217-822

1988.115

