



PLAT OF SURVEY OF LOTS 6225, 6226, 6227, 6228, & 6229 OF BLOCK 108, OF LAKE COMO BEACH,
A SUBDIVISION LOCATED IN TOWN 2 NORTH, RANGE 17 EAST, WALWORTH COUNTY, WISCONSIN

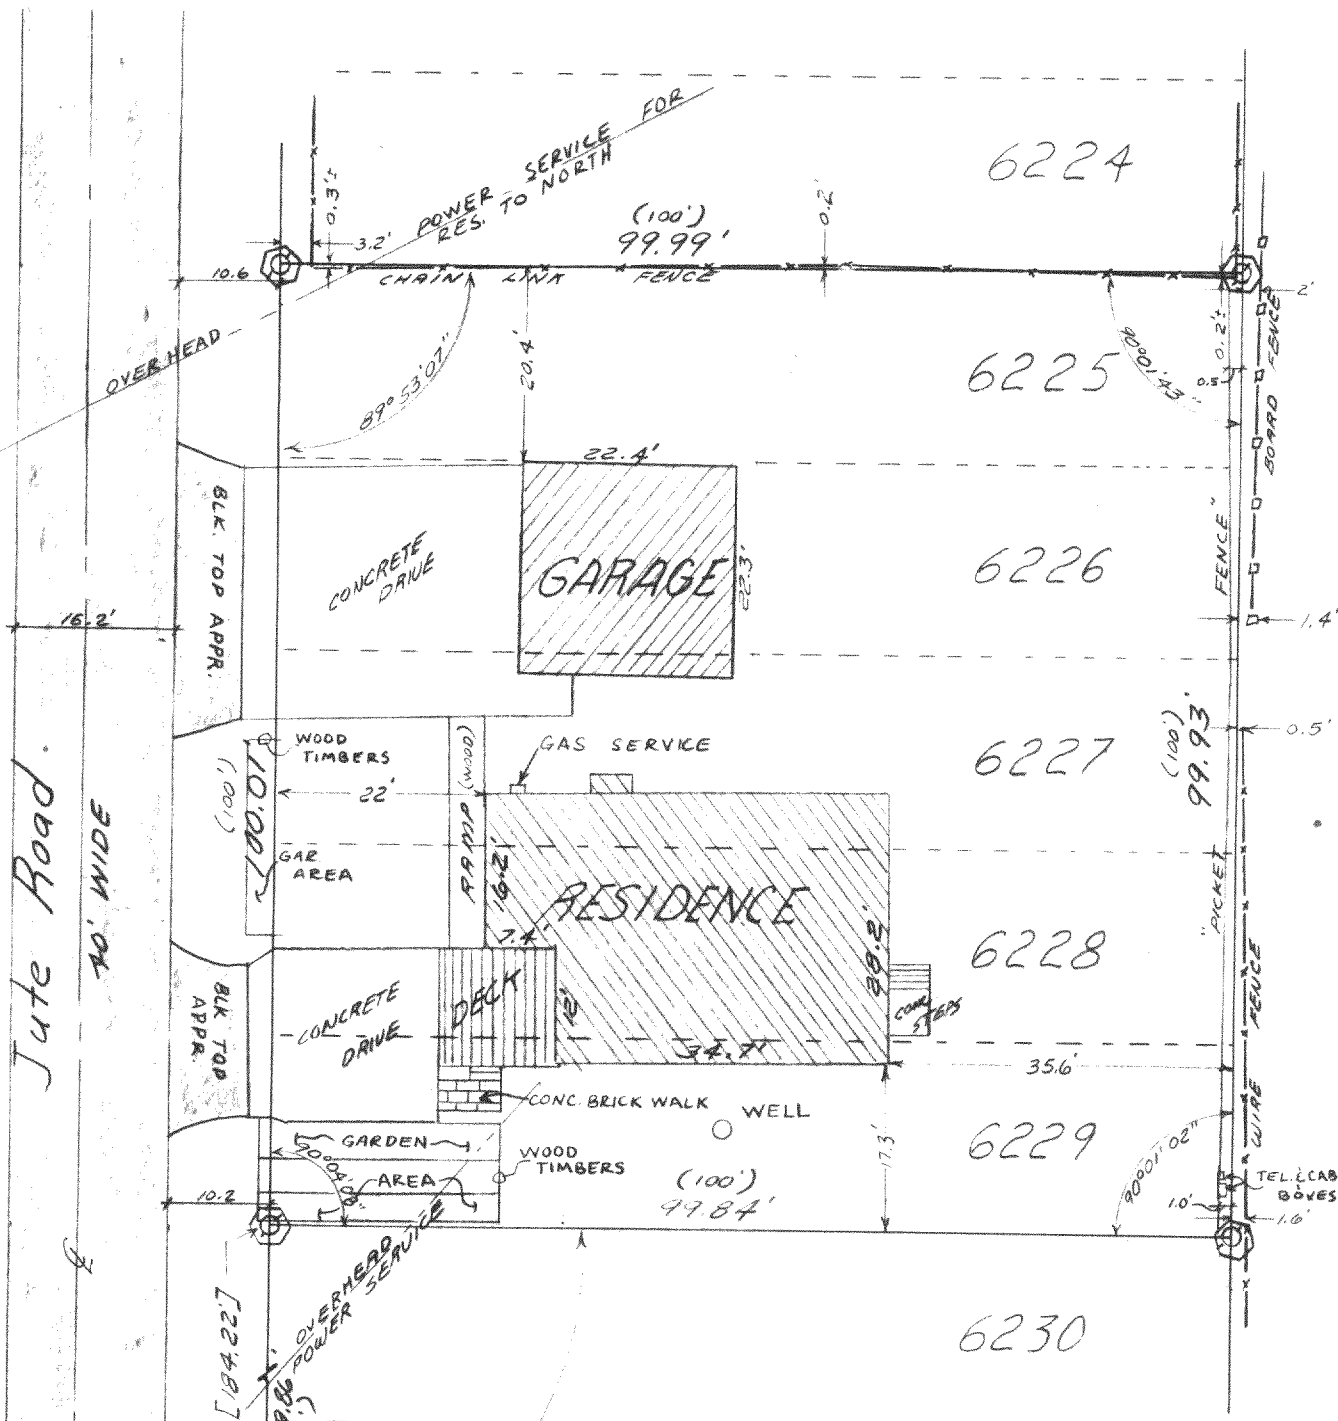

Legend
 ○ = IRON PIPE STAKE FOUND
 ● = IRON ROD STAKE FOUND
 (xxx) = RECORD DIMENSION - ORIG. PLAT
 [xxxx] = RECORD DIMENSION - WCSR 217-529

1983 WORK ORDERED BY: BUD KRUEGER
 MAY 1989 WORK ORD. BY: VACATION PROPERTY NETWORK
 FOR: LESTER KRUEGER

Lake Shore Drive

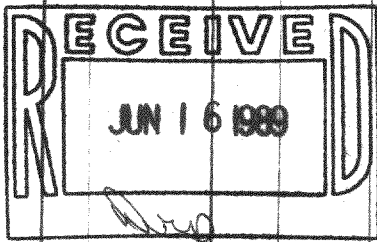

I hereby certify that I have surveyed the above described property and that the above map is a true representation thereof and shows the size and location of the property, its exterior boundaries, the location of all visible structures and dimensions of all principal buildings thereon, boundary fences, apparent easements, roadways and visible encroachments, if any.

This survey is made for the use of the present owners of the property, and also those who purchase, mortgage, or guarantee the title thereto within one (1) year from the date hereof.

Robert A. Farris

23 AUG. 1983

REVISED MAY 11, 1989 TO SHOW ADDITIONAL DETAIL AS RESULT OF INSPECTION ON THIS DATE. FOUND ALL STAKES INDICATED APPARENTLY UNDISTURBED IN ORIGINAL POSITION AS MEASURED 23 AUG 1983.

WISCONSIN
 ROBERT A. FARRIS
 S-1293
 ELKHORN, WIS.
 REGISTERED LAND SURVEYOR
 OFFICE: 414/723-2098 - HOME: 414/723-4438
 FAX: 414/723-5886

Farris, Hansen & Associates, Inc.

ENGINEERS, ARCHITECTS, SURVEYORS
 7 RIDGWAY CT. - P.O. BOX 437 - ELKHORN, WI 53121

ENGINEERING
 MUNICIPAL - STRUCTURAL
 HIGHWAYS - PUBLIC WORKS
 BUILDINGS - CIVIL

SURVEYING & PLANNING
 SUBDIVISIONS - LOT SURVEYS
 CONSTRUCTION STAKING - MAPPING
 CONDOMINIUMS

PROJ. # 2150

JLCB-1289

NB 1303-11

217-825