


**ABELL
SURVEYING & MAPPING
DELAVAN, WISCONSIN 53115
414-728-6737**

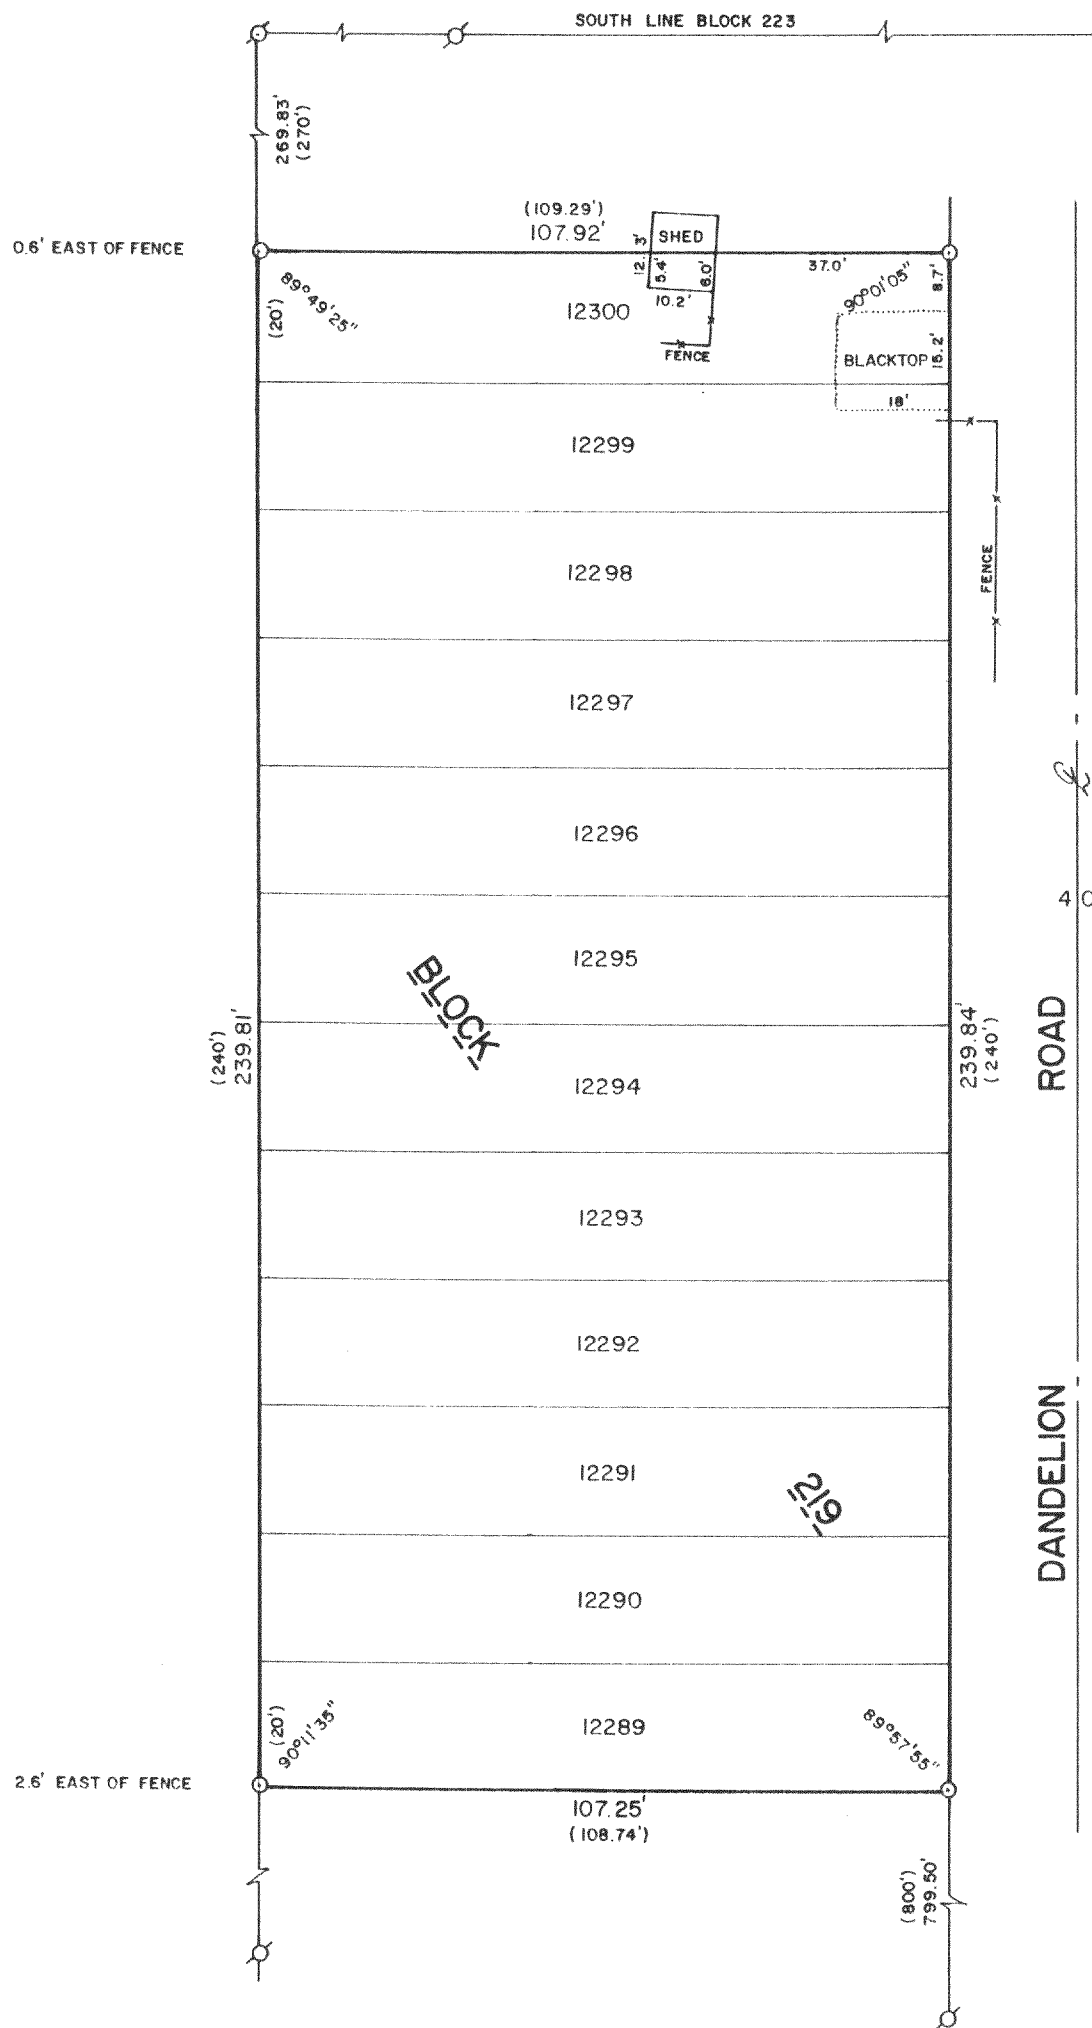


SCALE - 1"=30'

LEGEND

- ⊗ - IRON PIPE FOUND
- - IRON ROD SET
- () - RECORDED AS

ORDERED BY: FRED CLINE
RT. 2, BOX 493-33
LAKE GENEVA, WI.

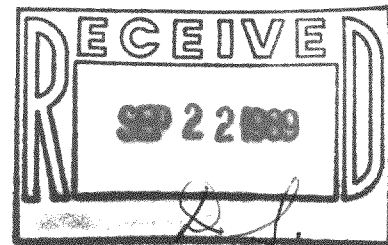

PLAT OF SURVEY OF

LOTS 12289-12300, BLOCK 219, LAKE COMO BEACH SUBDIVISION,
T2N,R17E, WALWORTH COUNTY, WISCONSIN.

I, DAVID F. ABELL, DO HEREBY CERTIFY
THAT I HAVE SURVEYED THE PROPERTY
HEREON DESCRIBED ACCORDING TO THE
OFFICIAL RECORDS AND THAT THE PLAT
HEREON IS A CORRECT REPRESENTATION
OF THE PROPERTY LINES TO THE BEST OF
MY KNOWLEDGE AND BELIEF.

David F. Abell

DAVID F. ABELL
WISCONSIN REGISTERED LAND SURVEYOR, S-1596

August 3, 1989

DATE *August 3, 1989* JOB NUMBER - 89151
NOTE: THIS IS NOT A CERTIFIED COPY UNLESS SEALED.

JLCB-2673

217-835