


LINCOLN

DAIRY

N

70

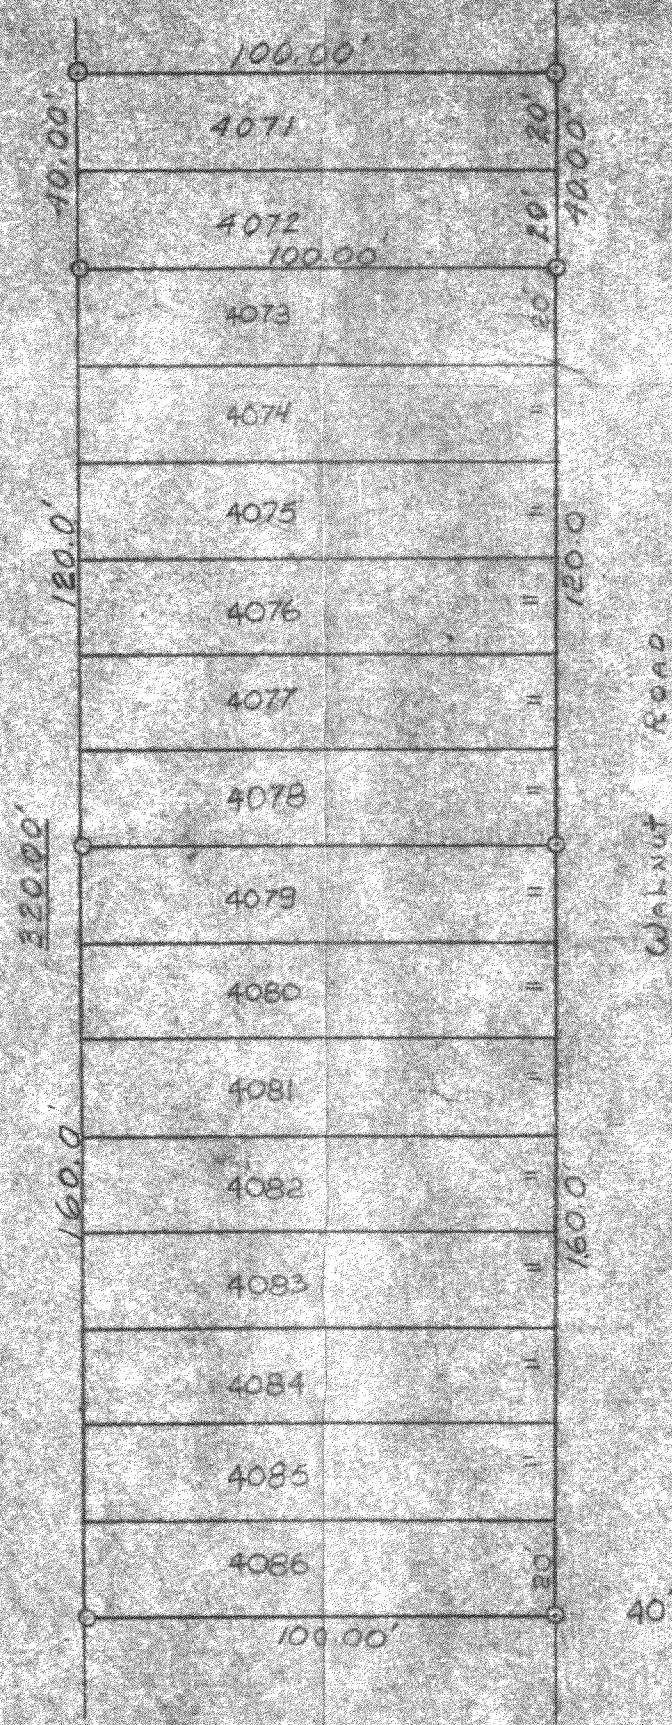

O = IRON PIPE

I CERTIFY: That I have surveyed the above described property and that the plat shown hereon is an accurate survey and a true representation thereof and correctly shows the exterior boundary lines and all divisions of said property.

Date August 1961

Lloyd L. Jensen
LLOYD L. JENSEN, Wisco. Registered Land Surveyor, S-211

PLAT OF SURVEY
OF

Lots 4071-4086 Block 70
Lake Como Beach T2N R17E
Walworth County Wisconsin

Revised, August, 1961

Lloyd L. Jensen
SURVEYOR

SCALE 1" = 40'

DATE SEPT. 1957

TLCB-782

217-85.1