



ABELL
SURVEYING & MAPPING
 DELAVAN, WISCONSIN 53115
 414-720-8737

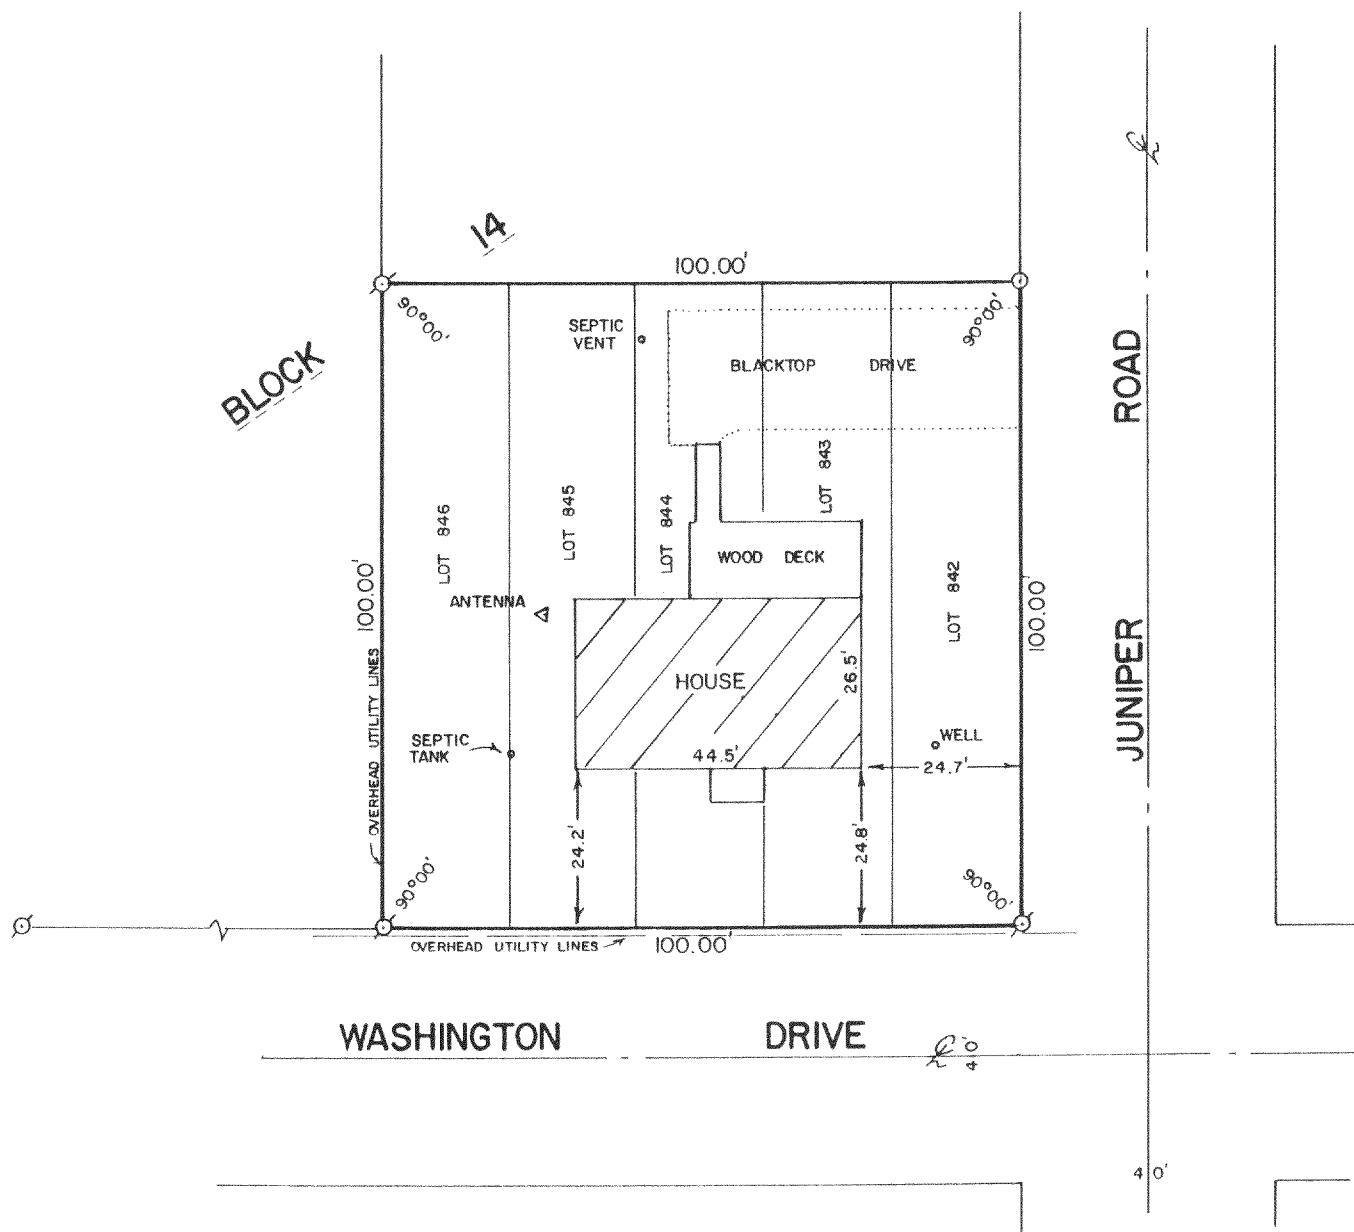

PLAT OF SURVEY OF

LOTS 842-846, BLOCK 14, LAKE COMO BEACH SUBDIVISION,
 T2N, R17E, WALWORTH COUNTY, WISCONSIN.

ORDERED BY: VACATION PROPERTIES NETWORK
 101 BROAD STREET
 LAKE GENEVA, WI. 53147

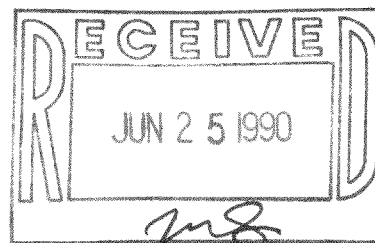

SCALE - 1"=30'

- LEGEND**
- ⊗ - IRON PIPE FOUND
 - - IRON PIPE FOUND
 - LEANING, PULLED AND RESET

I HEREBY CERTIFY THAT I HAVE SURVEYED THE ABOVE DESCRIBED PROPERTY AND THAT THE ABOVE MAP IS A TRUE REPRESENTATION THEREOF AND SHOWS THE SIZE AND LOCATION OF THE PROPERTY, ITS EXTERIOR BOUNDARIES, THE LOCATION OF ALL VISIBLE STRUCTURES AND DIMENSIONS OF ALL PRINCIPAL BUILDINGS THEREON, BOUNDARY FENCES, APPARENT EASEMENTS, ROADWAYS AND VISIBLE ENCROACHMENTS, IF ANY, TO THE BEST OF MY KNOWLEDGE AND BELIEF.

THIS SURVEY IS MADE FOR THE USE OF THE PRESENT OWNERS OF THE PROPERTY, AND ALSO THOSE WHO PURCHASE, MORTGAGE, OR GUARANTEE THE TITLE THERETO WITHIN ONE (1) YEAR FROM DATE HEREOF.

David F. Abell
 DAVID F. ABELL
 WISCONSIN REGISTERED LAND SURVEYOR, S-1596

April 9, 1990
 DATE _____ JOB NUMBER = 90064
 NOTE: THIS IS NOT A CERTIFIED COPY UNLESS SEALED.

Tax # JLCB-93F

217-853