

ABERNATHY and ASSOCIATES

Kenneth B. Abernathy Jr.



Wisconsin Registered Land Surveyor S-1594

Rt. 3, Box 273
Elkhorn, Wisconsin 53121
Phone: (414) 723-4260 (office)
(414) 723-4813 (residence)

PLAT OF SURVEY

ORDERED BY: VACATION PROPERTIES
101 BROAD ST.
LAKE GENEVA, WI. 53147

LOTS 12561 THRU 12570 INCLUSIVE AND LOTS 12591
THRU 12600 INCLUSIVE OF BLOCK 224 OF THE FIFTH MAP
OF LAKE COMO BEACH SUBDIVISION, LOCATED IN
SECTION 29, TOWN 2 NORTH, RANGE 17 EAST, WALWORTH
COUNTY, WISCONSIN.

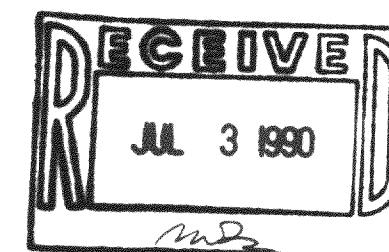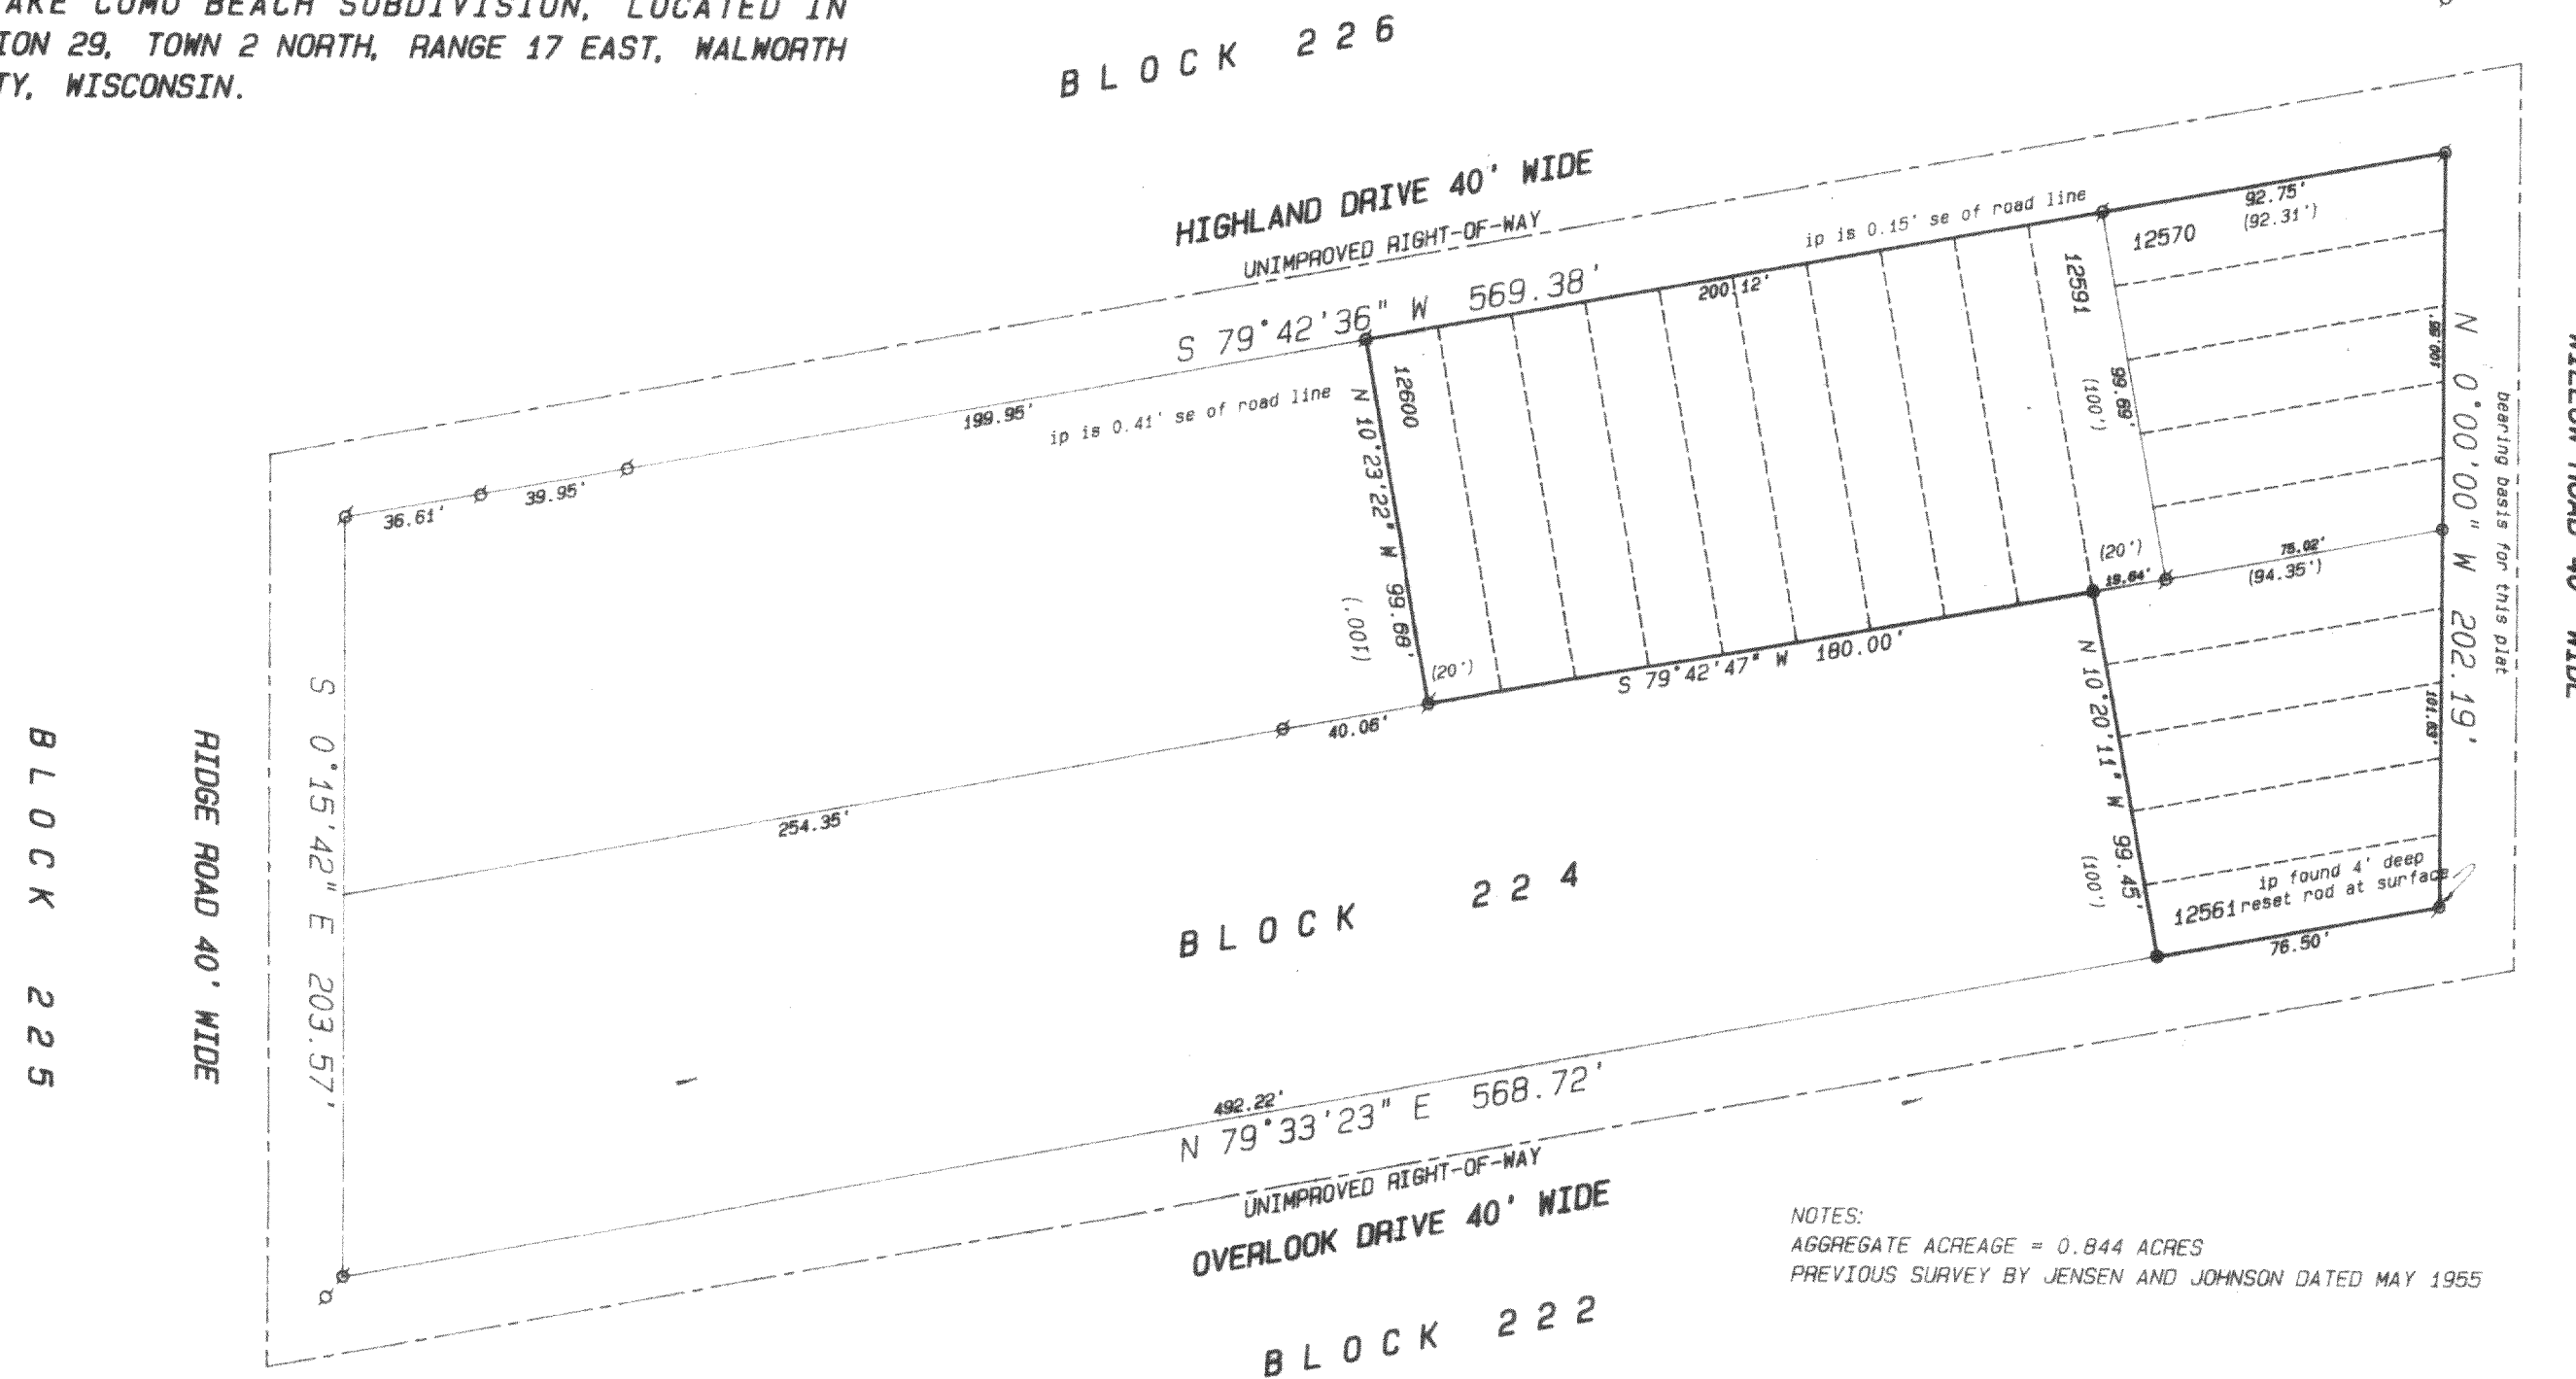

"I hereby certify that I have surveyed the above described property and that the above map is a true representation thereof and shows the size and location of the property, its exterior boundaries, the location of all visible structures and dimensions of all principal buildings thereon, boundary fences, apparent easements, roadways and visible encroachments, if any."

"This survey is made for the use of the present owners of the property, and also those who purchase, mortgage, or guarantee the title thereto within one year from date hereof."

Kenneth B. Abernathy, Jr.
KENNETH B. ABERNATHY, JR.
WISCONSIN REGISTERED LAND SURVEYOR,
S-1594

Date: 6-11-90 Job No. 90-607

TAX # 5JLCB-39
JLCB-46

217-856