



Plat of Survey of lots 7058, 7059, 7060, 7061, & 7062 of Lake Como Beach 1st Map, Sec. 28, T2N, R17E, Geneva Twp., Lake Geneva, Wisconsin.


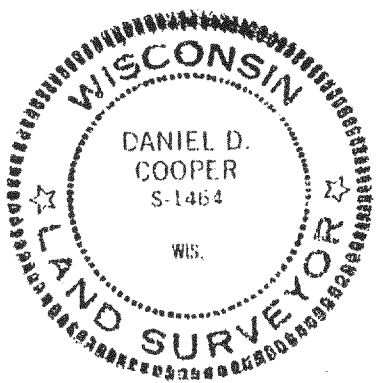


Survey ordered by- Mary D'Andrea

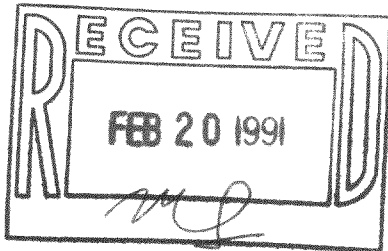

D. D. COOPER & CO., INC.
Daniel D. Cooper
Rt. 4 Box 508B
Elkhorn, WI 53121

LINCOLN DR.

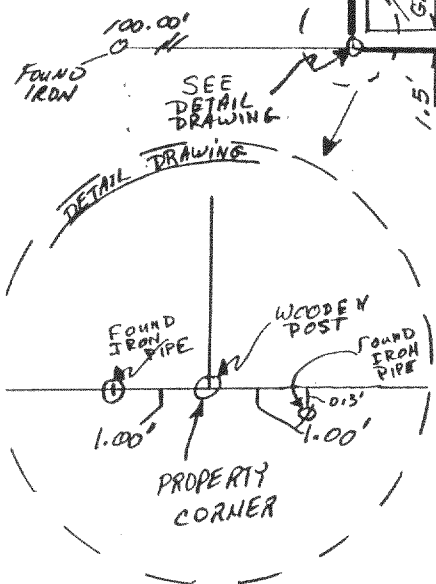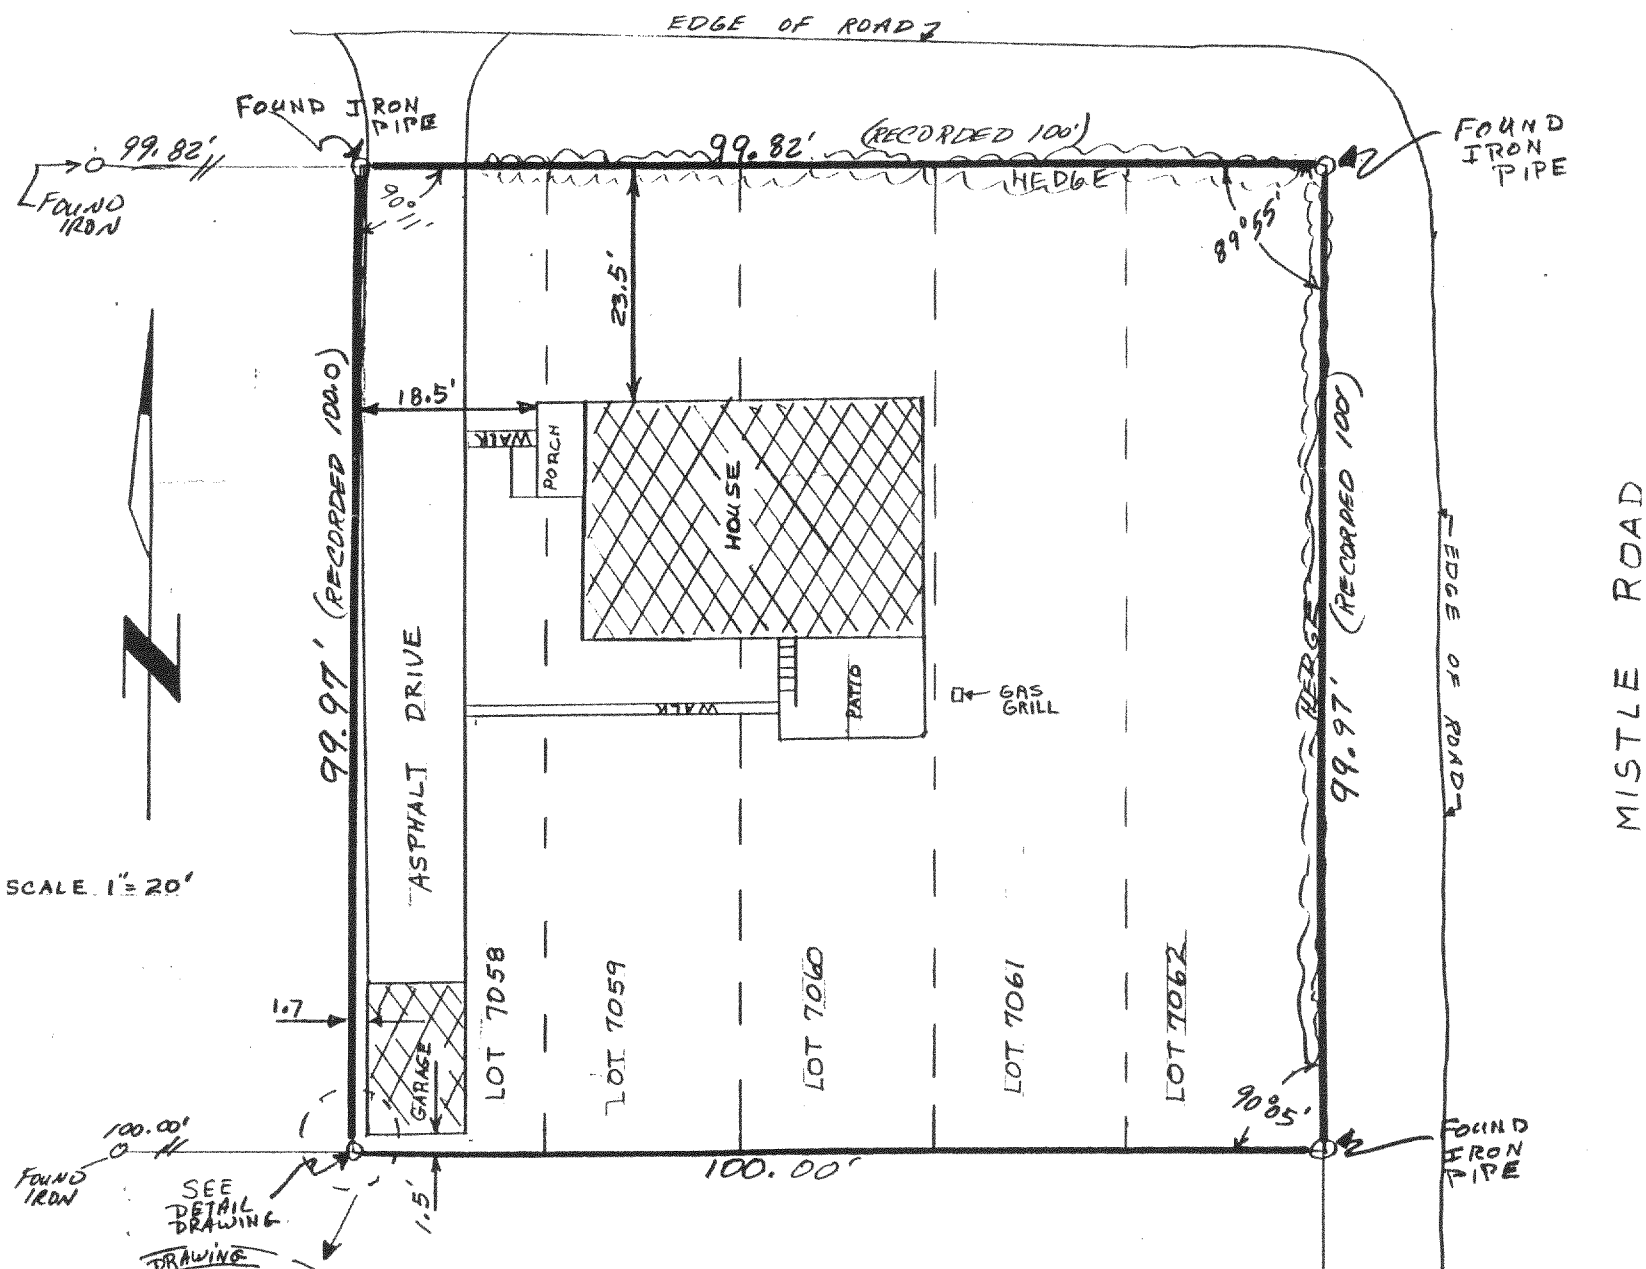

I hereby certify that I have surveyed the property described hereon and that the above map is a true and accurate representation thereof to the best of my professional knowledge and belief.

Dated this 3rd day of Jan., 1990
Daniel D. Cooper
Daniel D. Cooper, RLS No. S-1464

TAX KEY #
JLCB 01493

Redused

217-857
Drawing No. 3576