

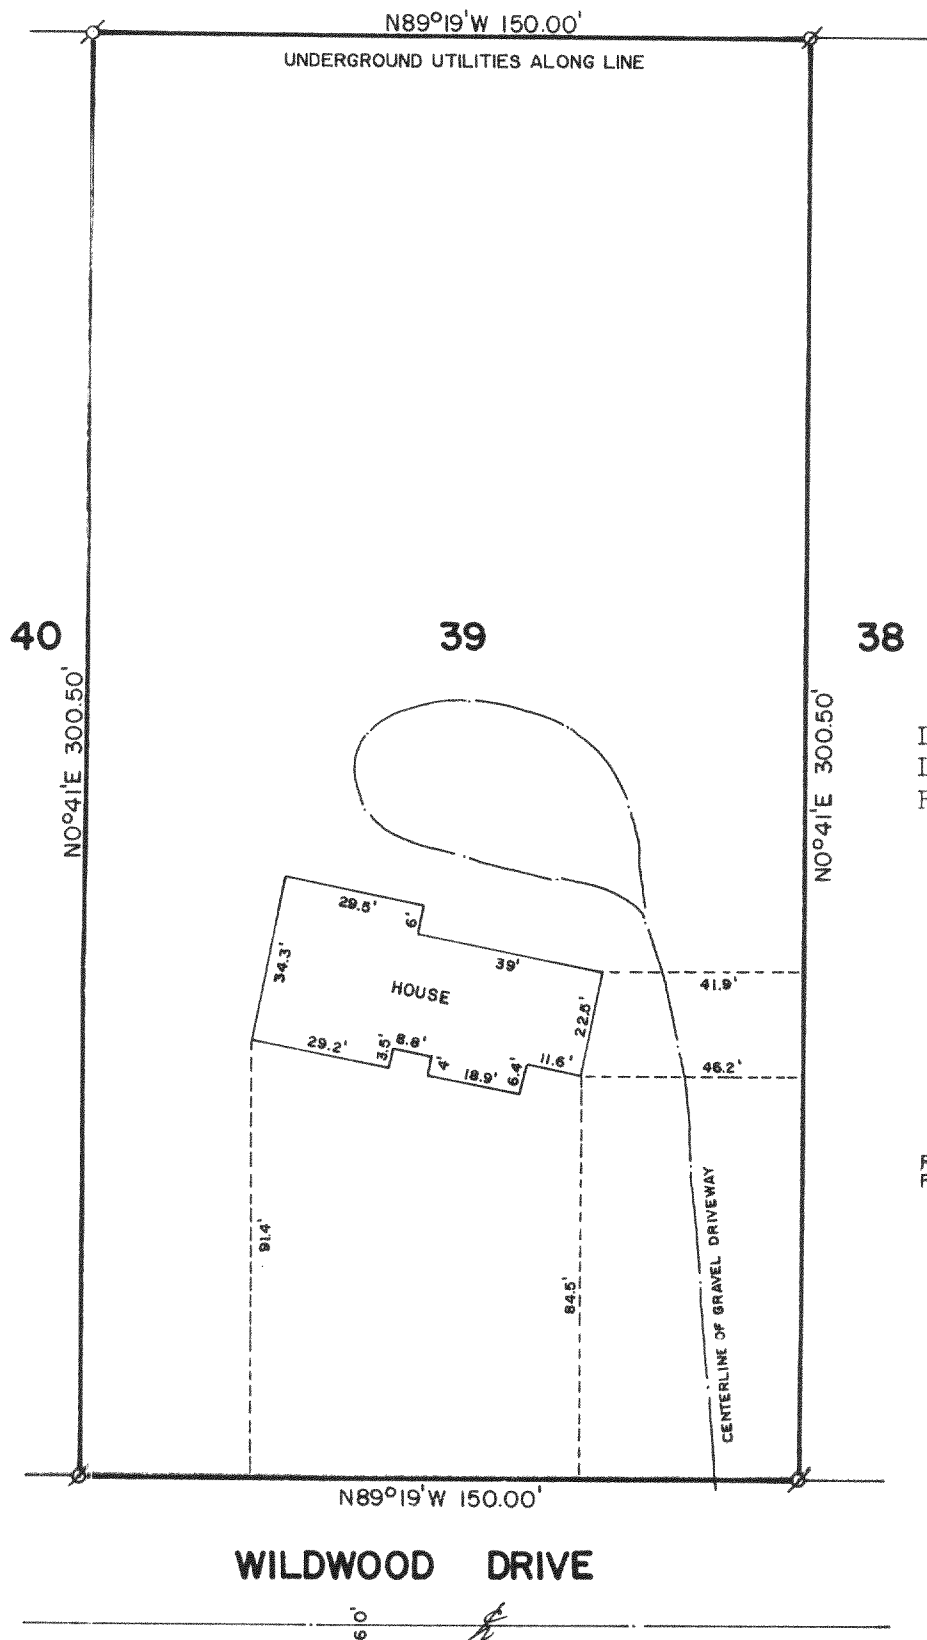


WALWORTH COUNTY
SURVEYING & MAPPING
LAKE GENEVA, WISCONSIN

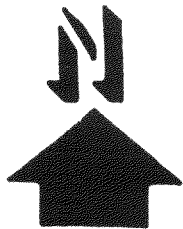

PLAT OF SURVEY OF
LOT 39 OF WILDWOOD SUBDIVISION,
LOCATED IN SECTION 34, T 2 N,
R 17 E, WALWORTH COUNTY, WISCONSIN.

RECERTIFIED: SEPT. 12, 1989
FOR: KEEFE REAL ESTATE
704 MAIN STREET
LAKE GENEVA, WISCONSIN

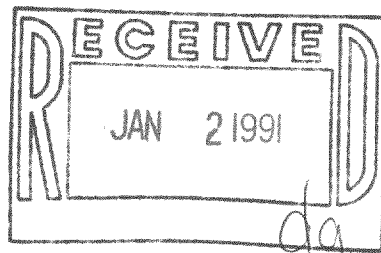

SCALE: 1"=40'

Ø = 1"=10' (1"=10' 0"=10')

I HEREBY CERTIFY THAT I HAVE SURVEYED THE ABOVE DESCRIBED PROPERTY AND THAT THE ABOVE MAP IS A TRUE REPRESENTATION THEREOF AND SHOWS THE SIZE AND LOCATION OF THE PROPERTY, ITS EXTENSION BOUNDARIES, THE LOCATION OF ALL VISIBLE STRUCTURES AND DIMENSIONS OF ALL PRINCIPAL BUILDINGS THEREON, BOUNDARY FENCES, APPARENT EASEMENTS AND ROADWAYS AND VISIBLE ENCROACHMENTS, IF ANY.

THIS SURVEY IS MADE FOR THE EXCLUSIVE USE OF THE PRESENT OWNERS OF THE PROPERTY, AND ALSO THOSE WHO PURCHASE, MORTGAGE, OR GUARANTEE THE TITLE THERETO WITHIN ONE (1) YEAR FROM DATE HEREOF.

Robert M. Baerenwald
ROBERT M. BAERENWALD
WISCONSIN REGISTERED LAND SURVEYOR, S-1508


Nov. 8, 1986
DATE JOB NO. 0820

NOTE: THIS IS NOT A CERTIFIED COPY UNLESS SEALED.

Survey # 217-862



TAX KEY # JWS00039

WALWORTH COUNTY
SURVEYING & MAPPING
LAKE GENEVA, WISCONSIN

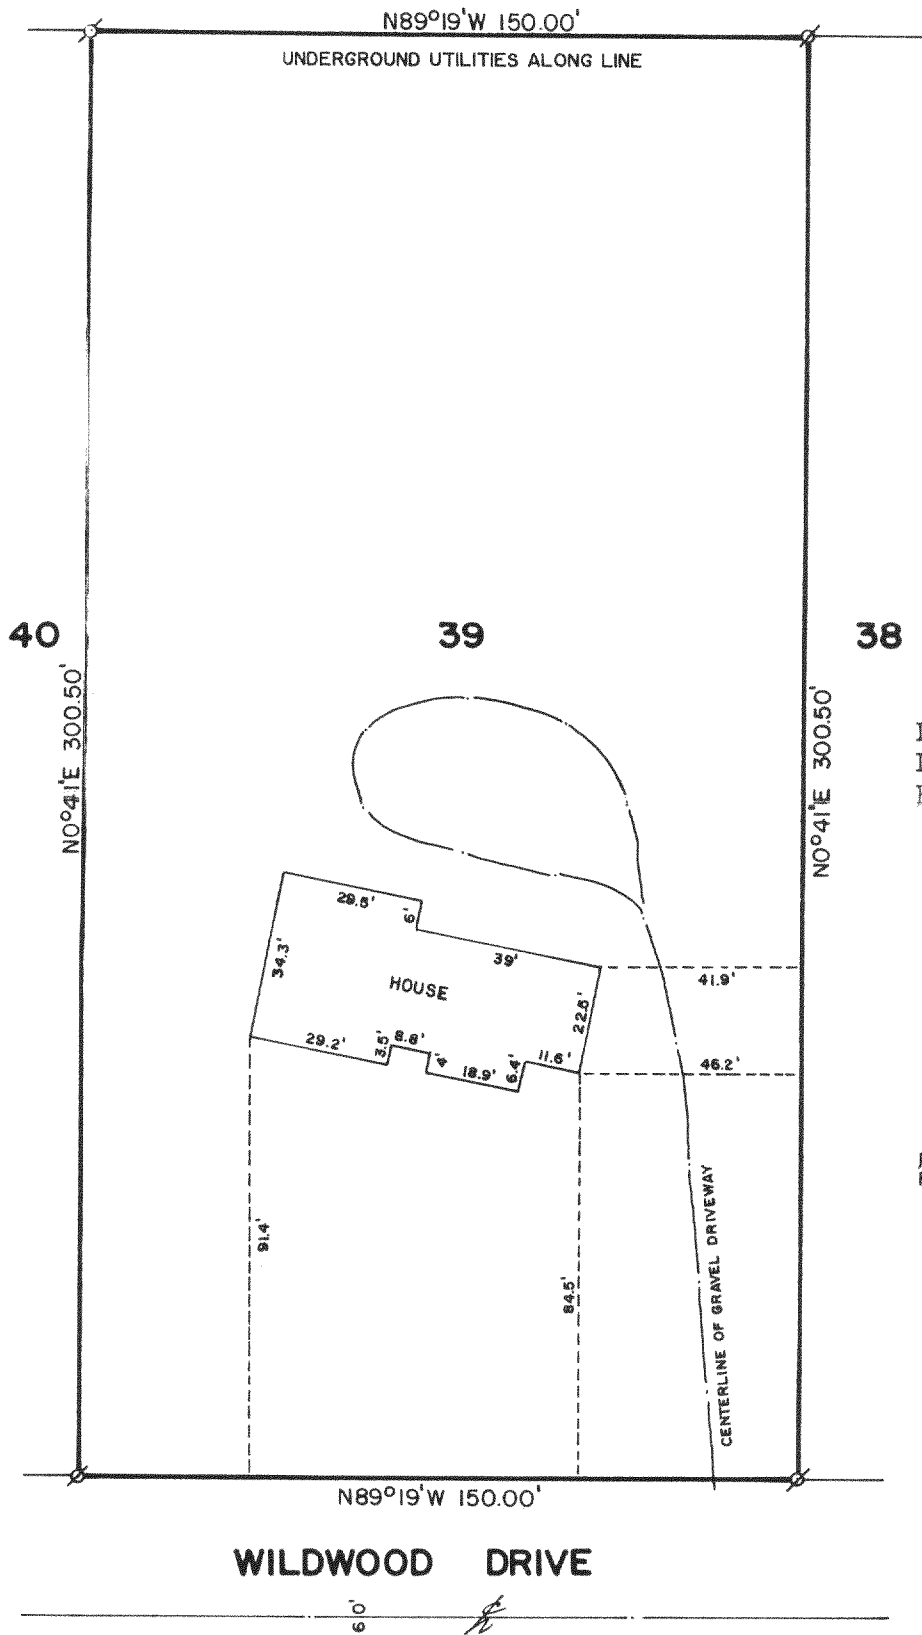

PLAT OF SURVEY OF
LOT 39 OF WILDWOOD SUBDIVISION,
LOCATED IN SECTION 34, T 2 N,
R 17 E, WALWORTH COUNTY, WISCONSIN.

RECERTIFIED: SEPT. 12, 1989
FOR: KEEFE REAL ESTATE
704 MAIN STREET
LAKE GENEVA, WISCONSIN

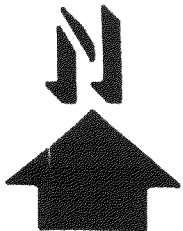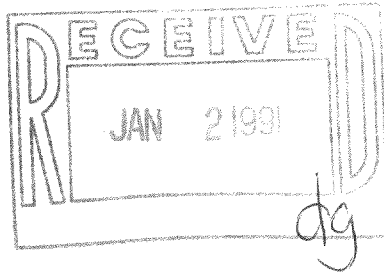

SCALE: 1"=40'

Ø 1/4" = 1' 0"

Ø 1/8" = 1' 0"

I HEREBY CERTIFY THAT I HAVE SURVEYED THE ABOVE DESCRIBED PROPERTY AND THAT THE ABOVE MAP IS A TRUE REPRESENTATION THEREOF AND SHOWS THE SIZE AND LOCATION OF THE PROPERTY, ITS EXTERIOR BOUNDARIES, THE LOCATION OF ALL VISIBLE STRUCTURES AND DIMENSIONS OF ALL PRINCIPAL BUILDINGS THEREON, BOUNDARY FENCES, APPARENT EASEMENTS AND ROADWAYS AND VISIBLE ENCROACHMENTS, IF ANY.


THIS SURVEY IS MADE FOR THE EXCLUSIVE USE OF THE PRESENT OWNERS OF THE PROPERTY, AND ALSO THOSE WHO PURCHASE, MORTGAGE, OR GUARANTEE THE TITLE THERE TO WITHIN ONE (1) YEAR FROM DATE HEREOF.

Robert M. Baerenwald
ROBERT M. BAERENWALD
WISCONSIN REGISTERED LAND SURVEYOR, S-1508

Nov. 8, 1986
DATE JOB NO. 6820



NOTE: THIS IS NOT A CERTIFIED COPY UNLESS SEALED.

WALWORTH COUNTY
SURVEYING & MAPPING
LAKE GENEVA, WISCONSIN

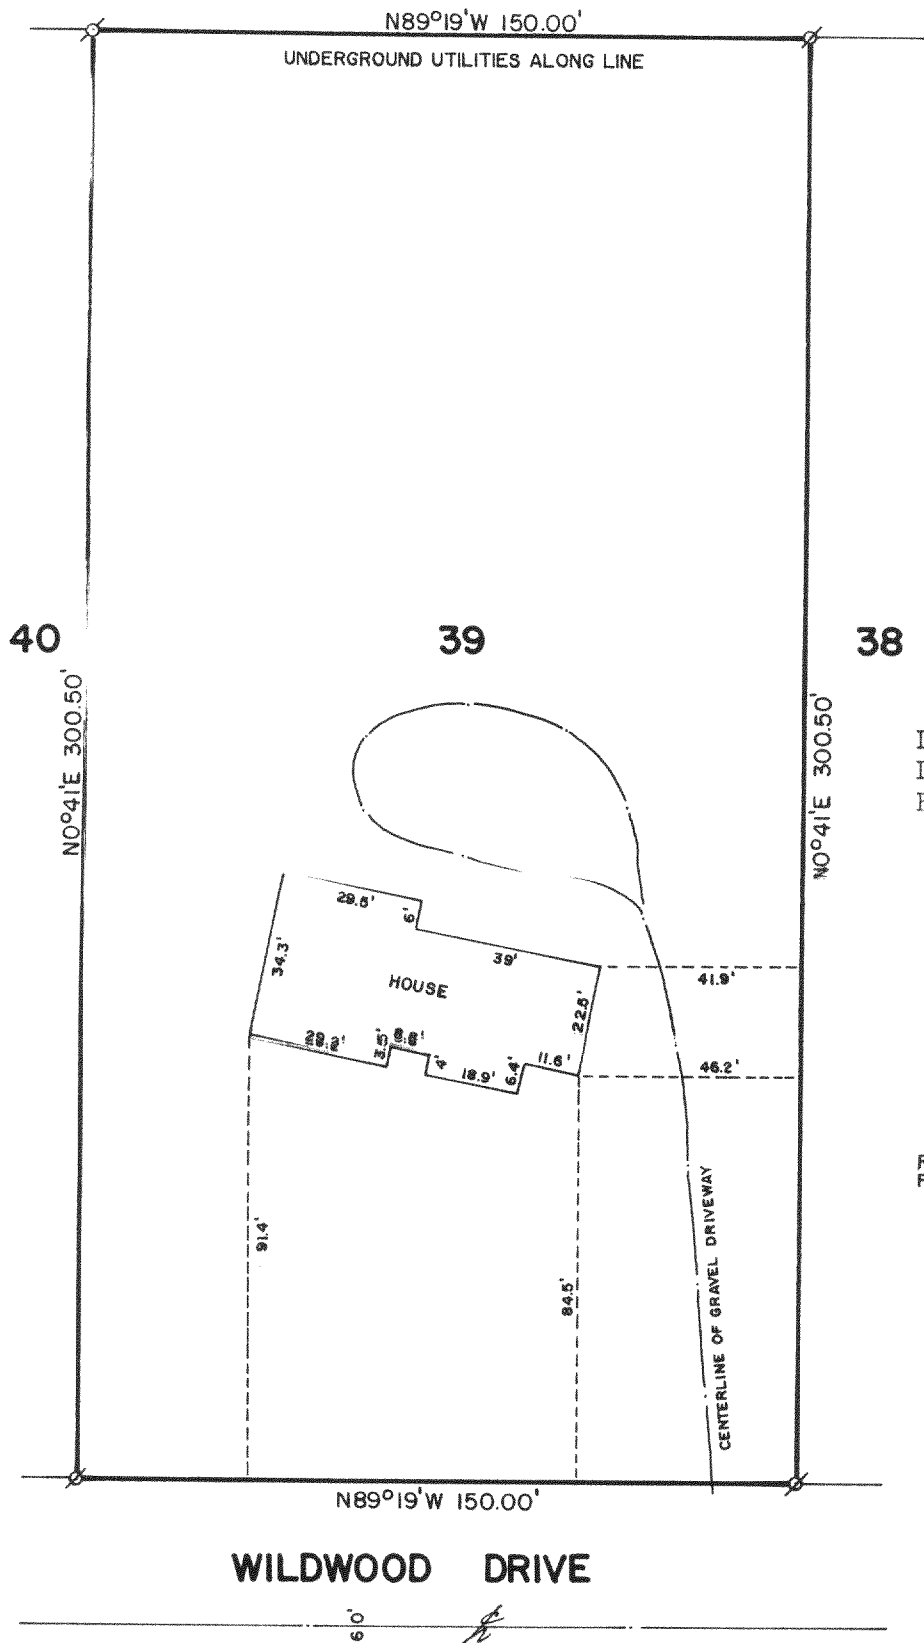

PLAT OF SURVEY OF
LOT 39 OF WILDWOOD SUBDIVISION,
LOCATED IN SECTION 34, T 2 N,
R 17 E, WALWORTH COUNTY, WISCONSIN.

RECERTIFIED: SEPT. 12, 1989
FOR: KEEFE REAL ESTATE
704 MAIN STREET
LAKE GENEVA, WISCONSIN

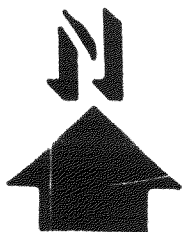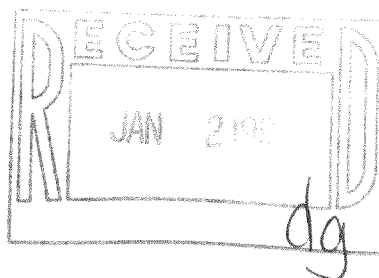

OWNER: [illegible]

Ø - [illegible]
Ø - [illegible]

I HEREBY CERTIFY THAT I HAVE SURVEYED THE ABOVE DESCRIBED PROPERTY AND THAT THE ABOVE MAP IS A TRUE REPRESENTATION THEREOF AND SHOWS THE SIZE AND LOCATION OF THE PROPERTY, ITS EXTERIOR BOUNDARIES, THE LOCATION OF ALL VISIBLE STRUCTURES AND DIMENSIONS OF ALL PRINCIPAL BUILDINGS THEREON, BOUNDARY FENCES, APPARENT EASEMENTS AND ROADWAYS AND VISIBLE ENCROACHMENTS, IF ANY.

THIS SURVEY IS MADE FOR THE EXCLUSIVE USE OF THE PRESENT OWNERS OF THE PROPERTY, AND ALSO THOSE WHO PURCHASE, MORTGAGE, OR GUARANTEE THE TITLE THERETO WITHIN ONE (1) YEAR FROM DATE HEREOF.

Robert M. Baerenwald
ROBERT M. BAERENWALD
WISCONSIN REGISTERED LAND SURVEYOR, S-1508

Nov. 8, 1986
DATE JOB NO. 0820

NOTE: THIS IS NOT A CERTIFIED COPY UNLESS SEALED.