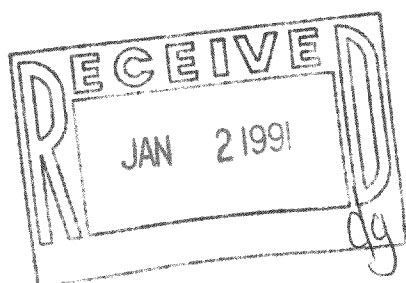


[illegible]

LOTS 3 AND 4 OF COMO VISTA SUBDIVISION,
LOCATED IN SECTION 32, T 2 N, R 17 E,
WALWORTH COUNTY, WISCONSIN.

ORDERED BY: ALMA CRUMLISH
1425 WEST GRANVILLE
CHICAGO, ILLINOIS
60660

I HEREBY CERTIFY THAT I HAVE SURVEYED THE ABOVE DESCRIBED PROPERTY AND THAT THE ABOVE MAP IS A TRUE REPRESENTATION THEREOF AND SHOWS THE SIZE AND LOCATION OF THE PROPERTY, ITS EXTERIOR BOUNDARIES, THE LOCATION OF ALL VISIBLE STRUCTURES AND DIMENSIONS OF ALL PRINCIPAL BUILDINGS THEREON, BOUNDARY FENCES, APPARENT EASEMENTS AND ROADWAYS AND VISIBLE ENCROACHMENTS, IF ANY, TO THE BEST OF MY KNOWLEDGE AND BELIEF.

THIS SURVEY IS MADE FOR THE USE OF THE PRESENT OWNERS OF THE PROPERTY AND ALSO THOSE WHO PURCHASE, MORTGAGE OR GUARANTEE THE TITLE THERETO WITHIN ONE (1) YEAR FROM DATE HEREOF.

Robert M. Baerwald
ROBERT M. BAERENWALD
WISCONSIN REGISTERED LAND SURVEYOR, S-1508

DATE Nov. 2, 1989 JOB NO. 2255



NOTE: THIS IS NOT A CERTIFIED COPY UNLESS SEALED

ϕ - IRON PIPE FOUND
 ○ - IRON PIPE PLACED
 () - RECORDED AS

Survey # 217-888

TAX KEY # Jcom 00002
Jcom 00003


WALWORTH COUNTY
SURVEYING & MAPPING
LAKE GENEVA, WISCONSIN
414-248-0505

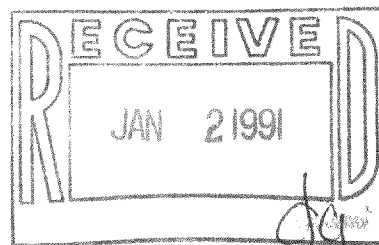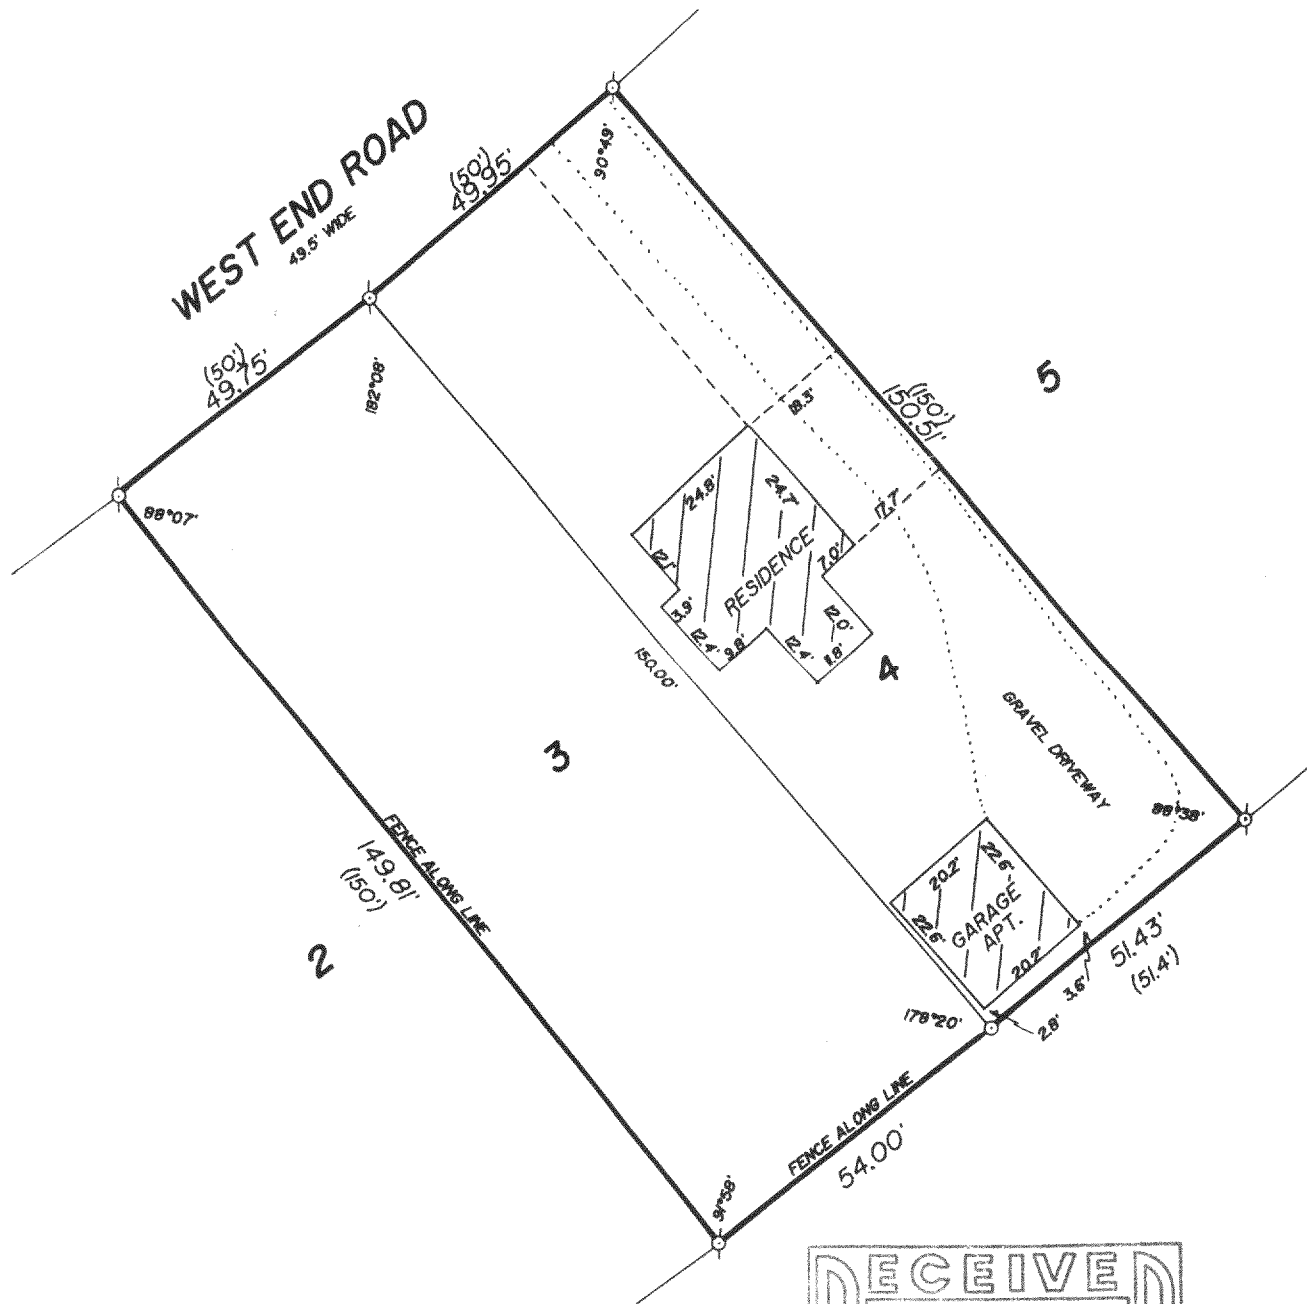

PLAT OF SURVEY OF

LOTS 3 AND 4 OF COMO VISTA SUBDIVISION,
LOCATED IN SECTION 32, T 2 N, R 17 E,
WALWORTH COUNTY, WISCONSIN.

ORDERED BY: ALMA CRUMLISH
1425 WEST GRANVILLE
CHICAGO, ILLINOIS
60660

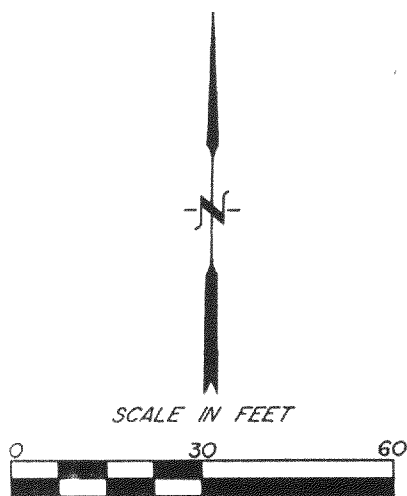

-IRON PIPE FOUND
-IRON PIPE PLACED
()-RECORDED AS

I HEREBY CERTIFY THAT I HAVE SURVEYED THE ABOVE DESCRIBED PROPERTY AND THAT THE ABOVE MAP IS A TRUE REPRESENTATION THEREOF AND SHOWS THE SIZE AND LOCATION OF THE PROPERTY, ITS EXTERIOR BOUNDARIES, THE LOCATION OF ALL VISIBLE STRUCTURES AND DIMENSIONS OF ALL PRINCIPAL BUILDINGS THEREON, BOUNDARY FENCES, APPARENT EASEMENTS AND ROADWAYS AND VISIBLE ENCROACHMENTS, IF ANY, TO THE BEST OF MY KNOWLEDGE AND BELIEF.

THIS SURVEY IS MADE FOR THE USE OF THE PRESENT OWNERS OF THE PROPERTY AND ALSO THOSE WHO PURCHASE, MORTGAGE OR GUARANTEE THE TITLE THERETO WITHIN ONE (1) YEAR FROM DATE HEREOF.

Robert M. Baerenwald
ROBERT M. BAERENWALD
WISCONSIN REGISTERED LAND SURVEYOR, S-1508

DATE 1000-2-1989 JOB NO. 2255

NOTE: THIS IS NOT A CERTIFIED COPY UNLESS SEALED