



WALWORTH COUNTY
SURVEYING & MAPPING
727 HENRY STREET
LAKE GENEVA, WISCONSIN
414-248-0505

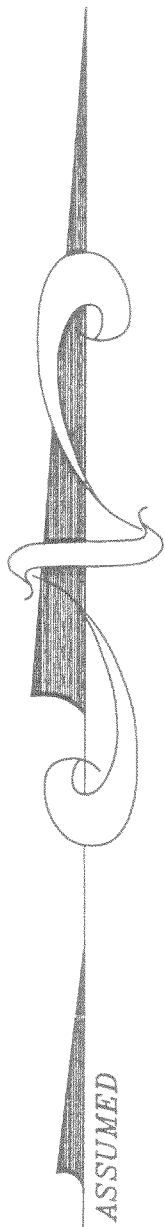

JUNIPER ROAD

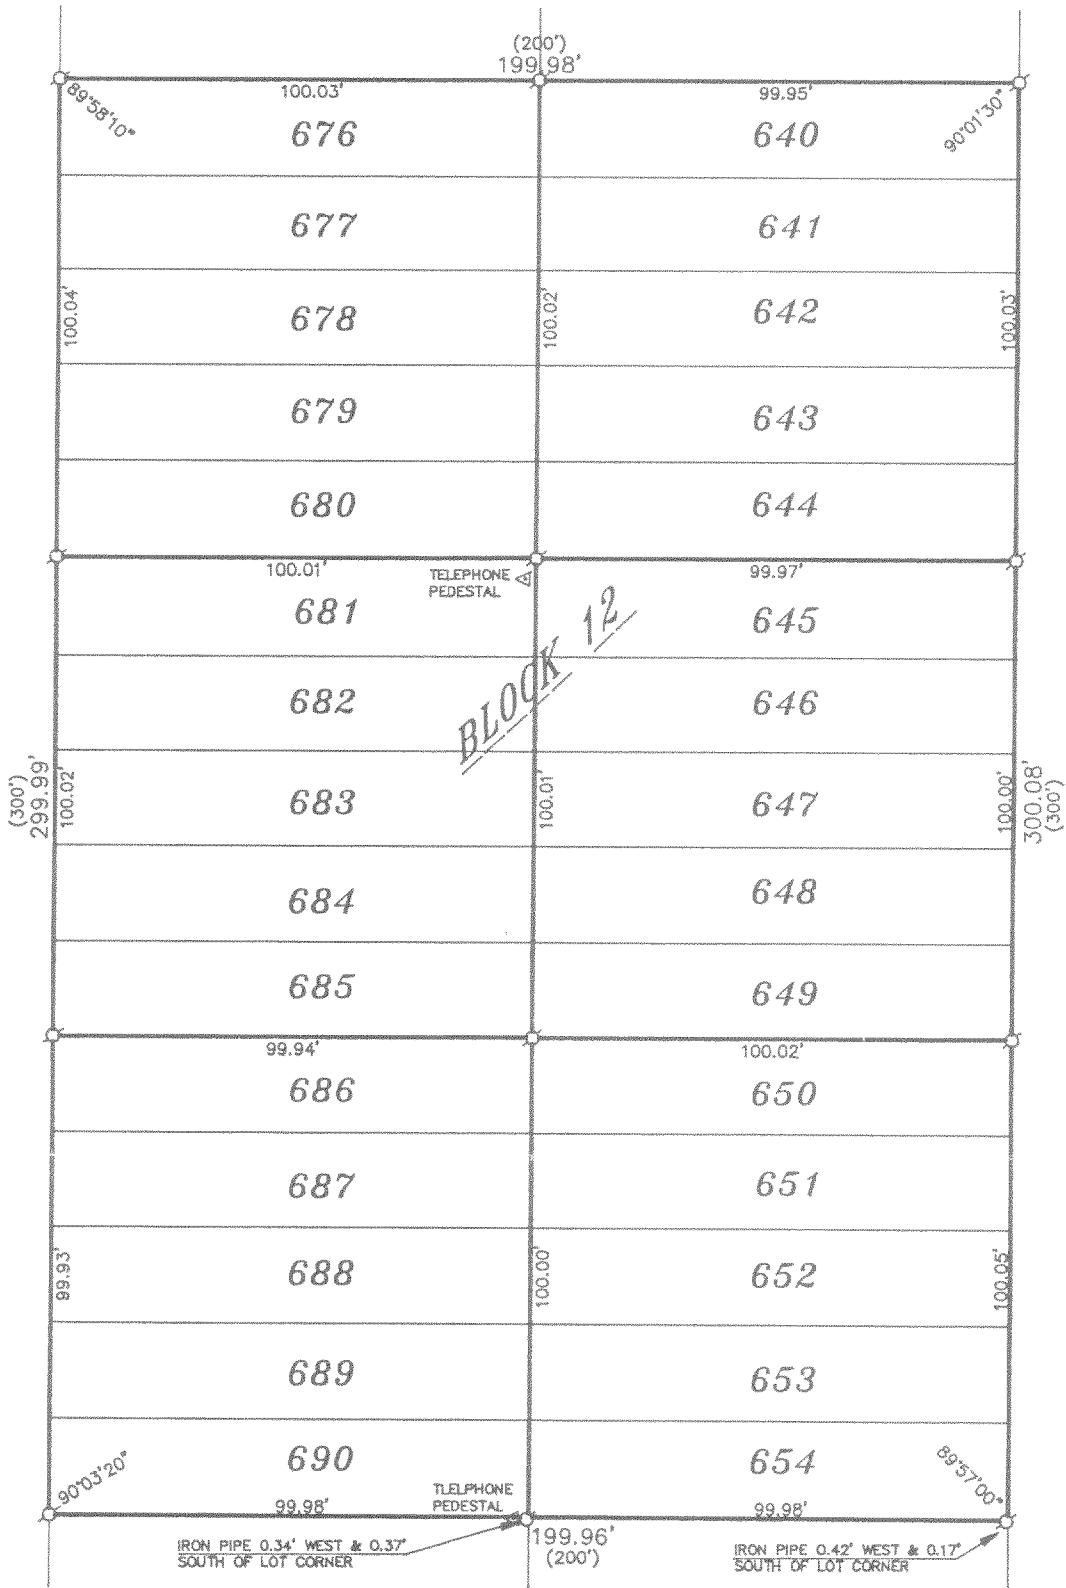


IVY ROAD

PLAT OF SURVEY OF

LOTS 640-654 AND 676-690, INCLUSIVE, BLOCK 12 OF LAKE COMO BEACH, A SUBDIVISION LOCATED IN T 2 N, R 17 E, WALWORTH COUNTY, WISCONSIN.

ORDERED BY: MIKRUT BUILDERS
LAKE GENEVA, WISCONSIN

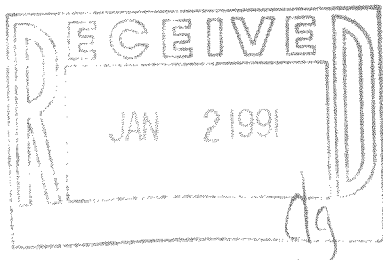

GRAPHIC SCALE



(IN FEET)

1 inch = 40 ft.

- - IRON PIPE FOUND
- - IRON PIPE PLACED
- () - RECORDED AS

I HEREBY CERTIFY THAT I HAVE SURVEYED THE ABOVE DESCRIBED PROPERTY AND THAT THE ABOVE MAP IS A TRUE REPRESENTATION THEREOF AND SHOWS THE SIZE AND LOCATION OF THE PROPERTY, ITS EXTERIOR BOUNDARIES, THE LOCATION OF ALL VISIBLE STRUCTURES AND DIMENSIONS OF ALL PRINCIPAL BUILDINGS THEREON, BOUNDARY FENCES, APPARENT EASEMENTS, ROADWAYS AND VISIBLE ENCROACHMENTS, IF ANY, TO THE BEST OF MY KNOWLEDGE AND BELIEF.

THIS SURVEY IS MADE FOR THE USE OF THE PRESENT OWNERS OF THE PROPERTY AND ALSO THOSE WHO PURCHASE, MORTGAGE OR GUARANTEE THE TITLE THERETO WITHIN ONE (1) YEAR FROM DATE HEREOF.

Robert M. Baerenwald
ROBERT M. BAERENWALD
WISCONSIN REGISTERED LAND SURVEYOR, S-1508

DATE July 31, 1990 JOB NO. 2583

NOTE: THIS IS NOT A CERTIFIED COPY UNLESS SEALED.

217-911

JLCB 00080A
JLCB 00083