


Beech Road (40' Wide)

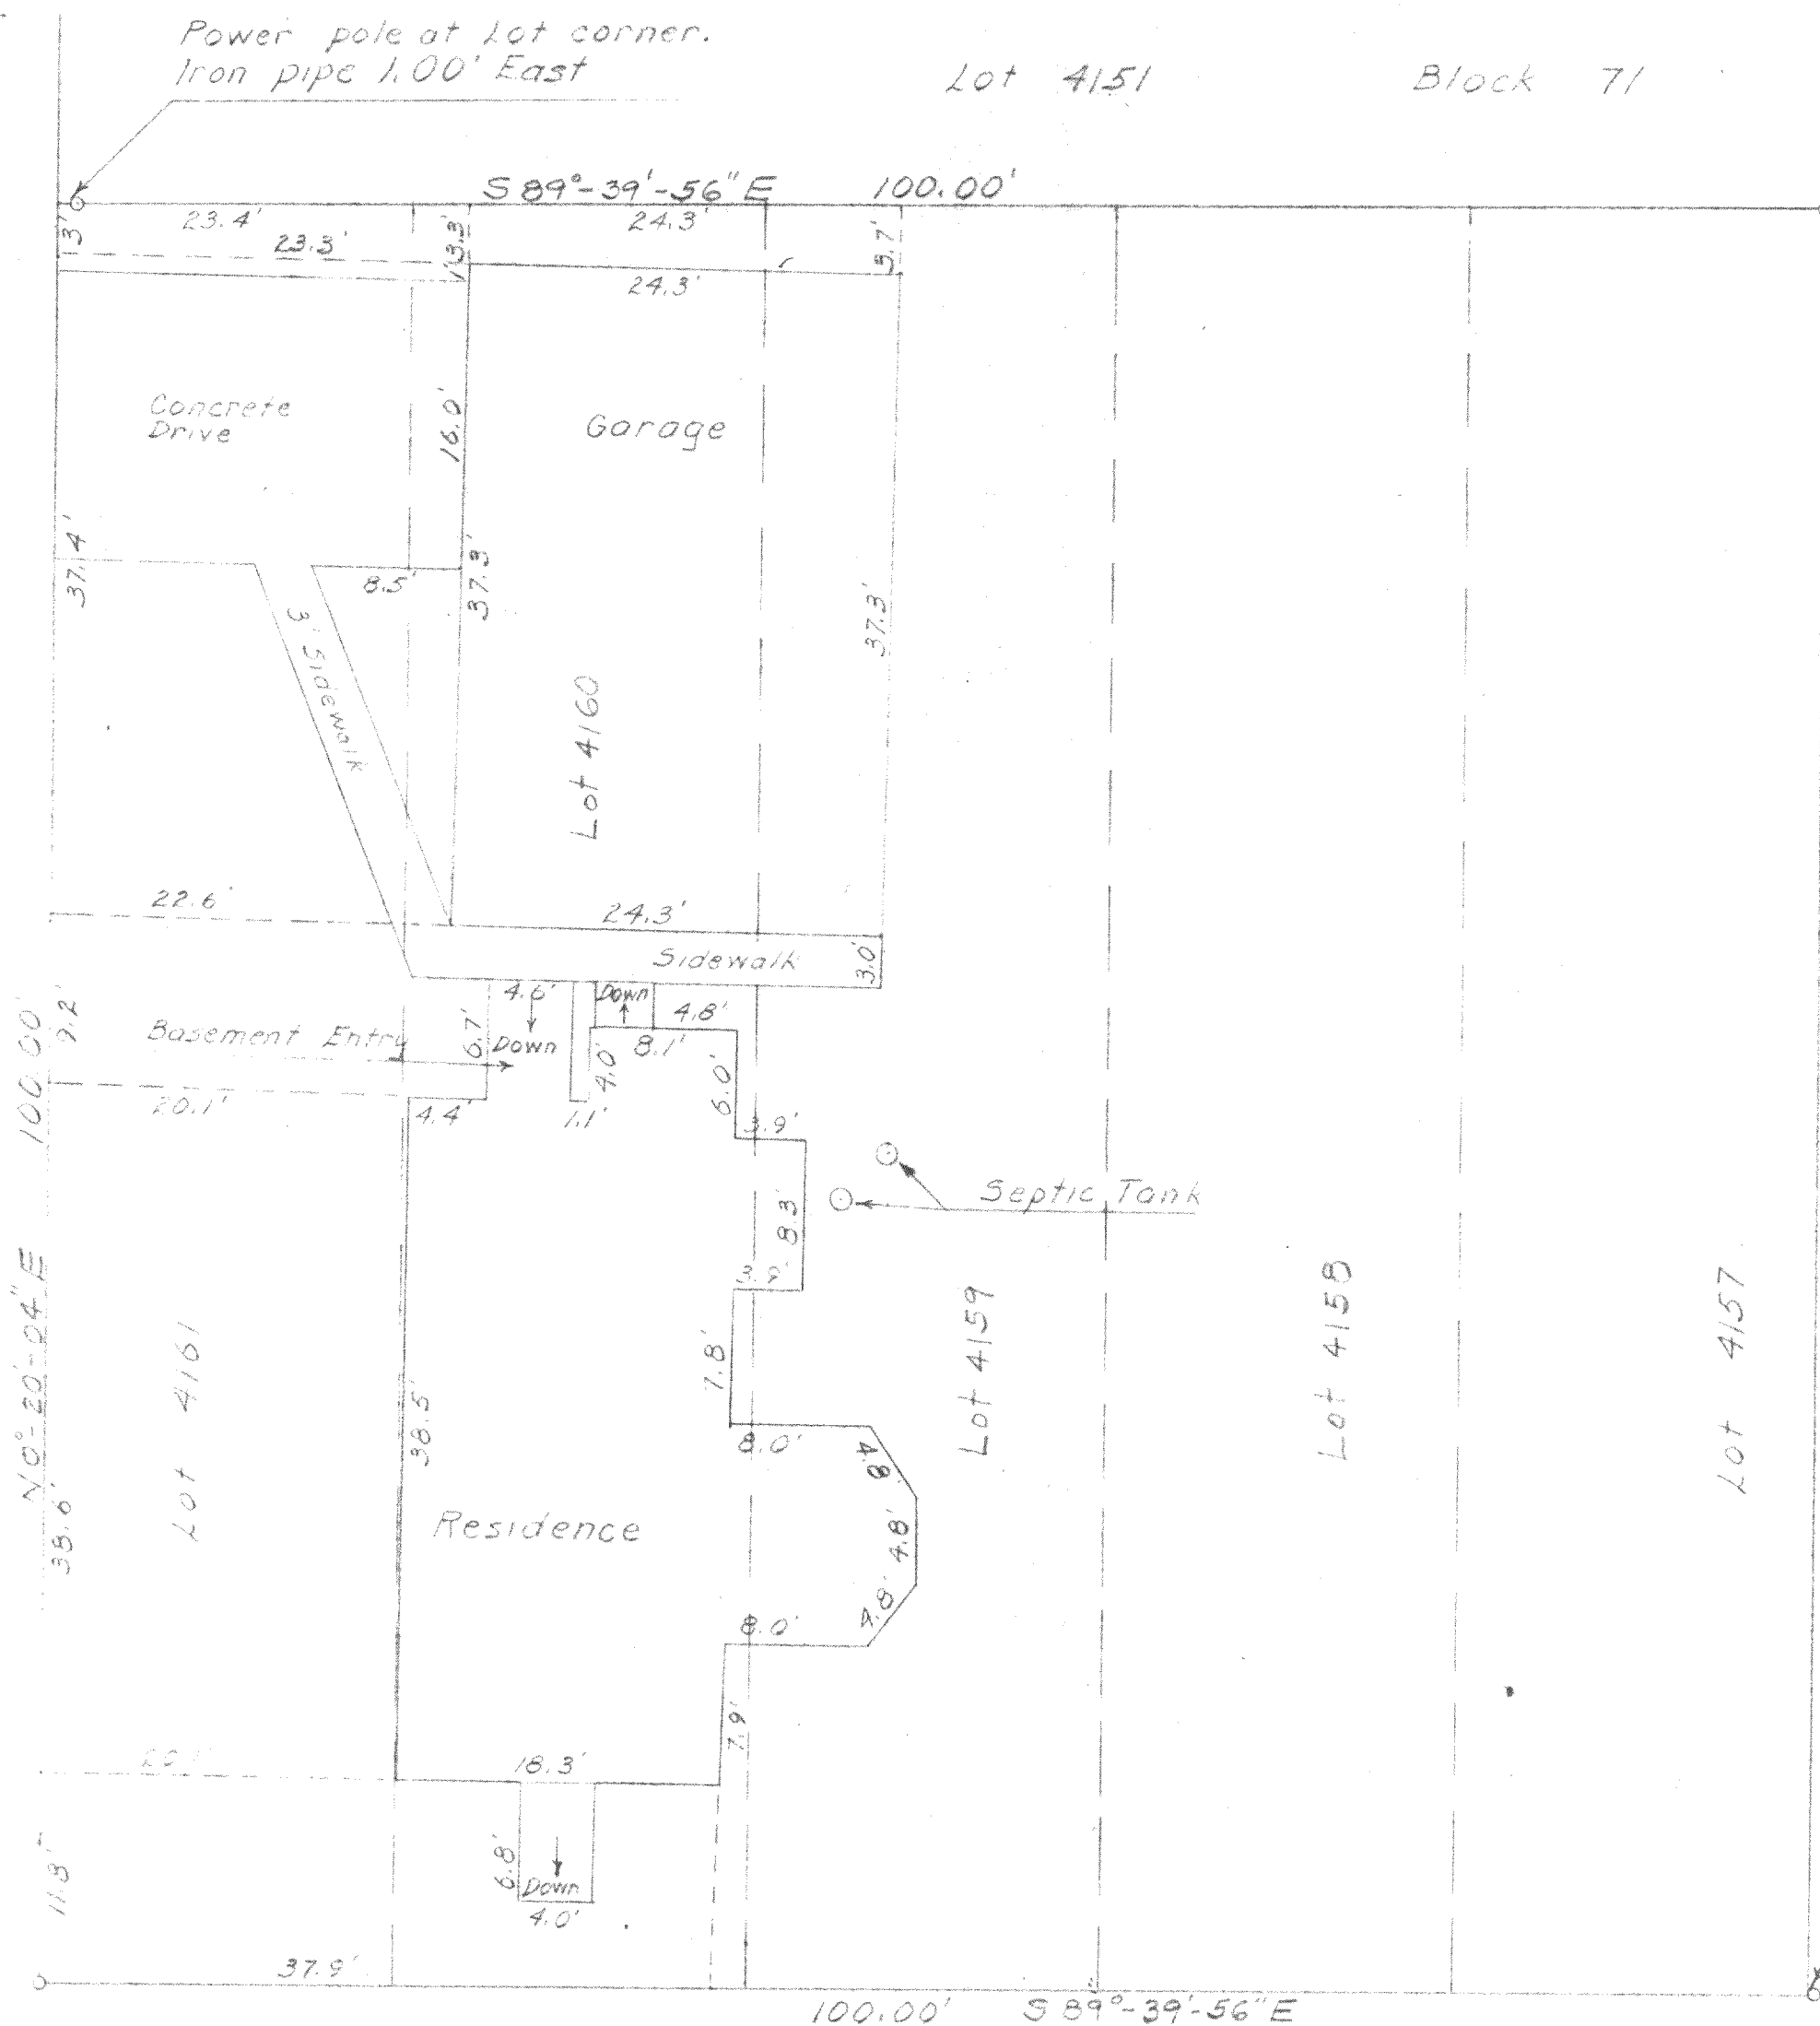

Legend
o - Iron pipe

West side of iron pipe and East side of fence post on Lot corner

I certify that I have surveyed the above described property and that the above plat is an accurate survey and a true representation thereof and correctly shows the exterior boundary lines and location of buildings and other improvements on said property and the correct measurements thereof.

Dated this 2nd day of February, 1961.

Lloyd S. Jensen
Surveyor

PLAT OF SURVEY OF

Lots 4157 to 4161, Block 71, Lake Como Beach, located in the NE 1/4 of Section 27, T2N, R17E, Walworth County, Wisconsin.

Lloyd S. Jensen
SURVEYOR

SCALE 1" = 10'

DATE Feb. 2, 1961

JLB-803