

NOTE: COPIES OF THIS MAP TO WHICH THE FOLLOWING CERTIFICATE WILL APPLY ARE BLUE LINE PRINTS SHOWING THE SURVEYOR'S ORIGINAL SEAL AND SIGNATURE IN BLACK INK. COPIES BY ANY OTHER MEANS MAY SHOW ALTERATIONS WHICH DO NOT REPRESENT THE SURVEYOR'S WORK PRODUCT.




WISCONSIN
ROBERT A.
FARRIS
S 1799
ELKHORN,
WIS.
LAND SURVEYOR

I HEREBY CERTIFY THAT THE PROPERTY DESCRIBED HEREON HAS BEEN SURVEYED UNDER MY DIRECTION AND THAT THIS MAP IS A TRUE REPRESENTATION THEREOF AND SHOWS THE SIZE AND LOCATION OF THE PROPERTY AND ITS EXTERIOR BOUNDARY DIMENSIONS AND MONUMENTS. GROUND CONTOURS ARE SHOWN ENLARGED FROM THE WORK OF OTHERS BASED ON AIR PHOTOGRAPHY PRIOR TO THE CONSTRUCTION OF ROADWAYS AND GOLF COURSES AND PROVIDED TO THE SURVEYOR AT 1 INCH = 100 FEET BUT ARE BASED ON FIELD VERIFICATIONS MADE BY THE UNDERSIGNED SURVEYOR. THIS SURVEY IS MADE FOR THE USE OF THE PRESENT OWNERS OF THE PROPERTY, AND ALSO THOSE WHO PURCHASE, MORTGAGE, OR GUARANTEE THE TITLE THEREIN WITHIN ONE YEAR FROM THE DATE HEREOF.

NOTE: All silt fencing and bale checks shall be maintained in a stable condition fully braced and staked to prevent movement by runoff until a dense turf is established over all disturbed ground surfaces. During or after every storm they shall be checked. Accumulations of silt, topsoil and any other construction debris shall be routinely removed.


AS CONSTRUCTED
FOUNDATION LOC. & DIM
10/11/90

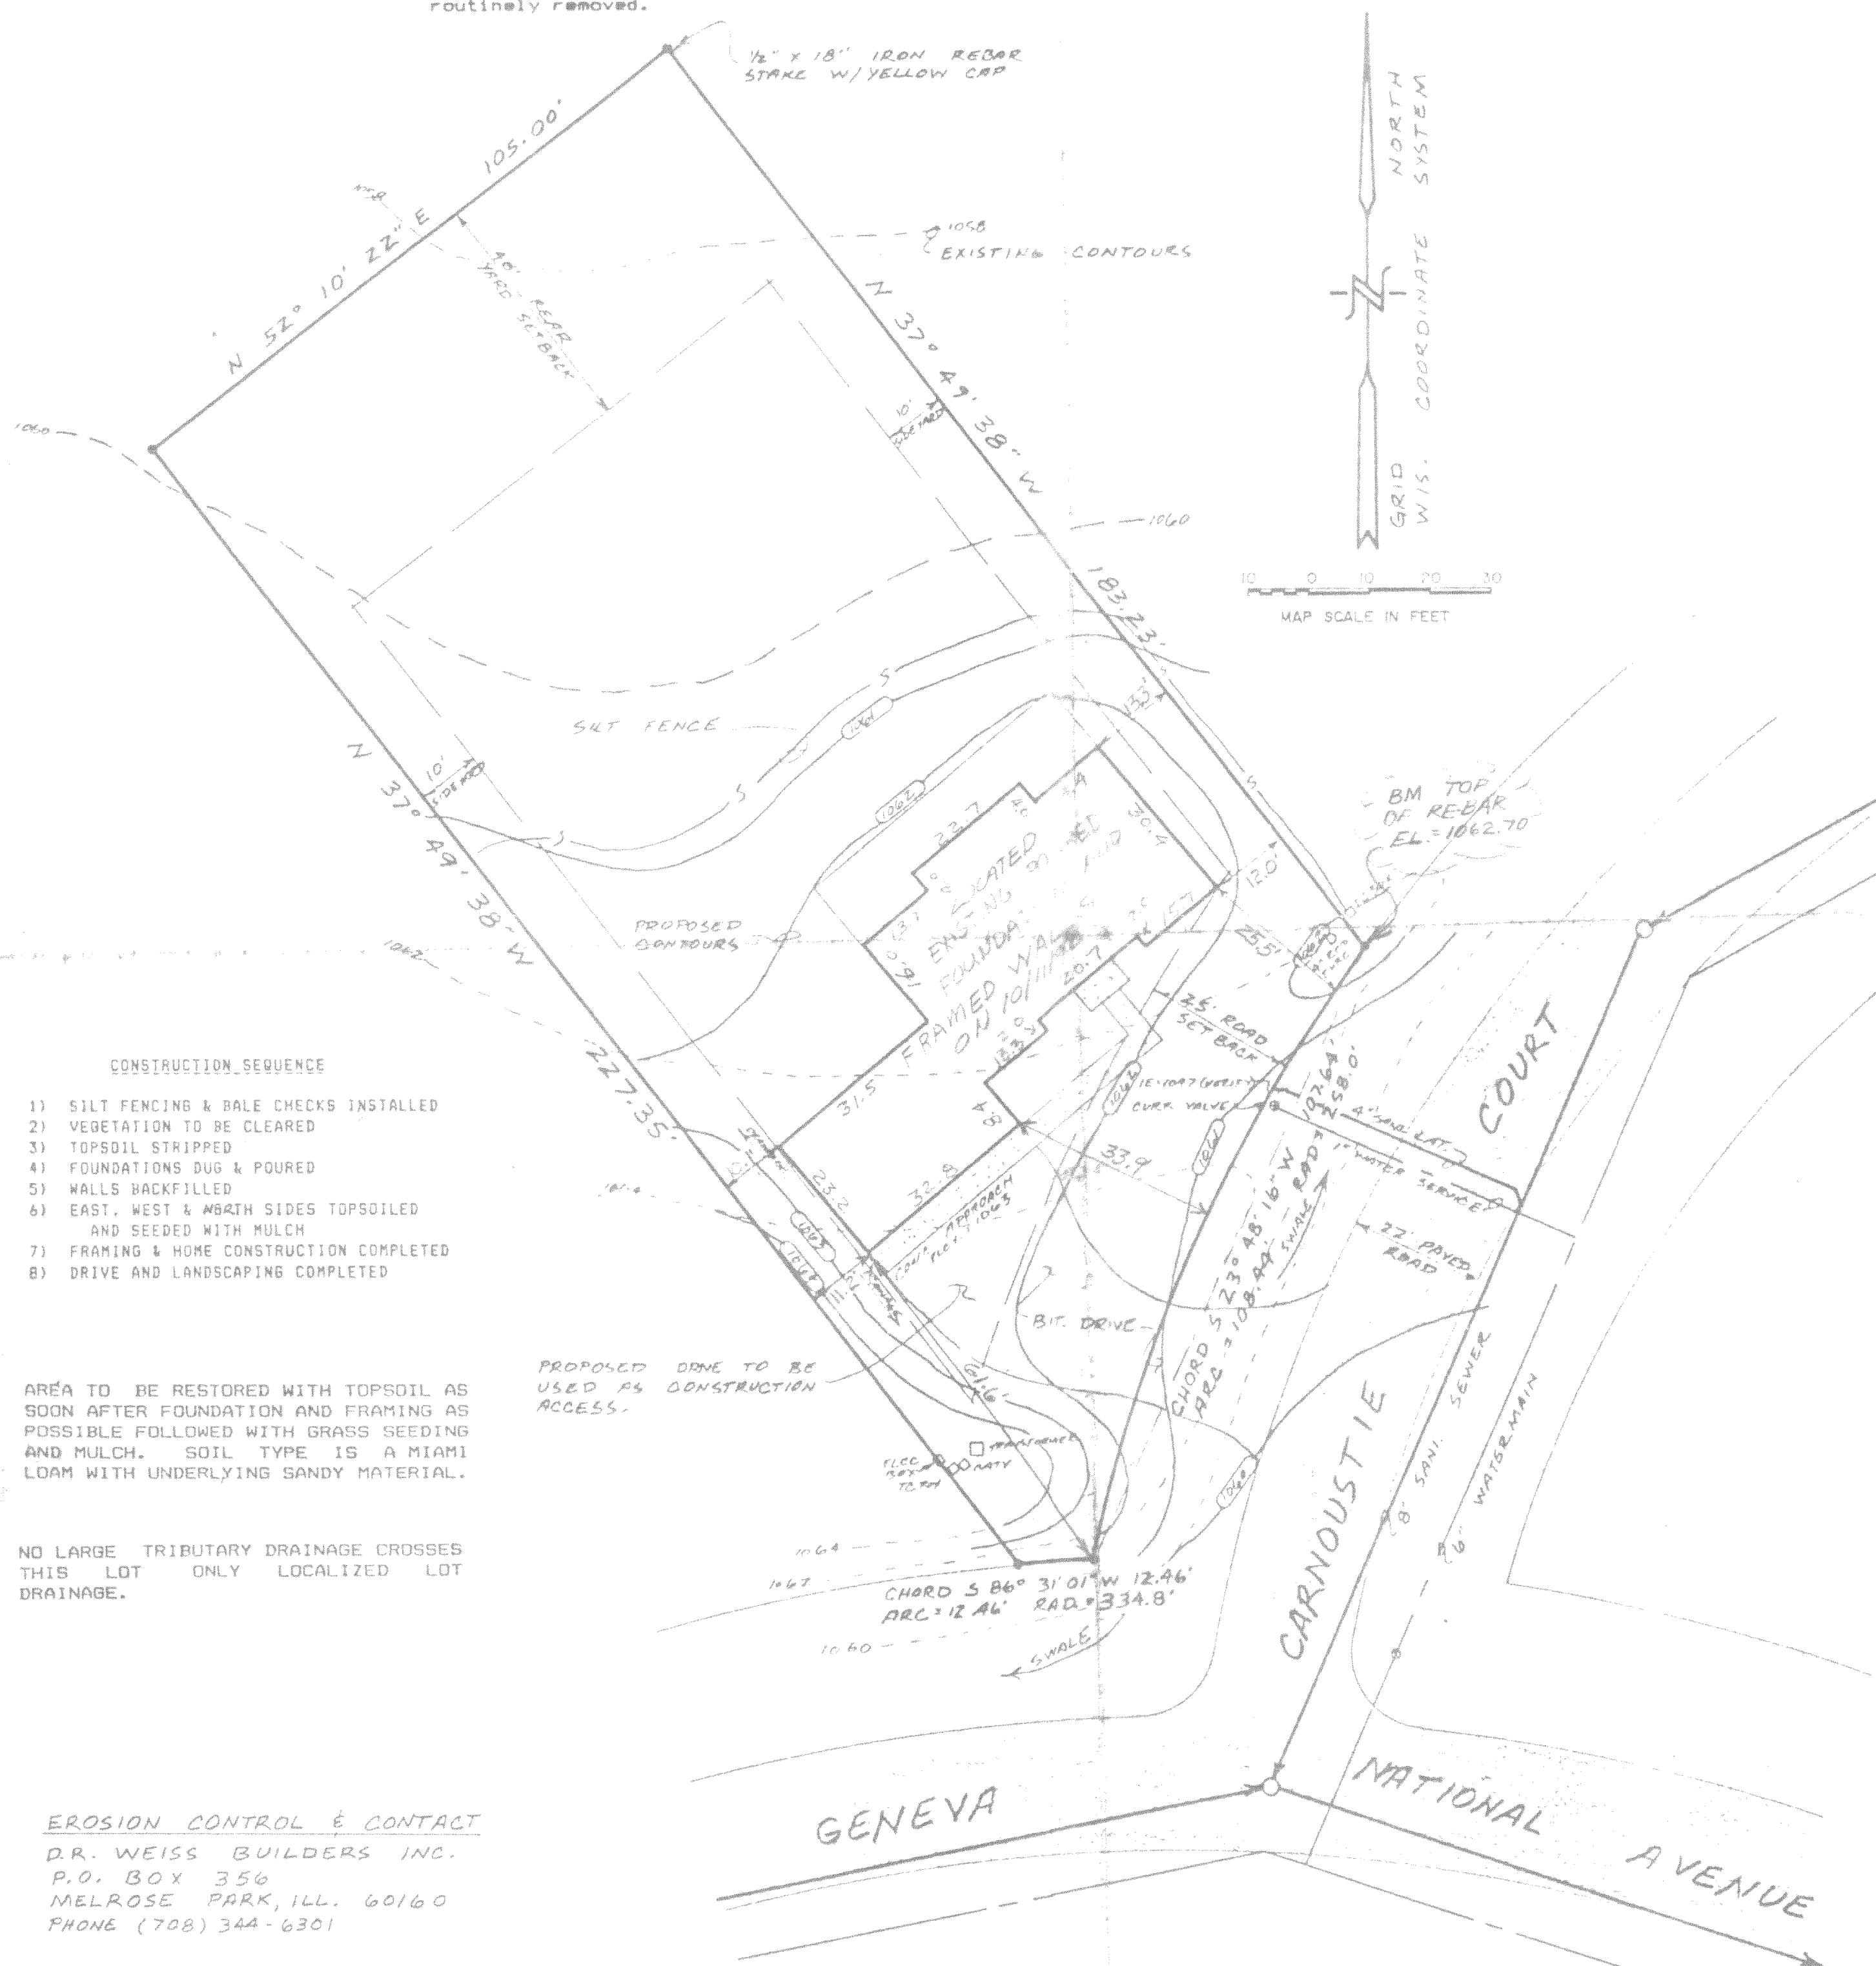


NO LARGE TRIBUTARY DRAINAGE CROSSES
THIS LOT ONLY LOCALIZED LOT
DRAINAGE.

EROSION CONTROL & CONTACT
D.R. WEISS BUILDERS INC.
P.O. BOX 356
MELROSE PARK, ILL. 60160
PHONE (708) 344-6301

SITE GRADING, DRAINAGE & EROSION CONTROL PLAN

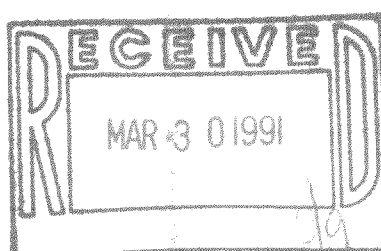

FOUNDATION LOCATION ORDERED 10/04/90 BY DENNIS WEISS
WORK ORDERED BY: D.R. WEISS BUILDERS DATE: 08-10-90

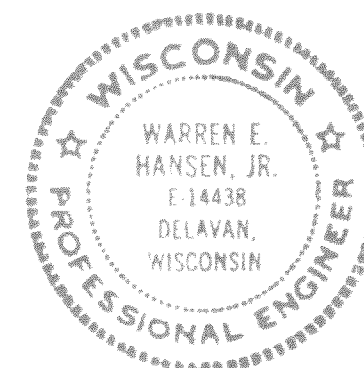

GENEVA NATIONAL
GOLF CLUB



SURVEY
FOR
SINGLE FAMILY UNIT
15-28

FARRIS, HANSEN & ASSOCIATES, INC.
Engineering, Architecture, Surveying
7 Ridgway Court P.O. Box 437
ELKHORN, WISCONSIN 53121
Office: (414) 723-2098
Fax: (414) 723-5886

REVISIONS
FOUNDATION LOC.
10/11/90

PROJECT NO
3269
DATE
08/15/90
SHEET NO
1 of 1

JGN 15* M:50