

Plat of Survey

The within use plat of land containing 1.42 acres, situated in the
Township 14 N, Range 12 W, Section 17 East, Town of
Beech, Walworth County, Wisconsin, is hereby plat.

Surveyed by Thomas P. A. Jensen, Registered Land Surveyor,
Wisconsin, License No. 4117,
and approved by Walworth County, Wisconsin.

Boundaries are assumed.

Excluded: 1.42 acres, 1.42 acres, 1.42 acres,
All other land, 1.42 acres, 1.42 acres.



Copyright © 1990 by Jensen Surveying & Mapping S.C.
All rights reserved. No part of this survey plat may be reproduced or transmitted in any form
by any means - graphic, electronic, or mechanical, including photocopying, tracing, or information
storage and retrieval systems - without permission in writing from Thomas P. A. Jensen.

I, Thomas P. A. Jensen, Wisconsin Registered Land Surveyor, do hereby certify that this
survey was performed by me, or under my direction, in full compliance with the owner's agent's
instructions and Chapter A.E. of the Wisconsin Administrative Code Minimum Standards For
Property Surveys, and that this map is an accurate representation thereof to the best of my
knowledge and belief.

Note: This survey plat is not
certified unless signed
and sealed in red ink.

Thomas P. A. Jensen, R.L.S., 1084

Legend:

- Surveyed boundary
- Unsurveyed boundary
- Easement boundary
- Right-of-way boundary
- Other boundary



Jensen Surveying & Mapping S.C.

4500 W. Wisconsin Street, Suite 302, Box 302
Beech, Wisconsin 53111
414-223-4334

Map No. 1084, Sheet 3, 1990
Rev. 10/90

Scale: 1" = 40'

Sheet 1 of 2 Sheets
Job reference number:
1990-1647

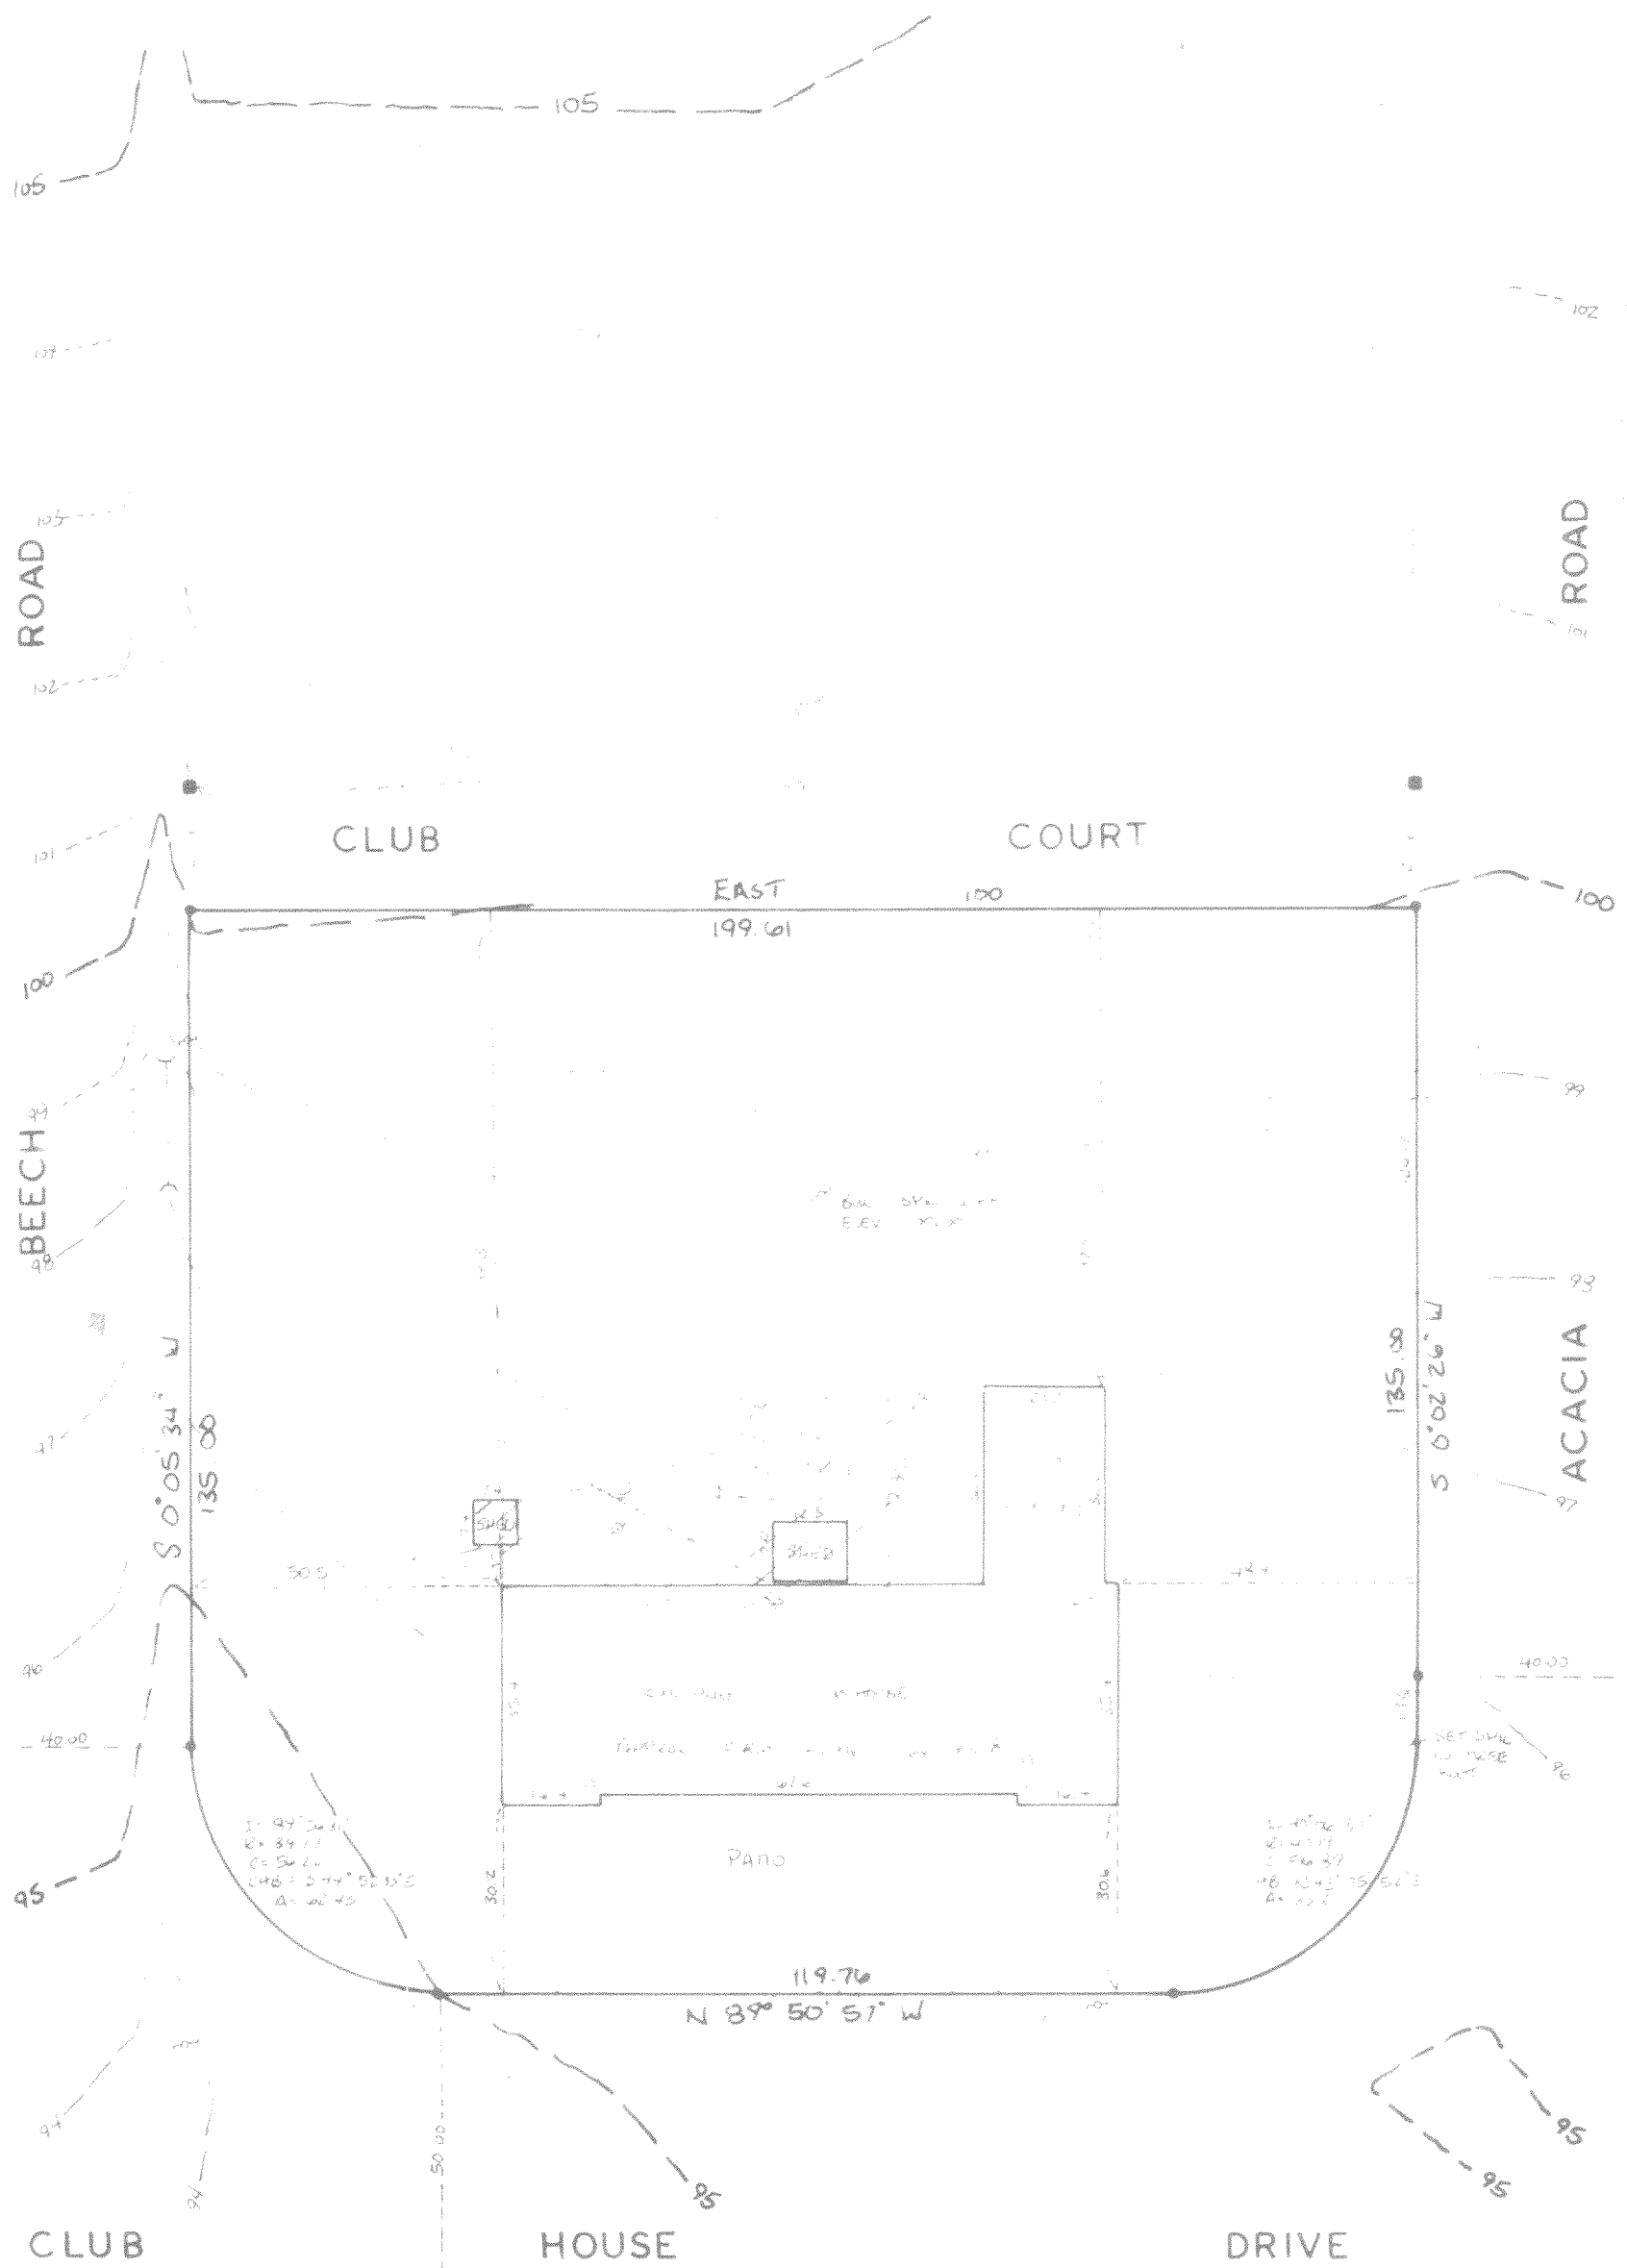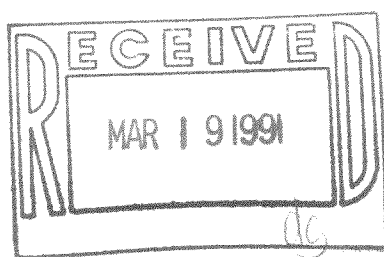

217-923

JICB 02822