


815 648-2715

WANAGAS SURVEYING
P.O. BOX 572 HEBRON ILLINOIS 60034
PLAT OF SURVEY

WORK ORDER NO. 910713-14

SHEET 1 OF 1

SCALE 1" = 30'

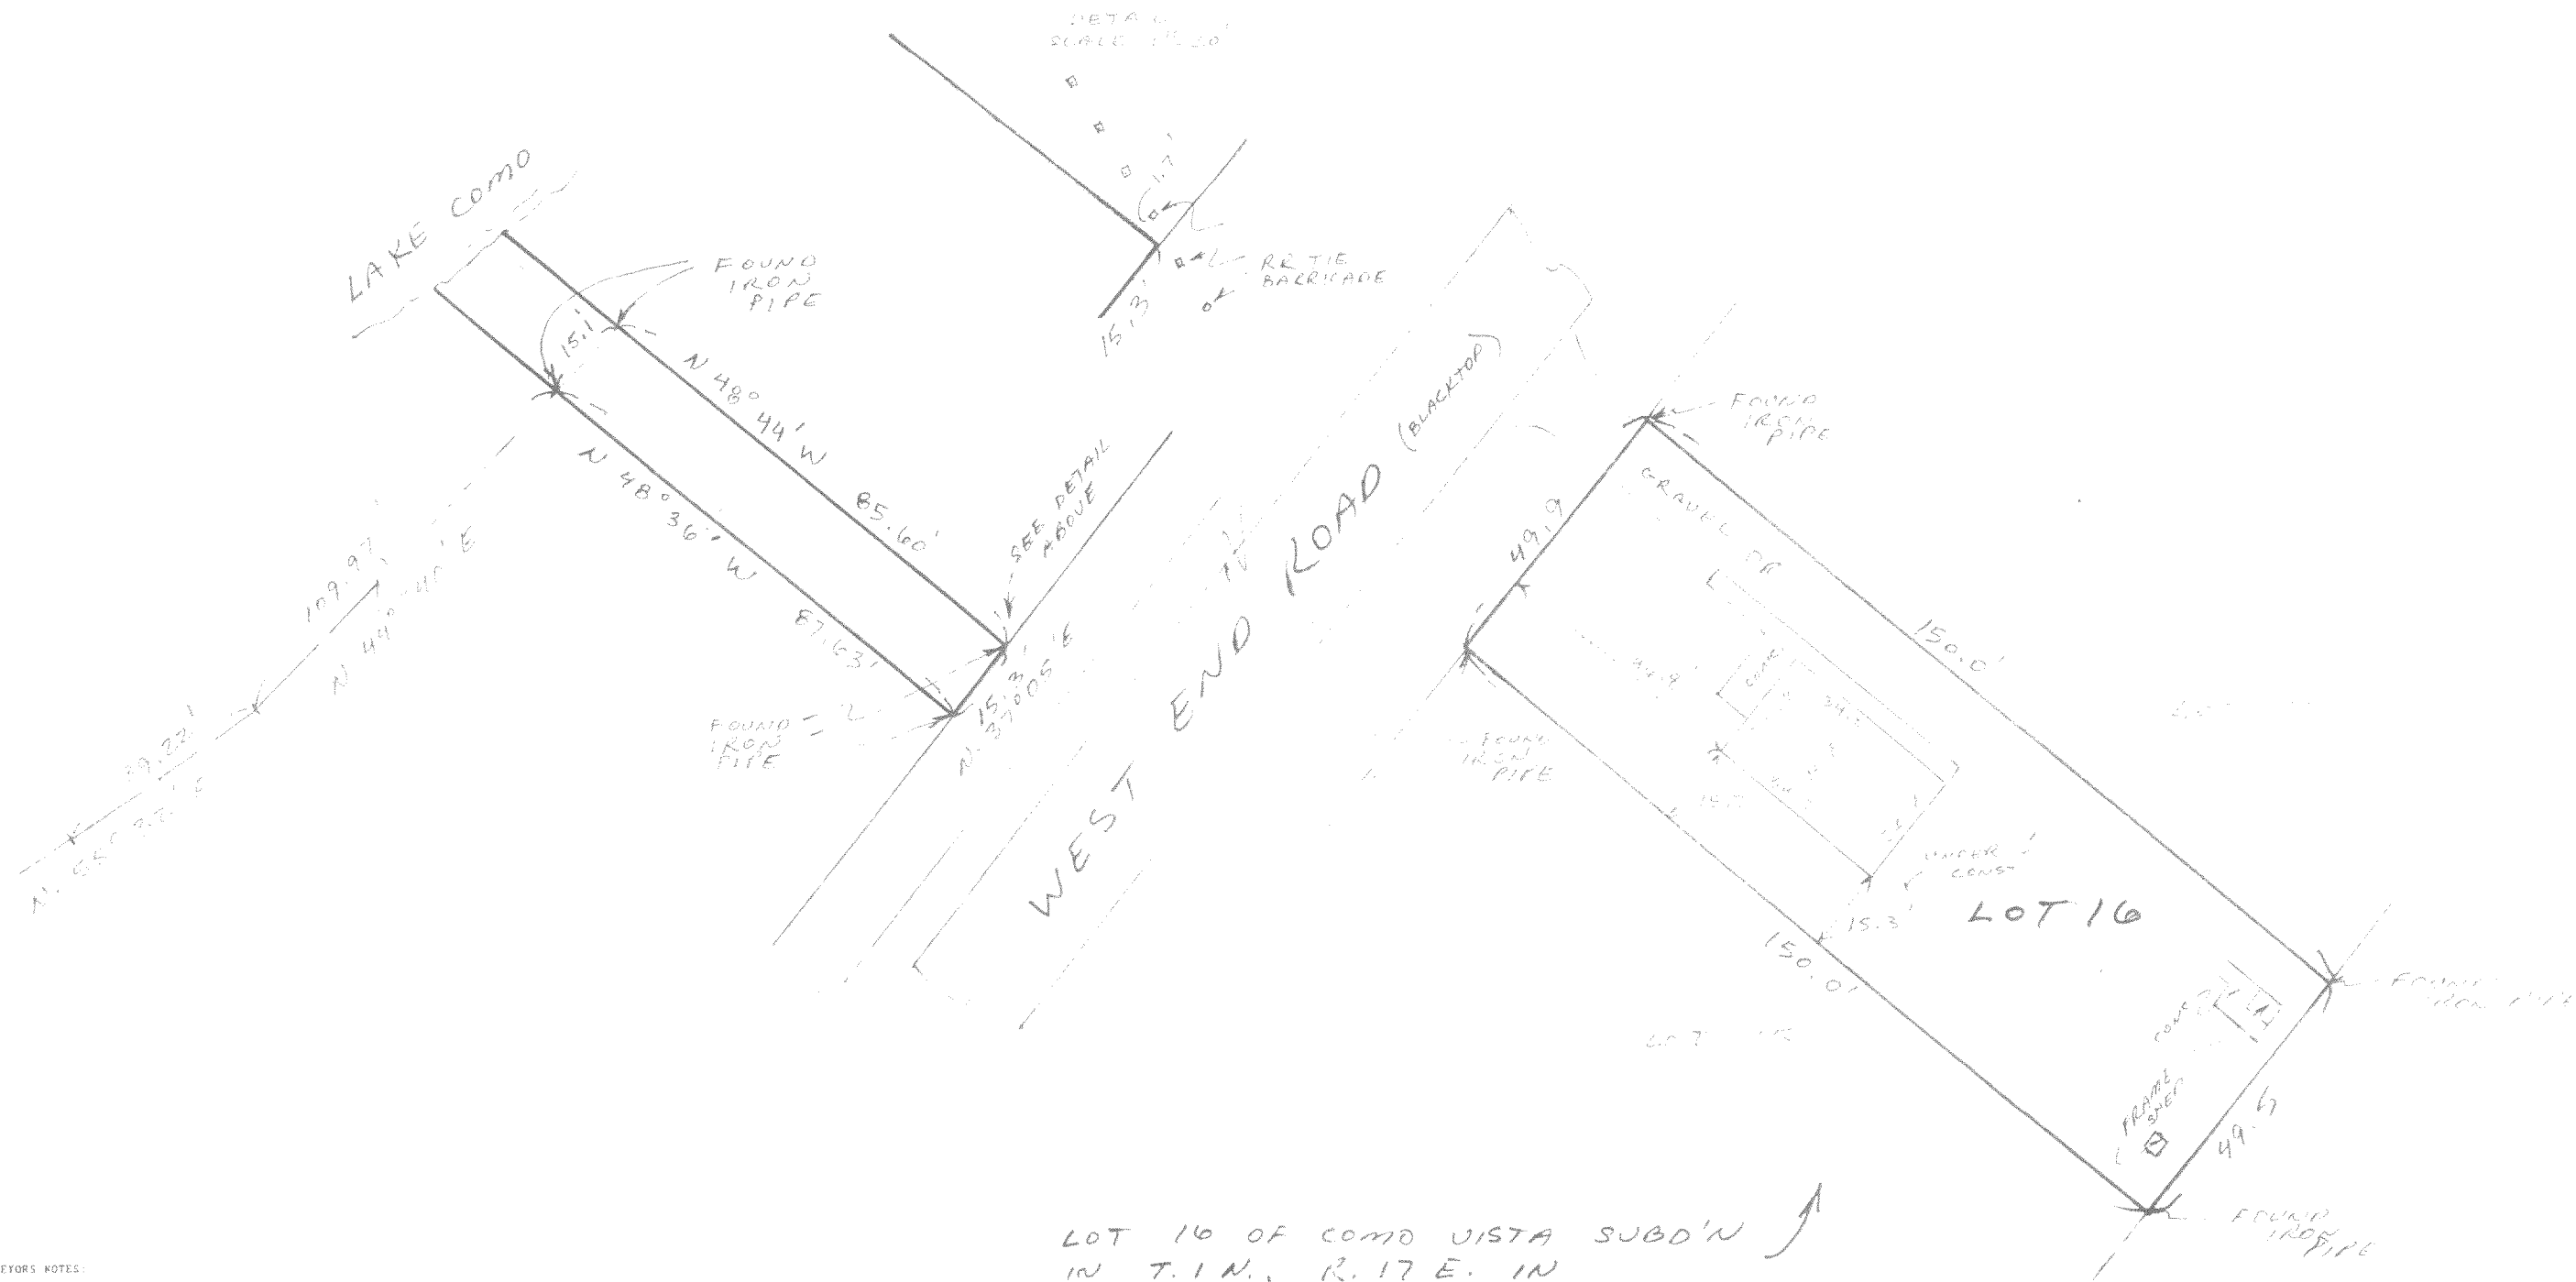


LOT 16 OF COMO VISTA SUBD'N
IN T.1N., R.17E. IN
WALWORTH CO., WISCONSIN.

SURVEYOR'S NOTES:

- * EXCEPT AS SPECIFICALLY STATED OR SHOWN ON THIS PLAT, THIS SURVEY DOES NOT PURPORT TO REFLECT ANY OF THE FOLLOWING WHICH MAY BE APPLICABLE TO THE SUBJECT PROPERTY: EASEMENTS OTHER THAN POSSIBLE EASEMENTS WHICH WERE READILY VISIBLE AT THE TIME THE SURVEY WAS MADE; BUILDING SETBACK LINES; RESTRICTIVE COVENANTS; SUBDIVISION RESTRICTIONS; ZONING OR OTHER LAND USE REGULATIONS, AND ANY OTHER FACTS WHICH AN ACCURATE AND CURRENT TITLE SEARCH MAY DISCLOSE
- * SURVEY IS VALID ONLY IF PRINT HAS EMBOSSED SEAL ON IT.
- * NO STATEMENT IS MADE CONCERNING SUBSURFACE CONDITIONS, OR THE EXISTENCE OF UNDERGROUND OR OVERHEAD CONTAINERS OR FACILITIES WHICH MAY AFFECT THE USE OR DEVELOPMENT OF THIS TRACT.
- * THE DOCUMENTS OF RECORD WHICH WERE REVIEWED AND CONSIDERED AS PART OF THIS SURVEY ARE NOTED HEREON. ONLY DOCUMENTS NOTED HEREON WERE SUPPLIED TO THE SURVEYOR.
- * ON RECEIPT OF THIS SURVEY AND YOUR INSPECTION OF THE SURVEY MARKERS, REPORT ANY APPARENT DISCREPANCY TO THE SURVEYOR IMMEDIATELY.

SURVEYED FOR
JANIE CARSON
PO BOX 335
LAKE GEORGE, MN.

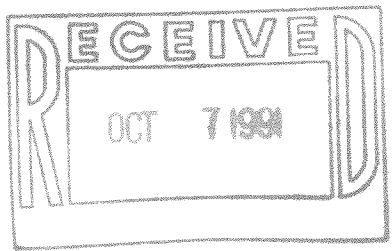

STATE OF ILLINOIS)
COUNTY OF MCHEERY)

I HEREBY STATE THAT I HAVE SURVEYED THE PROPERTY DESCRIBED HEREON AS SHOWN AND NOTED ON THE PLAT HEREON DRAWN

DATE 08-14-91
Kenneth B. Wanagas
KENNETH B. WANAGAS
PROFESSIONAL LAND SURVEYOR
ILLINOIS NO 7432 WISCONSIN NO 3420

217-424

50cm 08/13