


ABELL
SURVEYING & MAPPING

DELAVAN, WISCONSIN 53115

414-728-6737

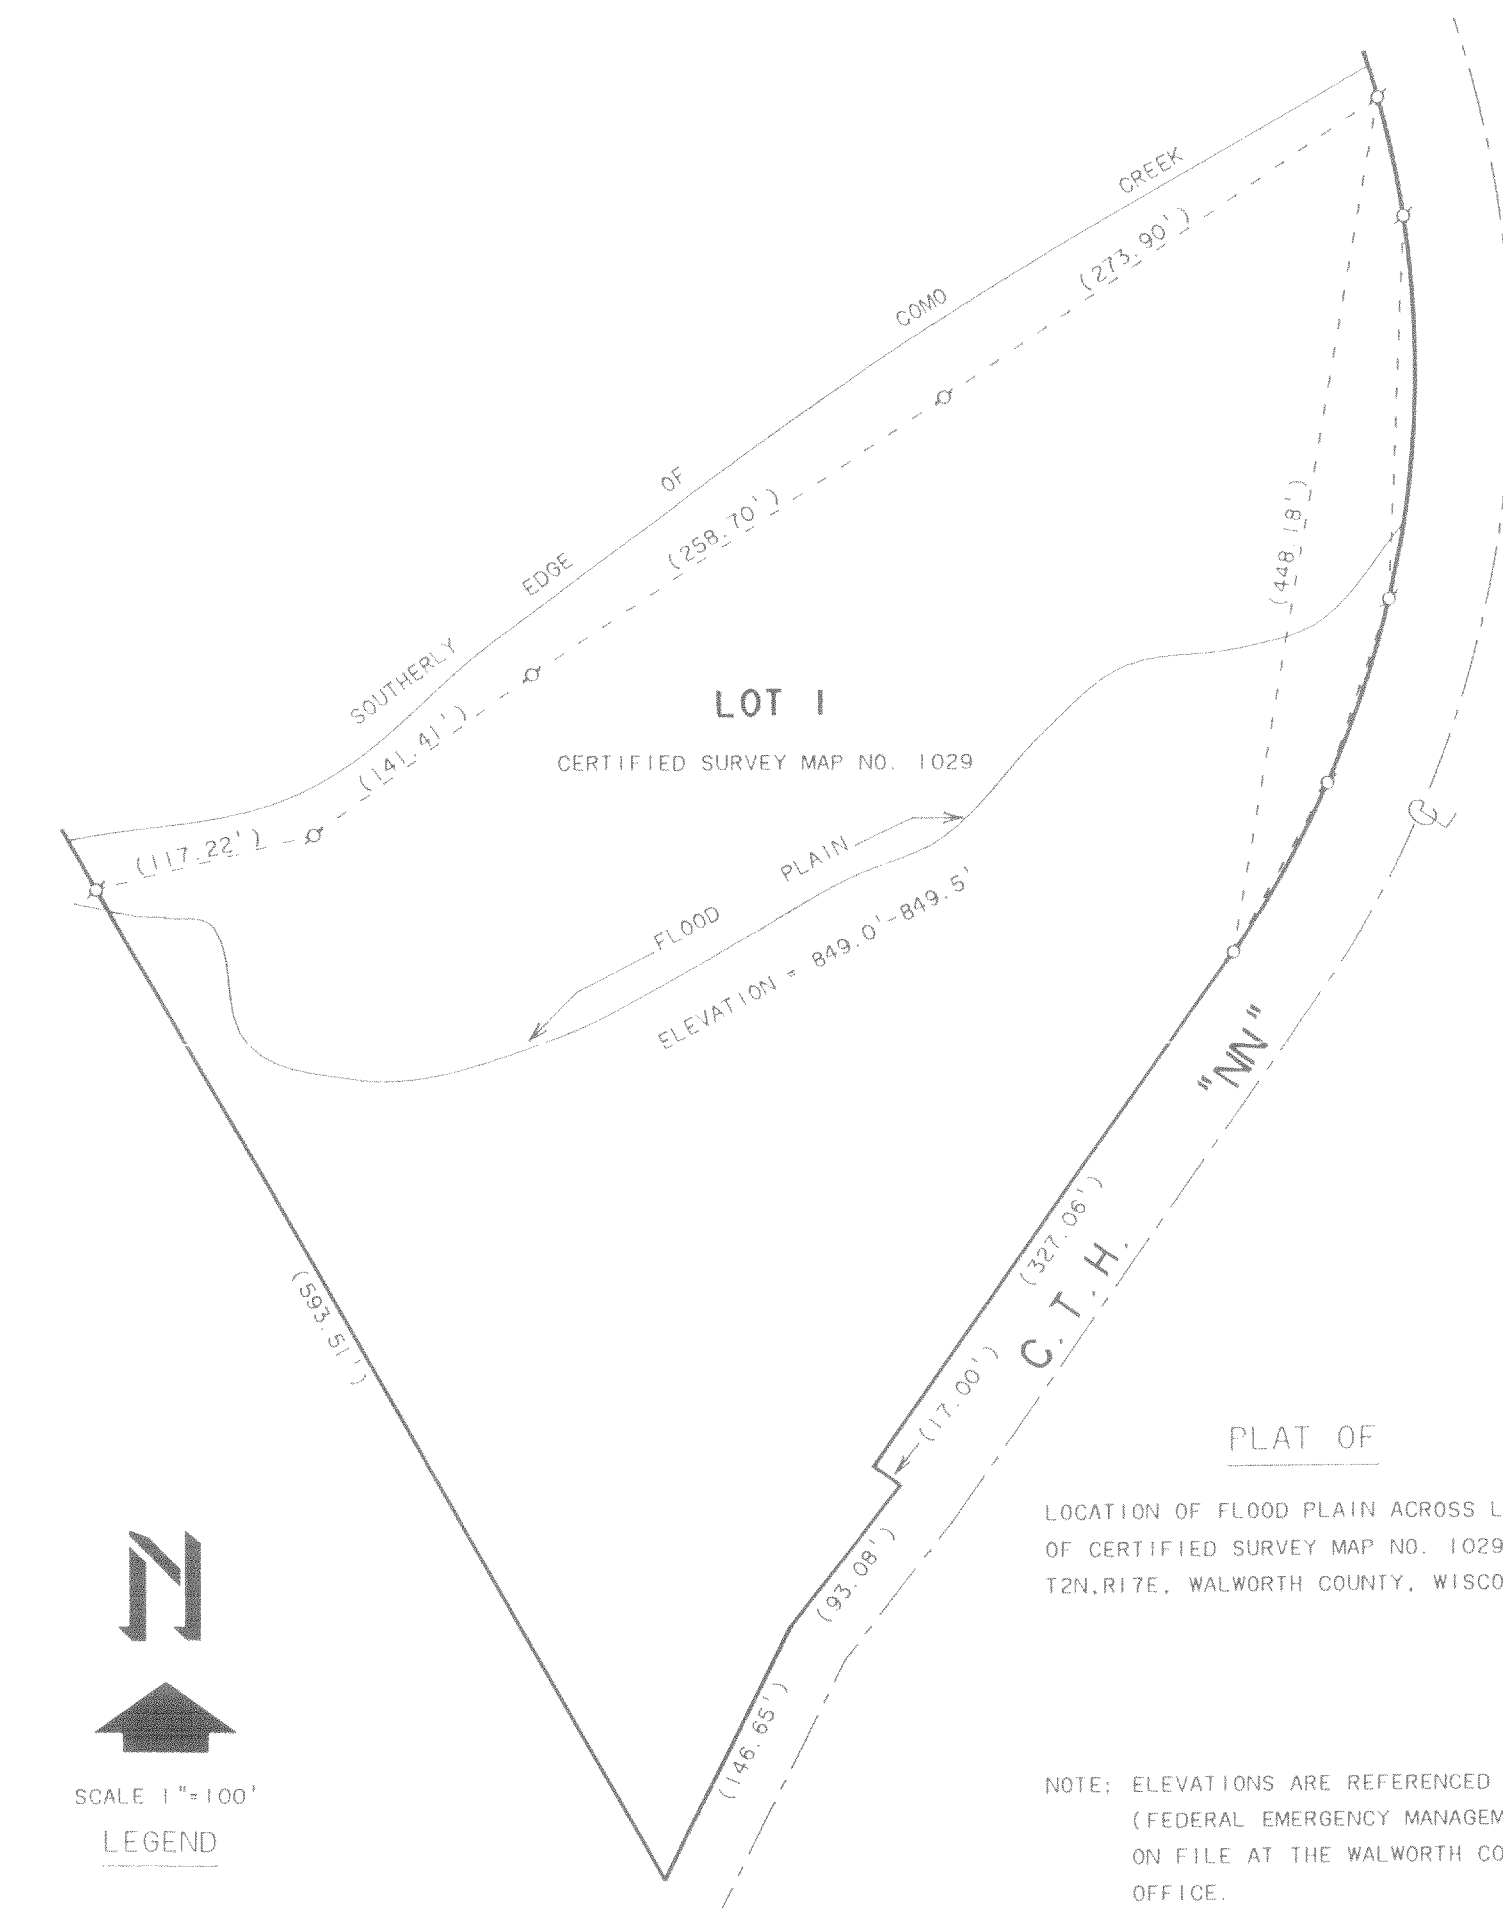


⊗ - IRON PIPE FOUND
() - RECORDED AS

PLAT OF
LOCATION OF FLOOD PLAIN ACROSS LOT 1,
OF CERTIFIED SURVEY MAP NO. 1029,
T2N, R17E, WALWORTH COUNTY, WISCONSIN.

NOTE: ELEVATIONS ARE REFERENCED TO FEMA MAPS
(FEDERAL EMERGENCY MANAGEMENT AGENCY)
ON FILE AT THE WALWORTH COUNTY ZONING
OFFICE.

ORDERED BY: BRYAN GIBSON
RT. 5 BOX 705
LAKE GENEVA, WI. 53147

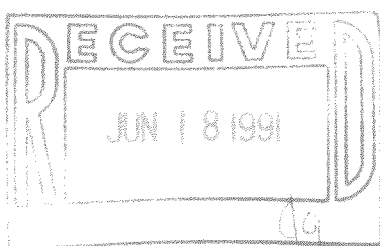

David F. Abell
DAVID F. ABELL
WISCONSIN REGISTERED LAND SURVEYOR, S-1596

March 8, 1991
DATE JOB NUMBER - 91003

217-6141

JA 102514/1991