
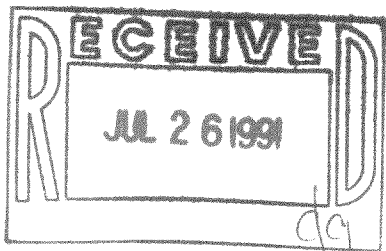


PLAT OF SURVEY OF LOT 11 OF
INDIAN ECHO ESTATES LOC. IN
SEC. 34, TOWN OF GENEVA,
WALWORTH COUNTY, WIS.
FOR
BUYER: CROWELL
SELLER: GIBSON

Legend

- = IRON ROD STAKE FOUND 6/24/91
- = IRON PIPE STAKE FOUND 6/24/91
- = UTILITY POLE
- = SUBSTANTIAL FENCE
- = OVERHEAD WIRES
- = LEGAL CENTERLINE
- (xxx) = ORIG. SUB. PLAT DIMENSION

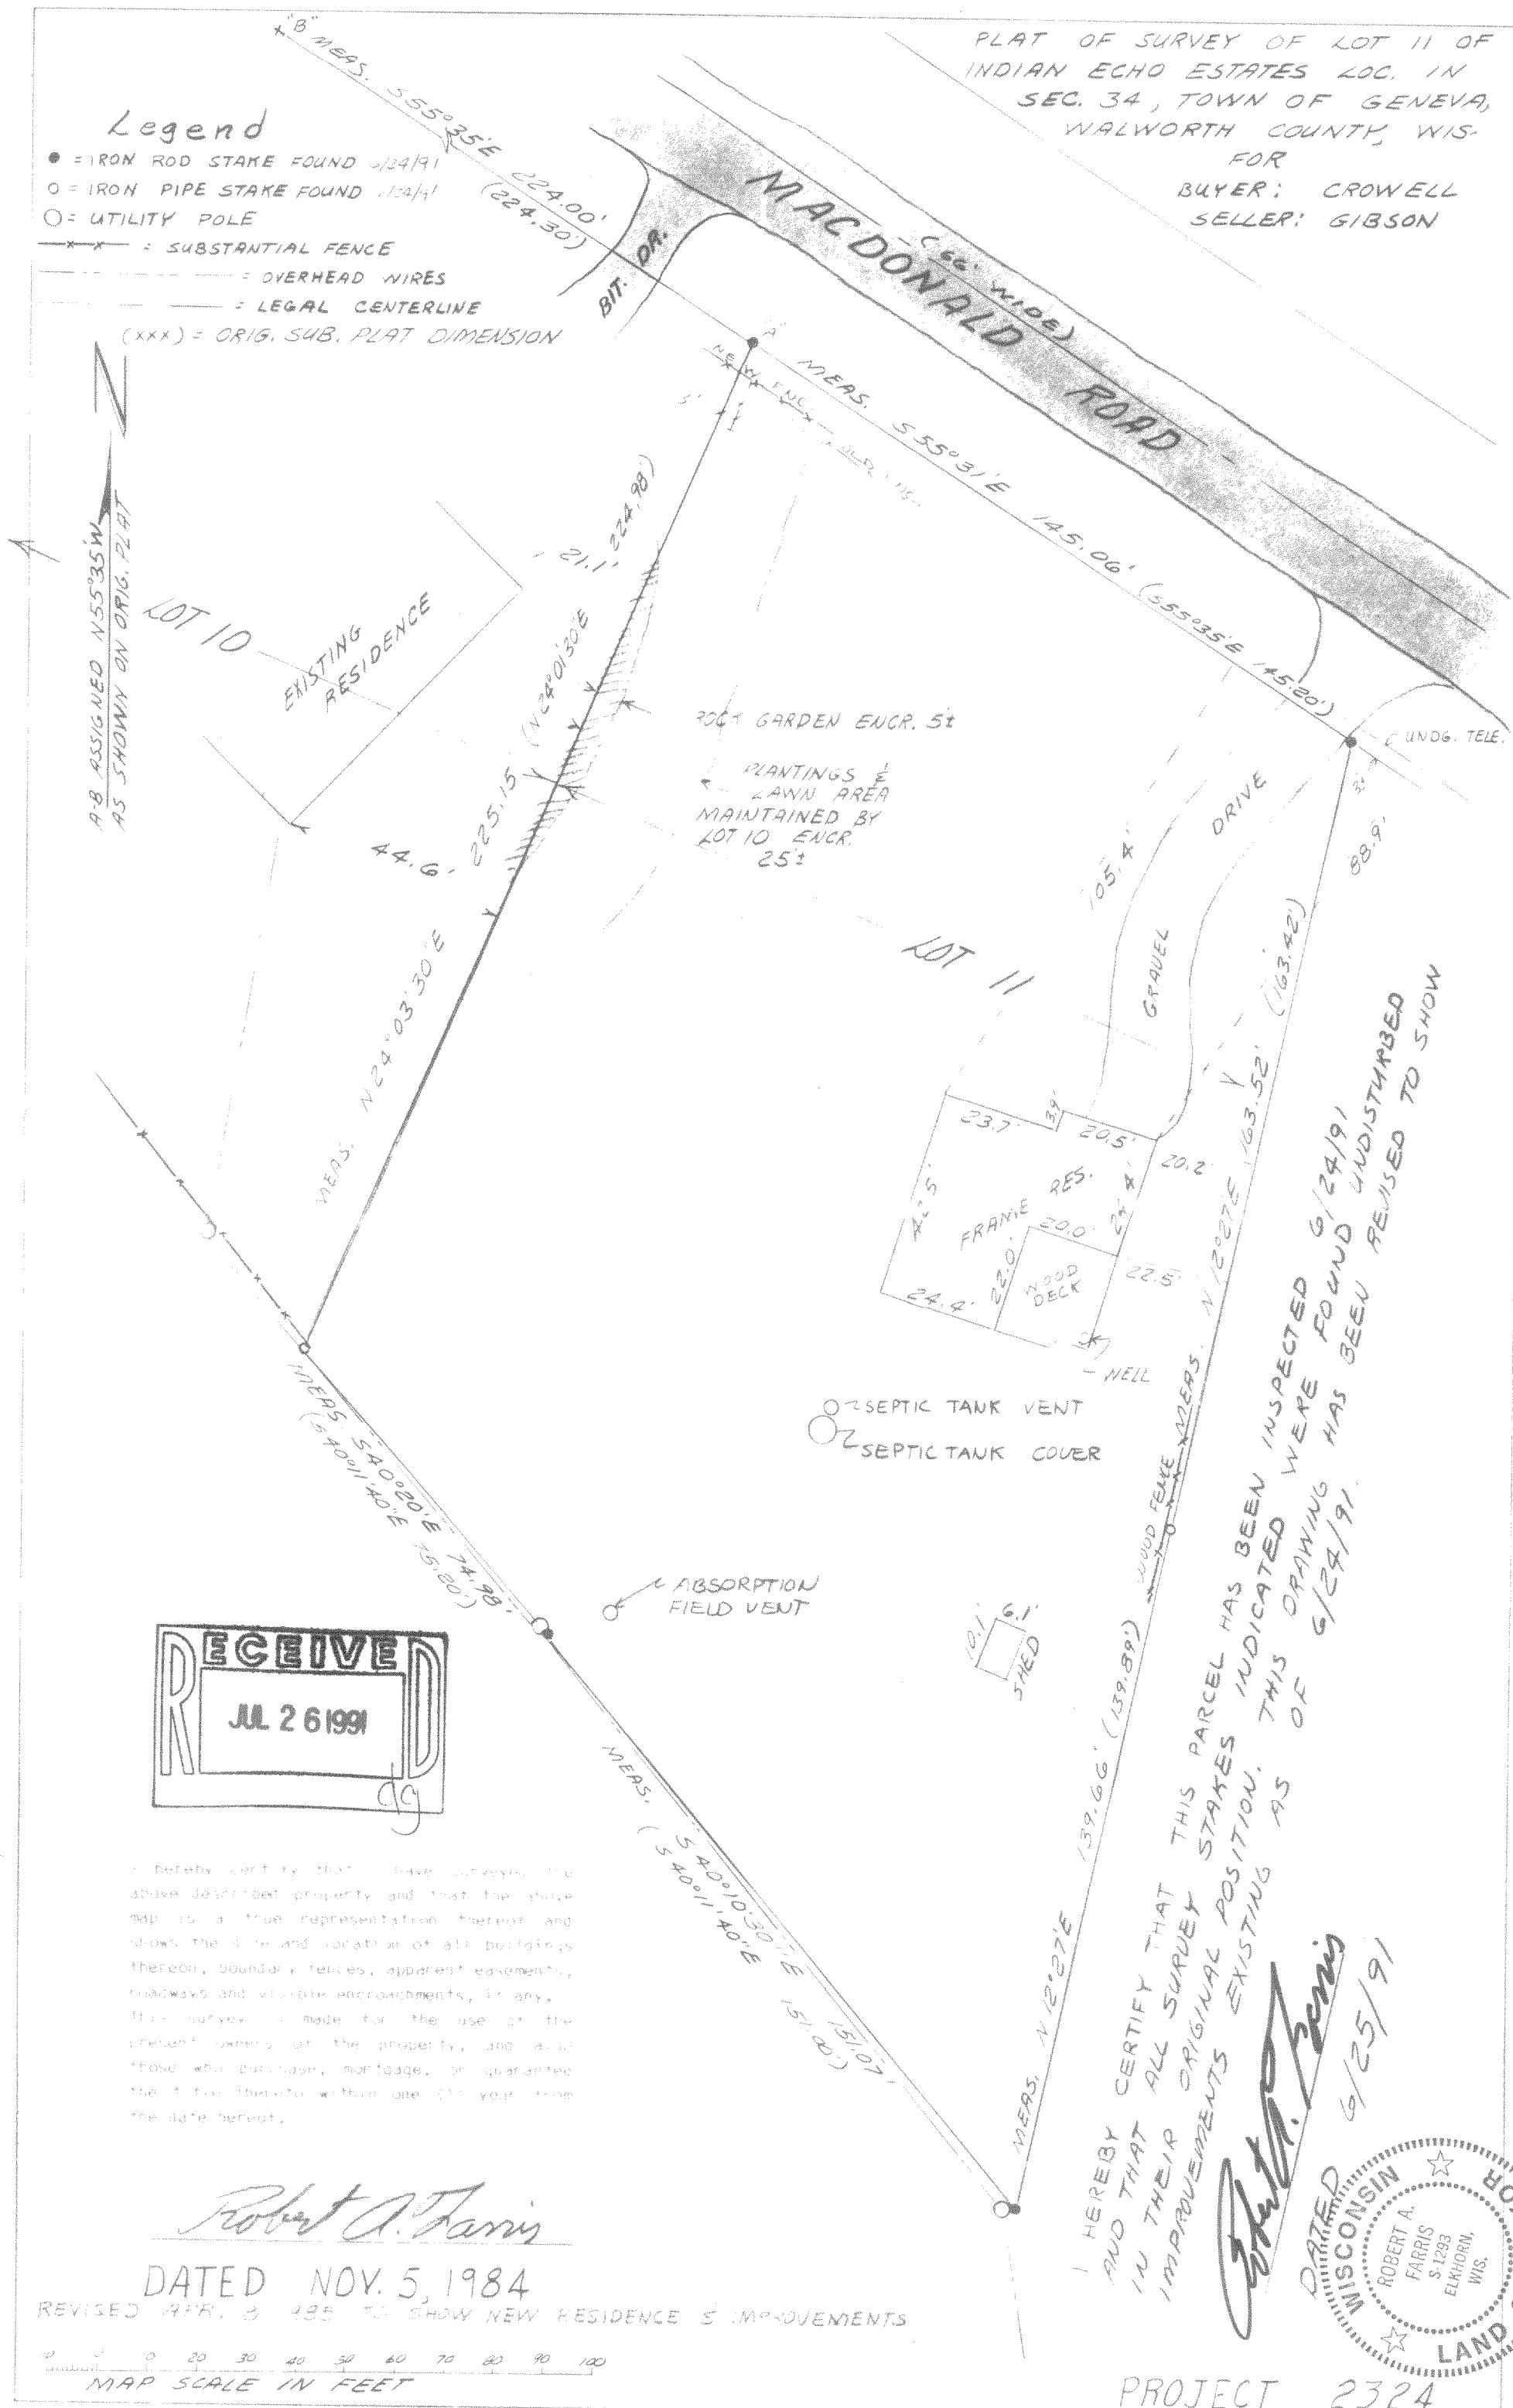

I hereby certify that I have surveyed the above described property and that the above map is a true representation thereof and shows the size and location of all buildings thereon, boundary fences, apparent easements, roadways and visible encroachments, if any. This survey was made for the use of the present owners of the property, and as to those who purchase, mortgage, or guarantee the title thereto within one (1) year from the date hereof.

Robert A. Farris


DATED NOV. 5, 1984

REVISED APR. 8, 1985 TO SHOW NEW RESIDENCE & IMPROVEMENTS

0 10 20 30 40 50 60 70 80 90 100
MAP SCALE IN FEET

I HEREBY CERTIFY THAT THIS PARCEL HAS BEEN INSPECTED 6/24/91 AND THAT ALL SURVEY STAKES INDICATED IN THEIR ORIGINAL POSITION. THIS DRAWING WAS FOUND UNDISTURBED. IMPROVEMENTS EXISTING AS OF 6/24/91. THIS DRAWING HAS BEEN REVISED TO SHOW

Robert A. Farris

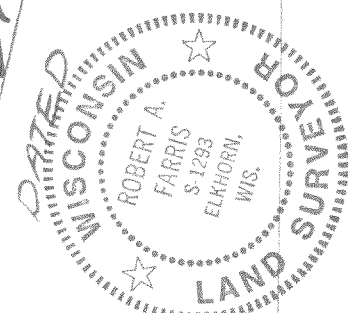

PROJECT 2324

217-942

JEE. 00011