
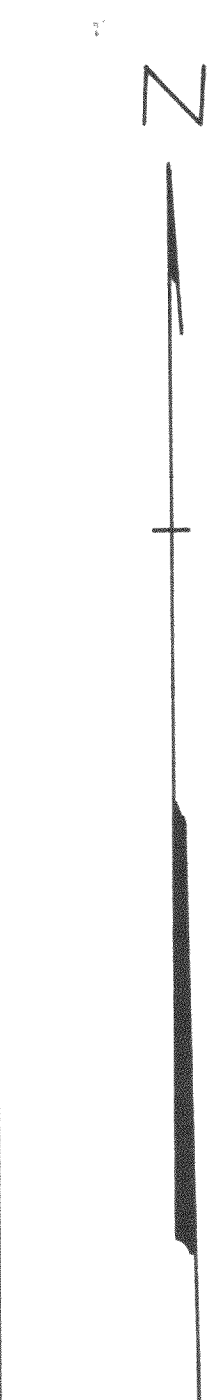


GEORGE T. DUNHAM  
SURVEYING & SUBDIVIDING  
DELAVER, WISCONSIN

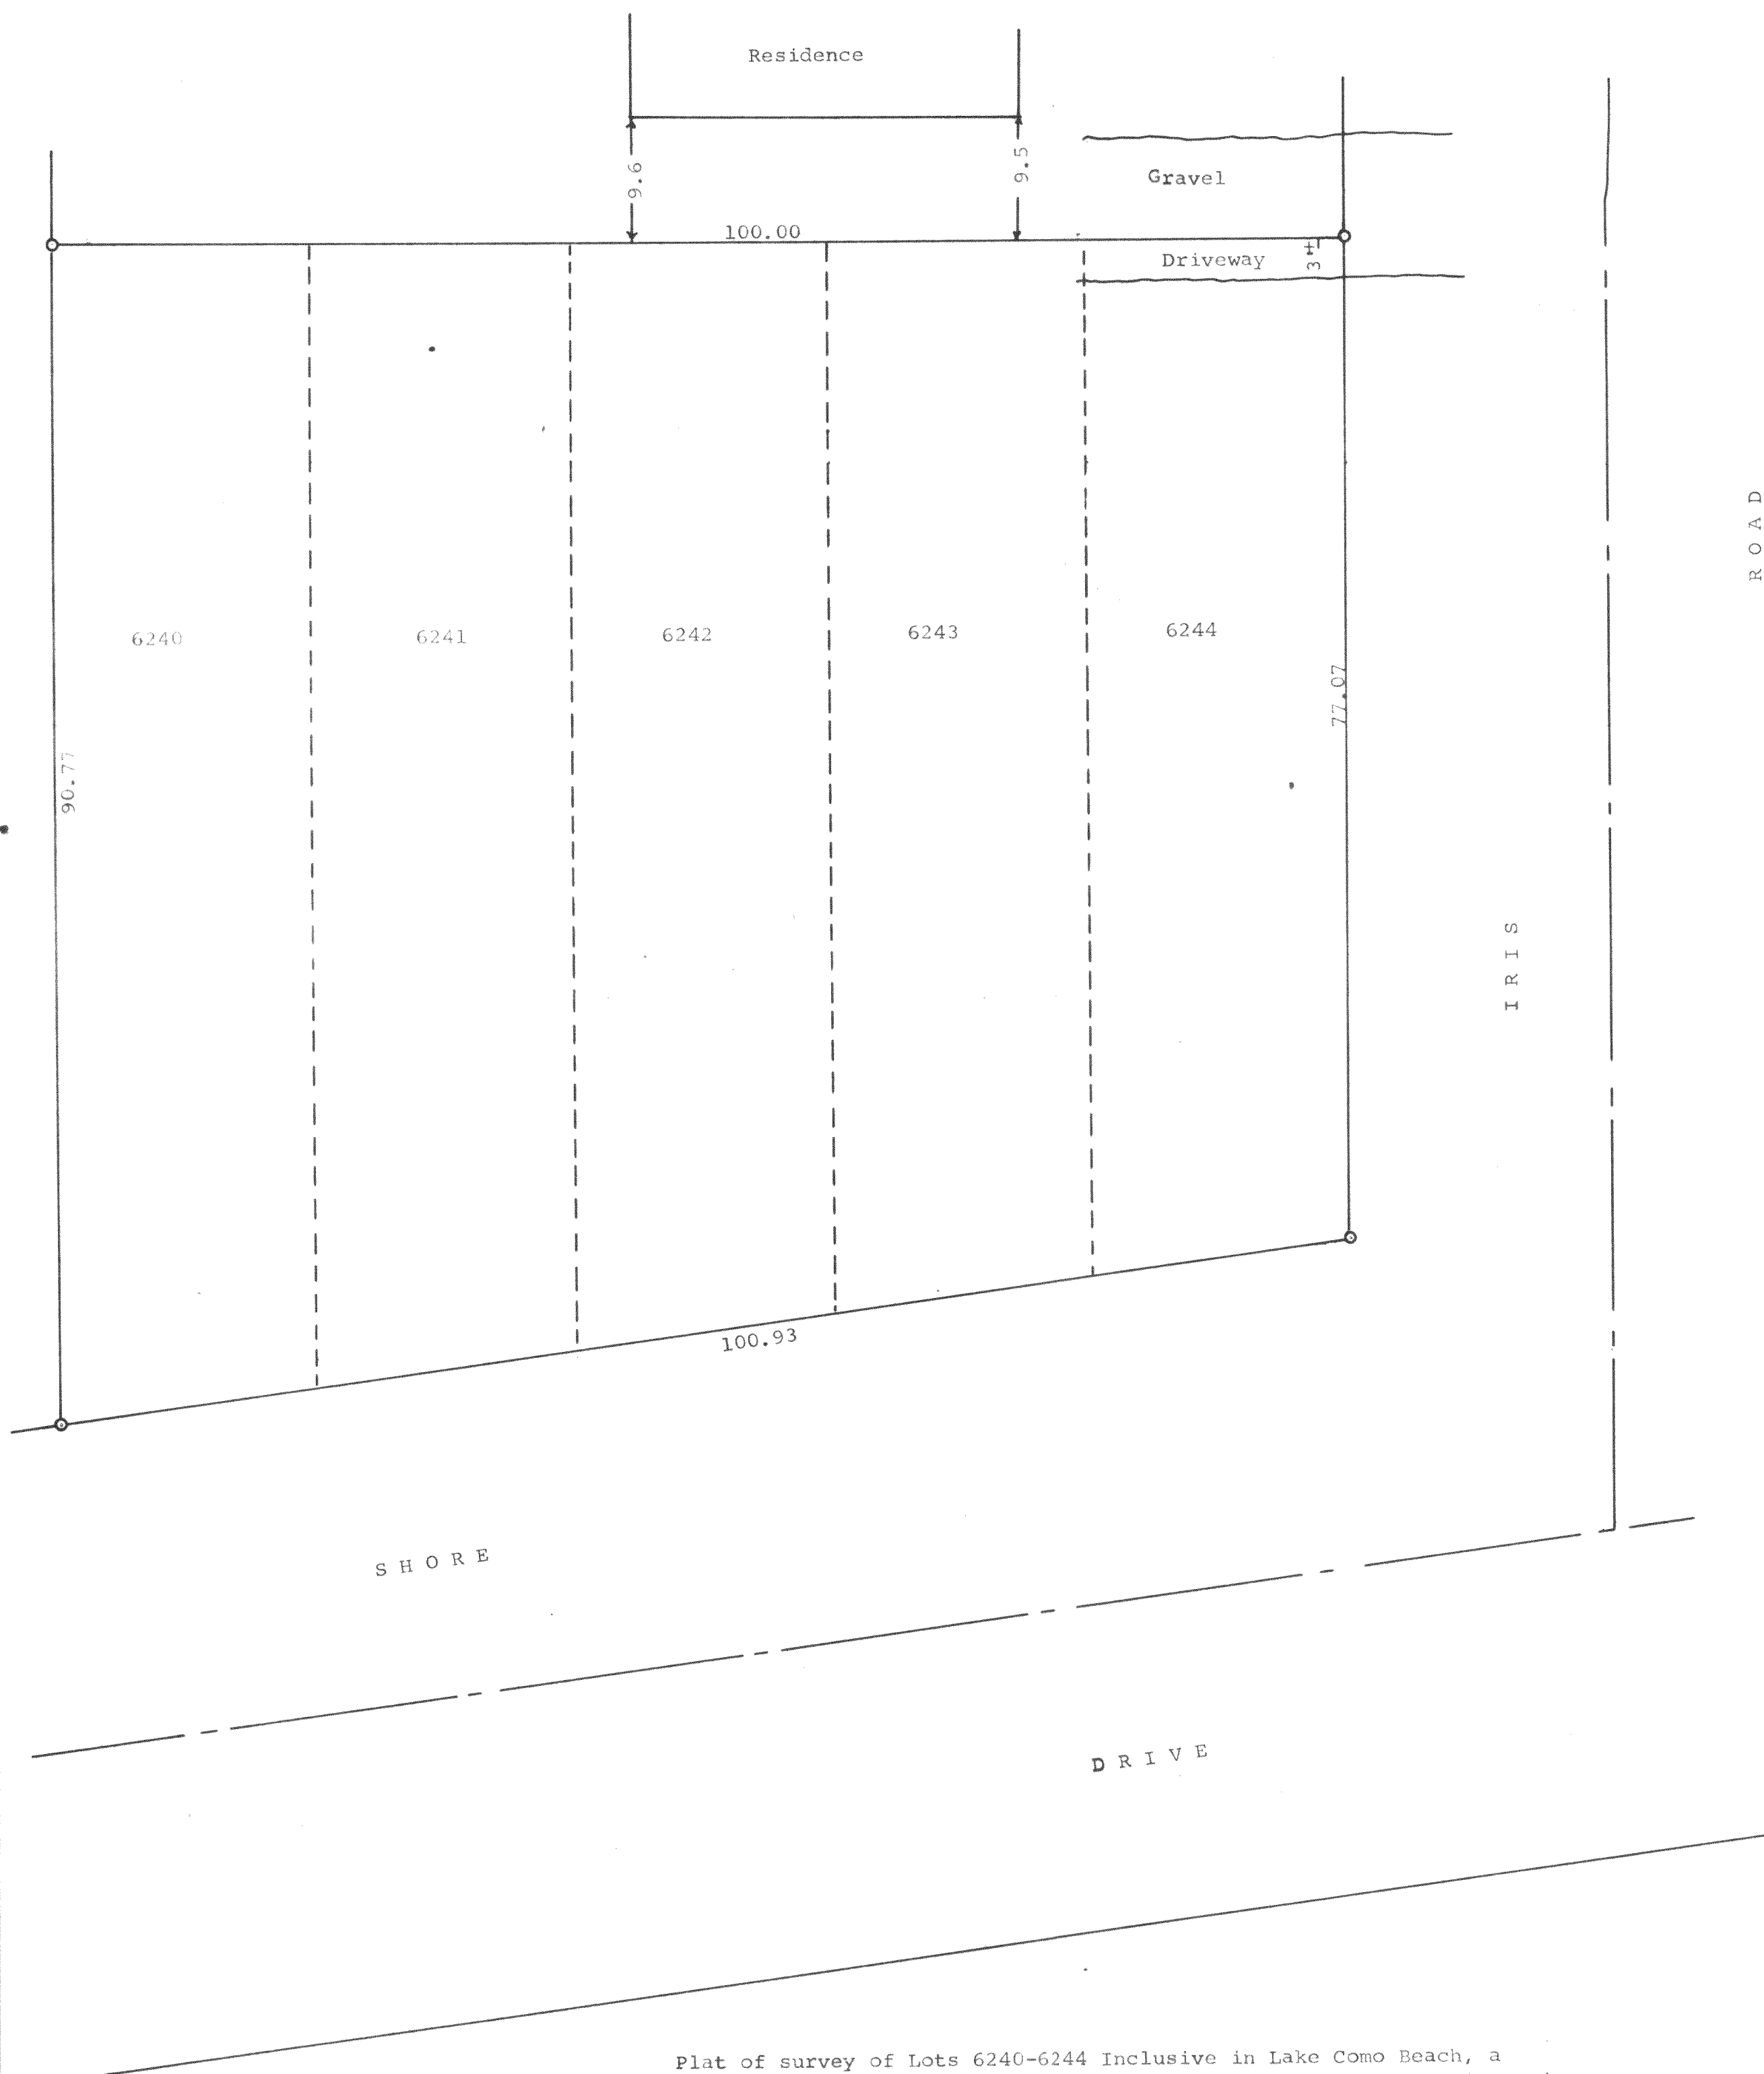

Scale - 1" = 10'  
● = Iron Pipe

Plat of survey of Lots 6240-6244 Inclusive in Lake Como Beach, a  
Subdivision located in the Town of Geneva, Walworth County, Wisconsin.  
July 22, 1966

*George T. Dunham*  
George T. Dunham, Surveyor