


DUNHAM SURVEYING, S.C.
SURVEYING & SUBDIVIDING
DELAVER, WISCONSIN 53115

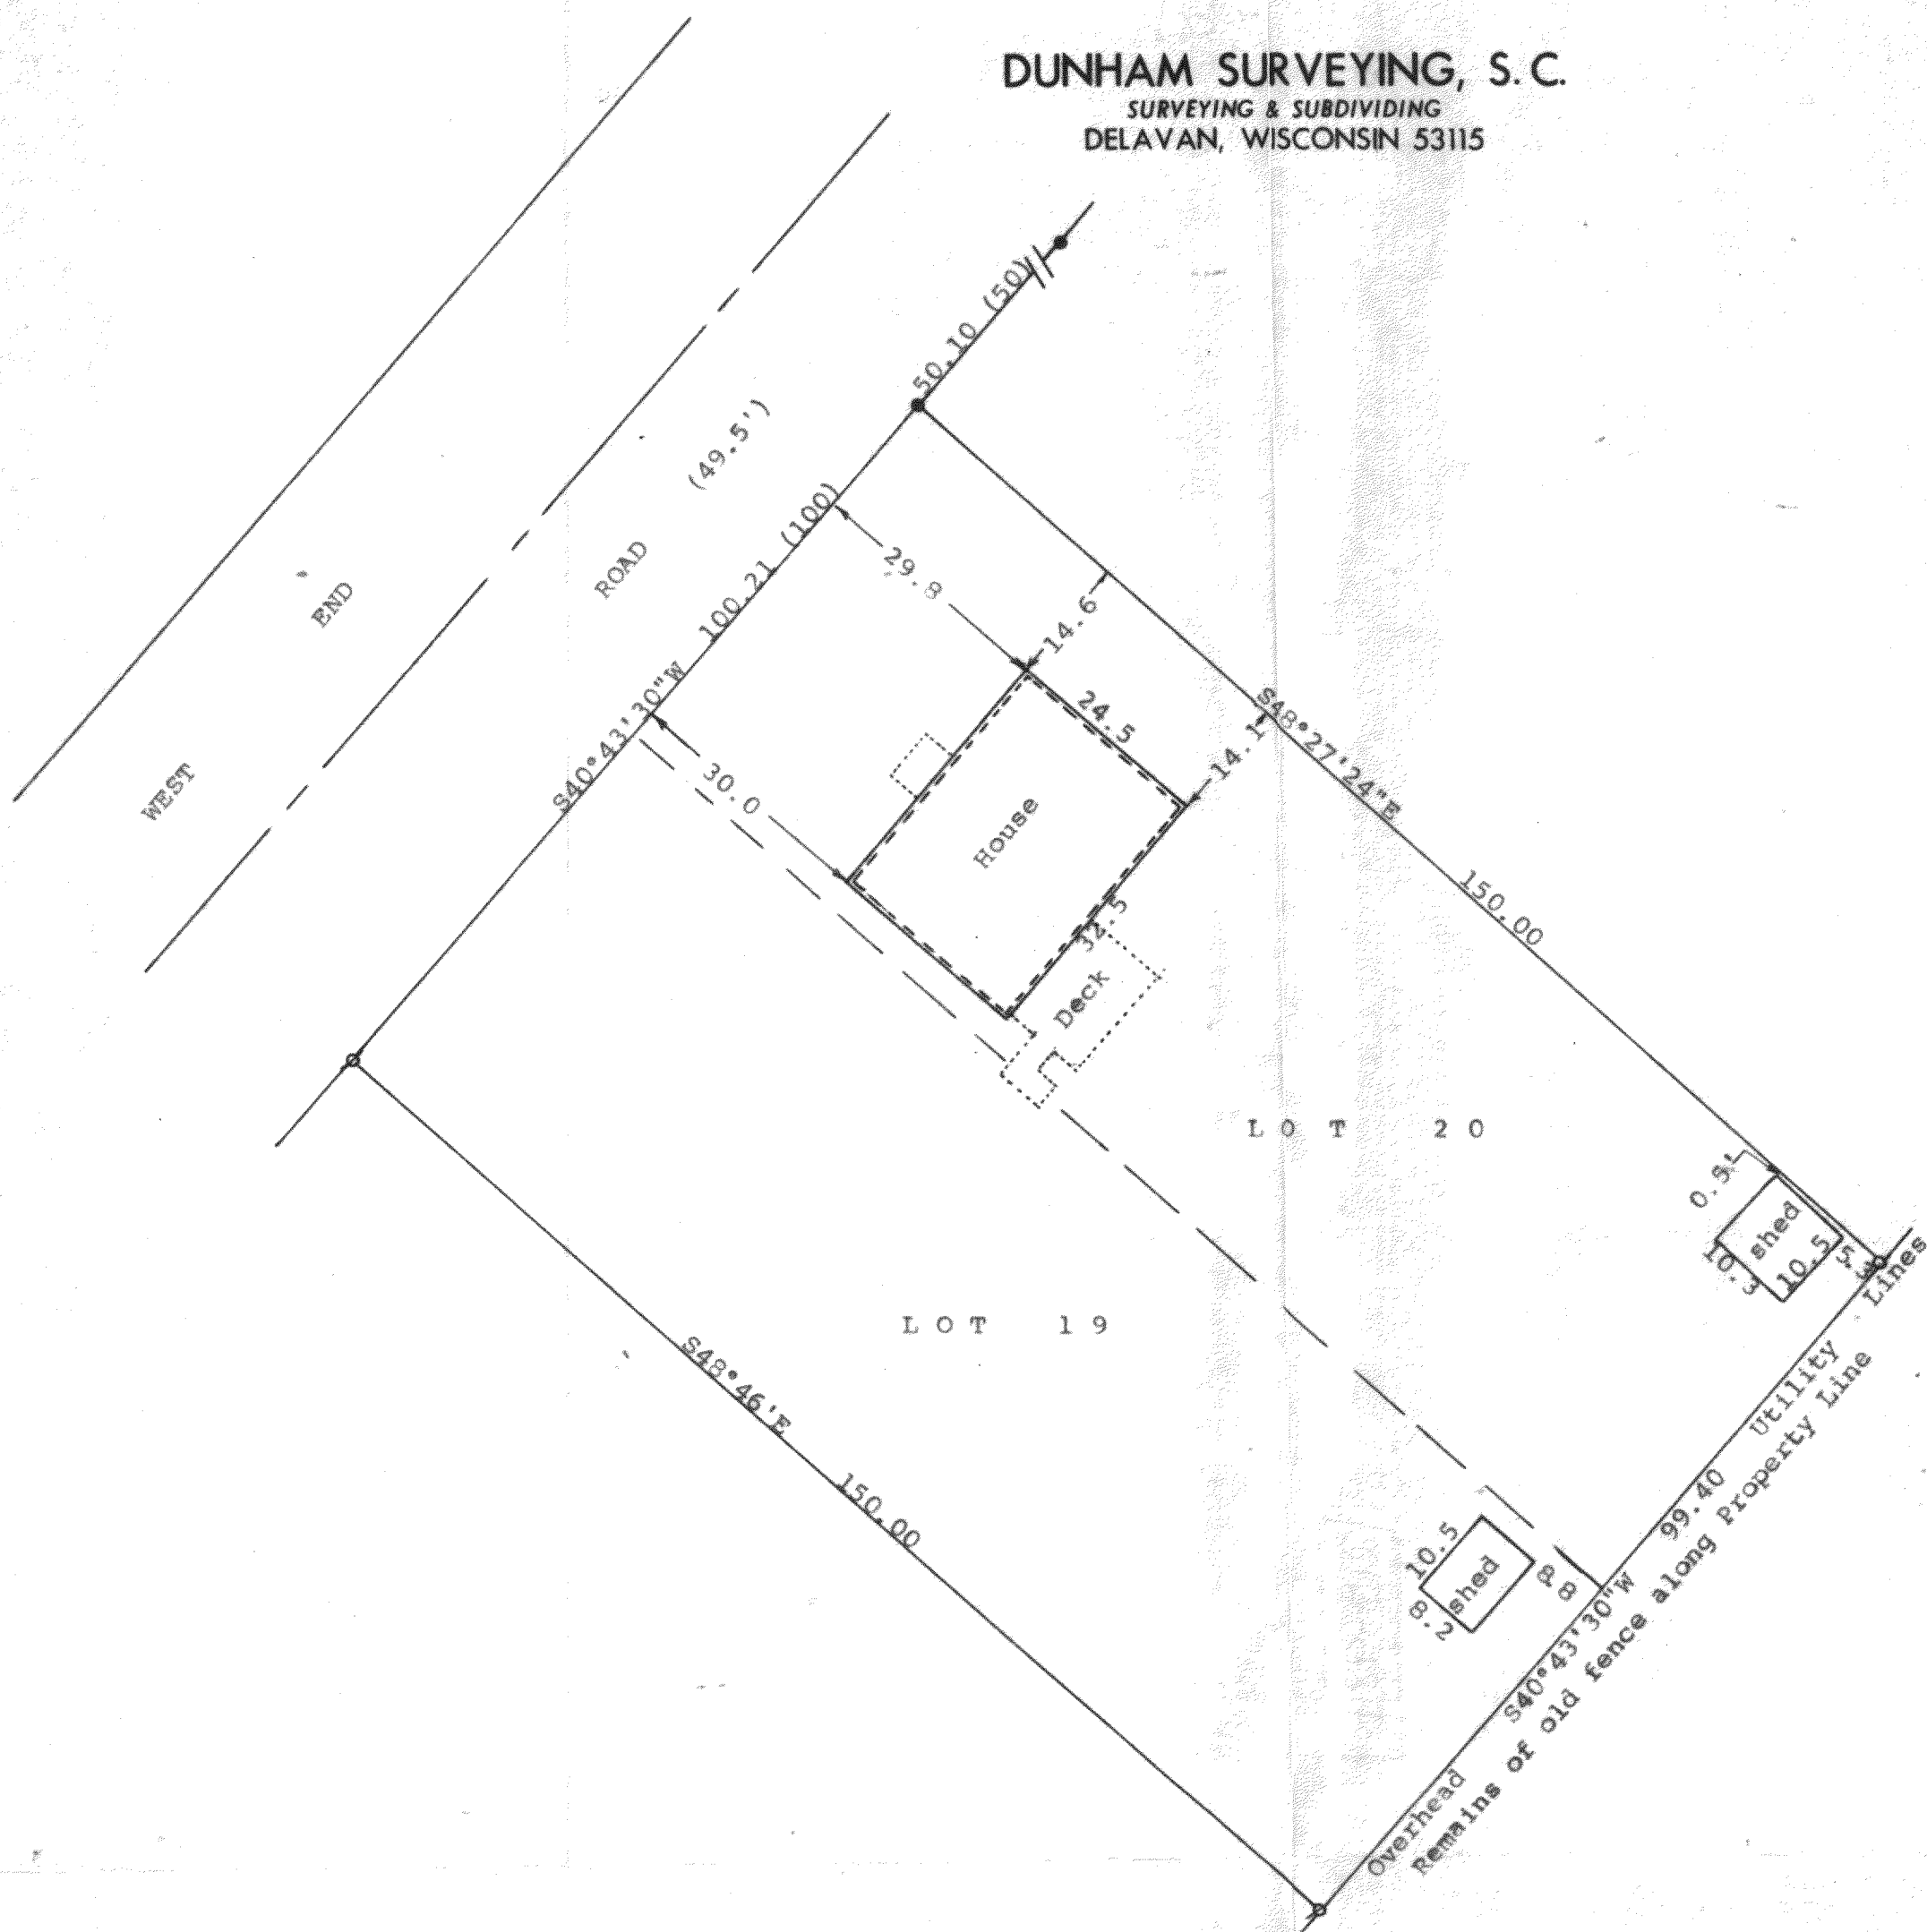

Scale - 1" = 20'
 ● = 1" Iron Pipe Found
 ⦿ = 1 1/4" Iron Pipe Found
 ○ = 3/4" Iron Pipe Set
 Bearings referenced to the previously recorded bearing of S48°46'E along the southwesterly line of Lot 19
 Survey ordered by:
 George Birkenheier
 1737 Highway 50
 Lake Geneva, WI 53147

STATE OF WISCONSIN) SS
 COUNTY OF WALWORTH)

I, George T. Dunham, Surveyor, certify that I have surveyed the property described as follows:

Lots 19 and 20 in Como Vista Subdivision, located in Section 32, T 2 N, R 17 E, Walworth County, Wisconsin,

and that the plat shown hereon is a correct representation thereof and shows the size and location of the property, its exterior boundaries, the location of all visible structures and dimensions of all principal buildings thereon, boundary fences, apparent easements, roadways and visible encroachments, if any, and that I have surveyed the property hereon described, according to the official records, to the best of my knowledge and belief.

July 16, 1990

George T. Dunham
 George T. Dunham, Surveyor

