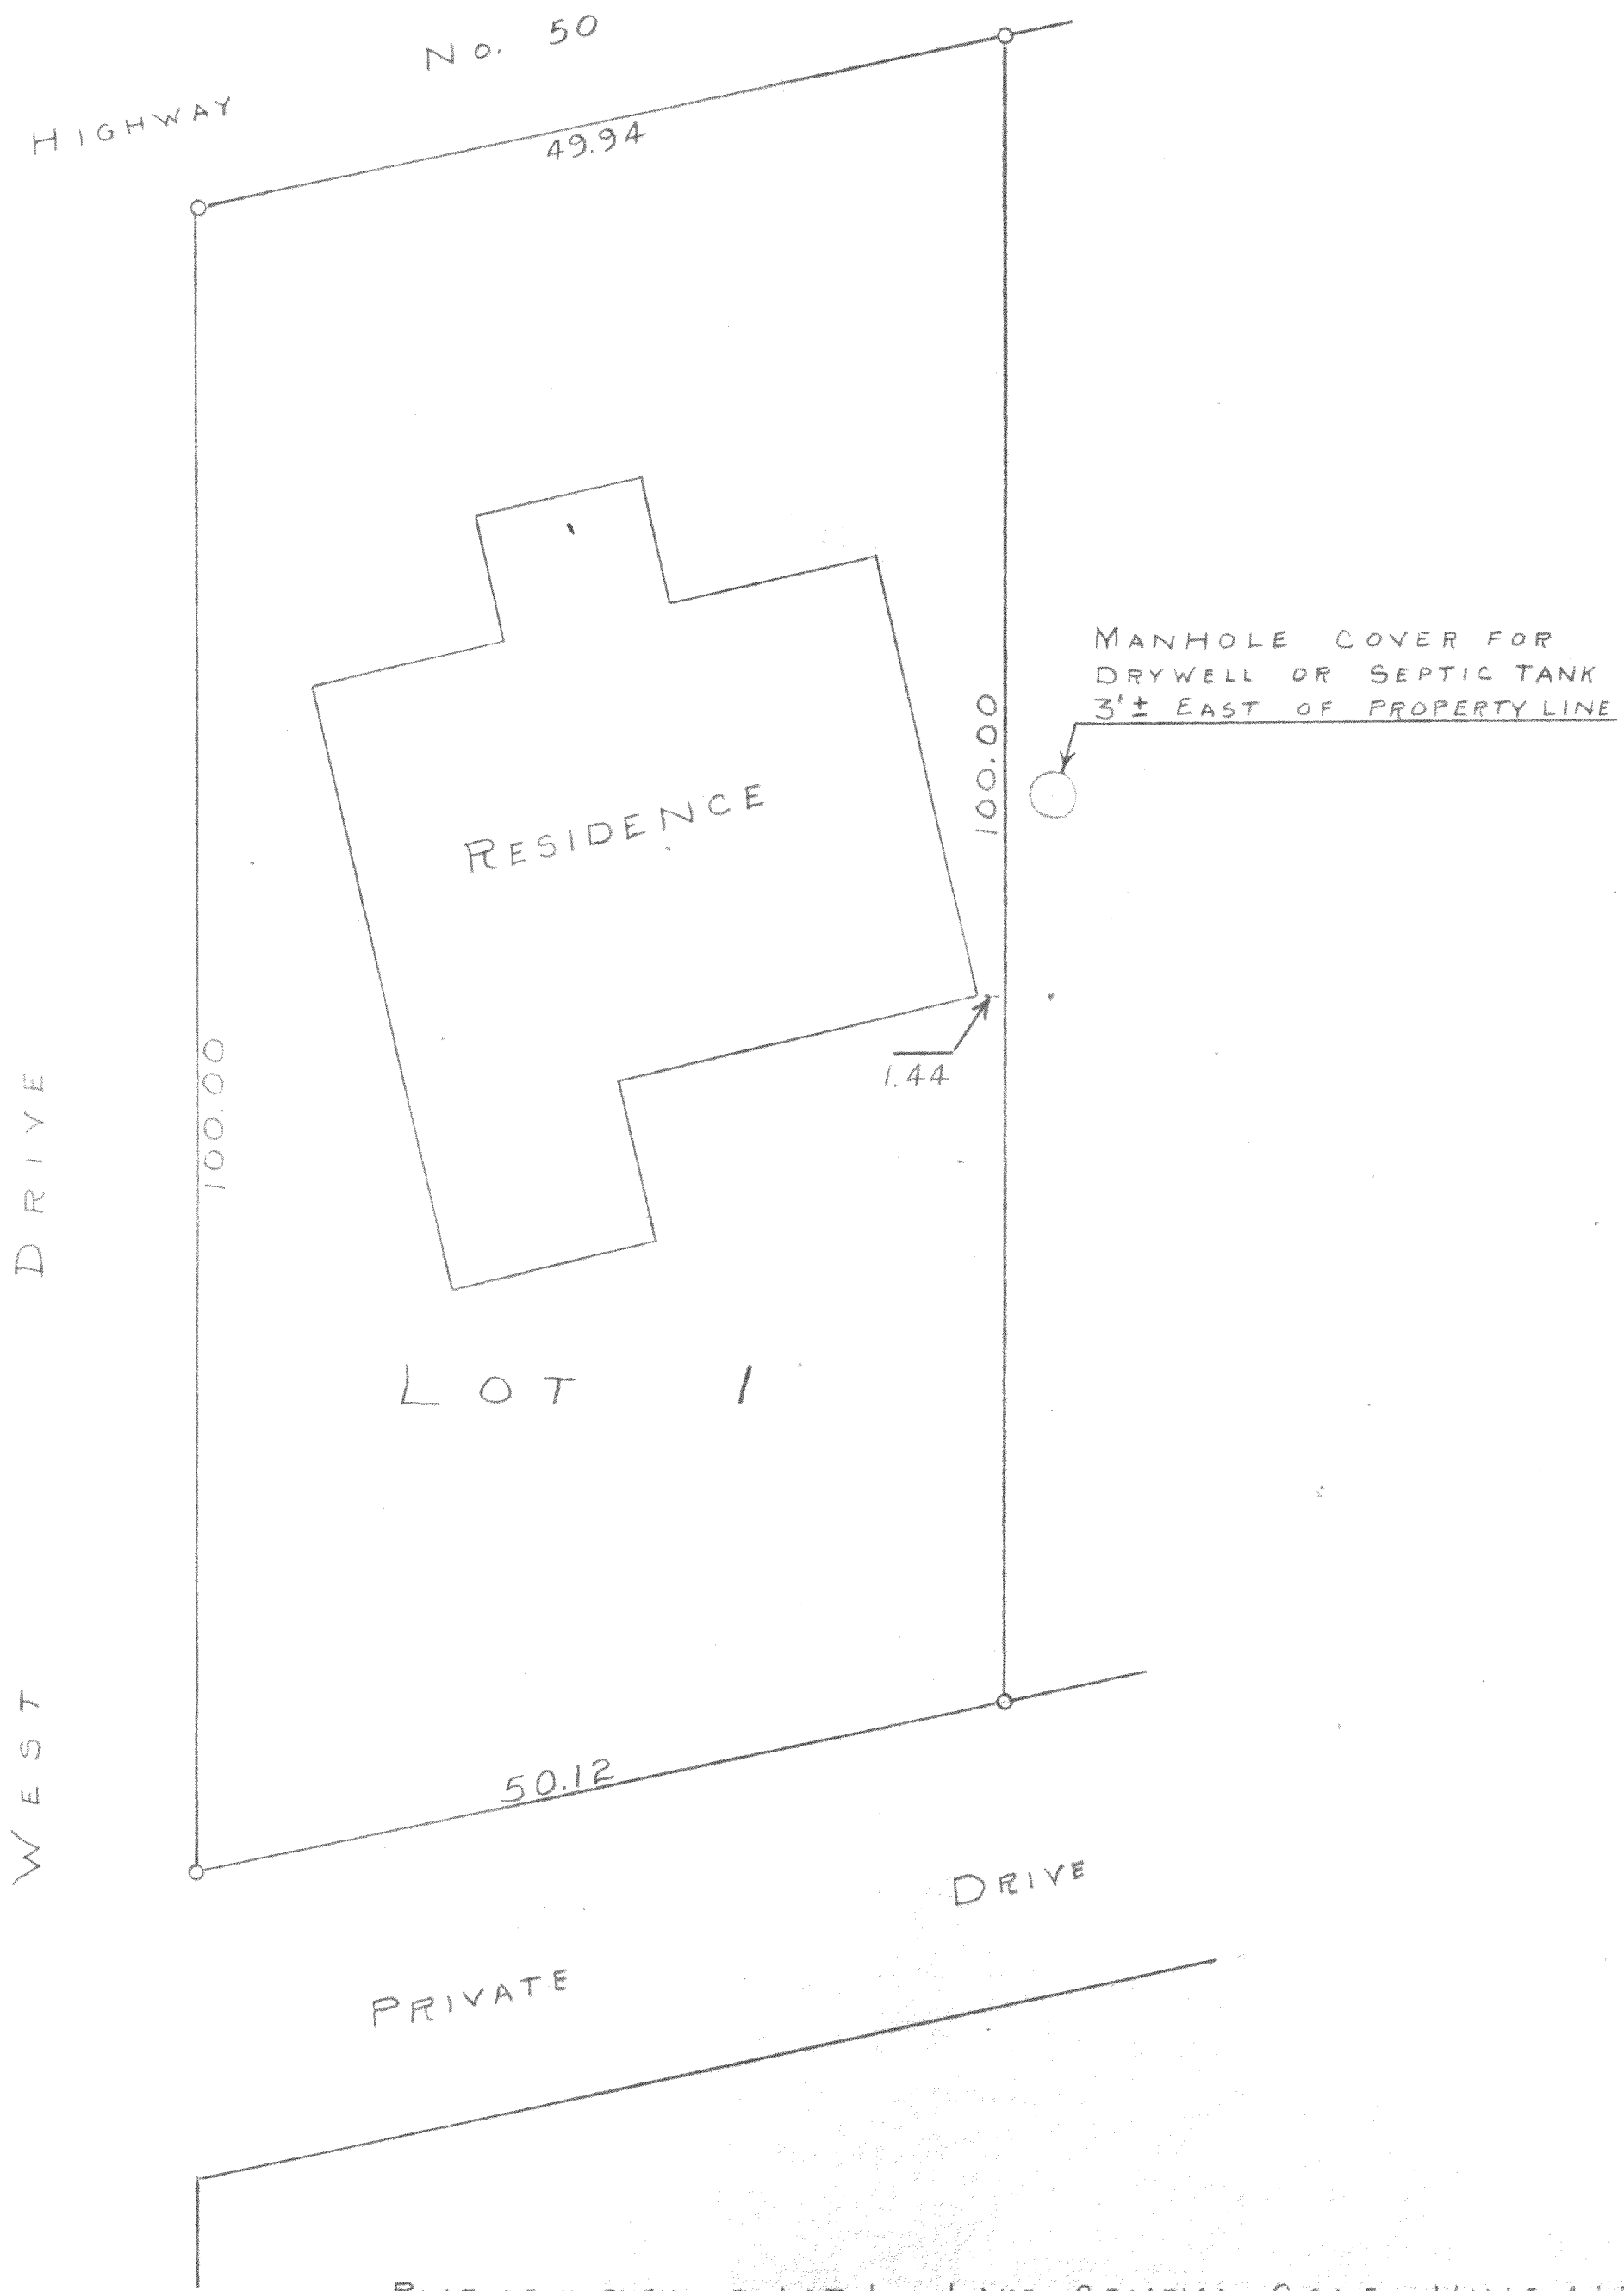


SCALE ~ 1" = 10'
O = IRON PIPE

PLAT OF SURVEY OF LOT 1, LAKE GENEVA GOLF HILLS ADD
LOCATED IN SECTION 31, T2N R18E OF WALWORTH
COUNTY, WISCONSIN
SEPT. 3, 1954

George T. Dunham
GEORGE T. DUNHAM, SURVEYOR
DELAVER, WISCONSIN

218-1