
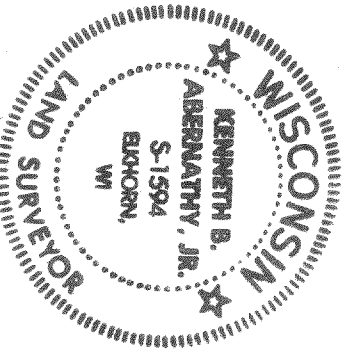


PLAT OF SURVEY

LOT 8 OF THE REPLAT OF STURGIS PARTNERS LTD.
SUBDIVISION, LOCATED IN SECTIONS 22 AND 23, TOWN 2
NORTH, RANGE 18 EAST, TOWN OF LYONS, WALWORTH COUNTY,
WISCONSIN.

OWNER: LORRETTA H. STURGIS
P.O. BOX 149
LYONS, WI. 53148

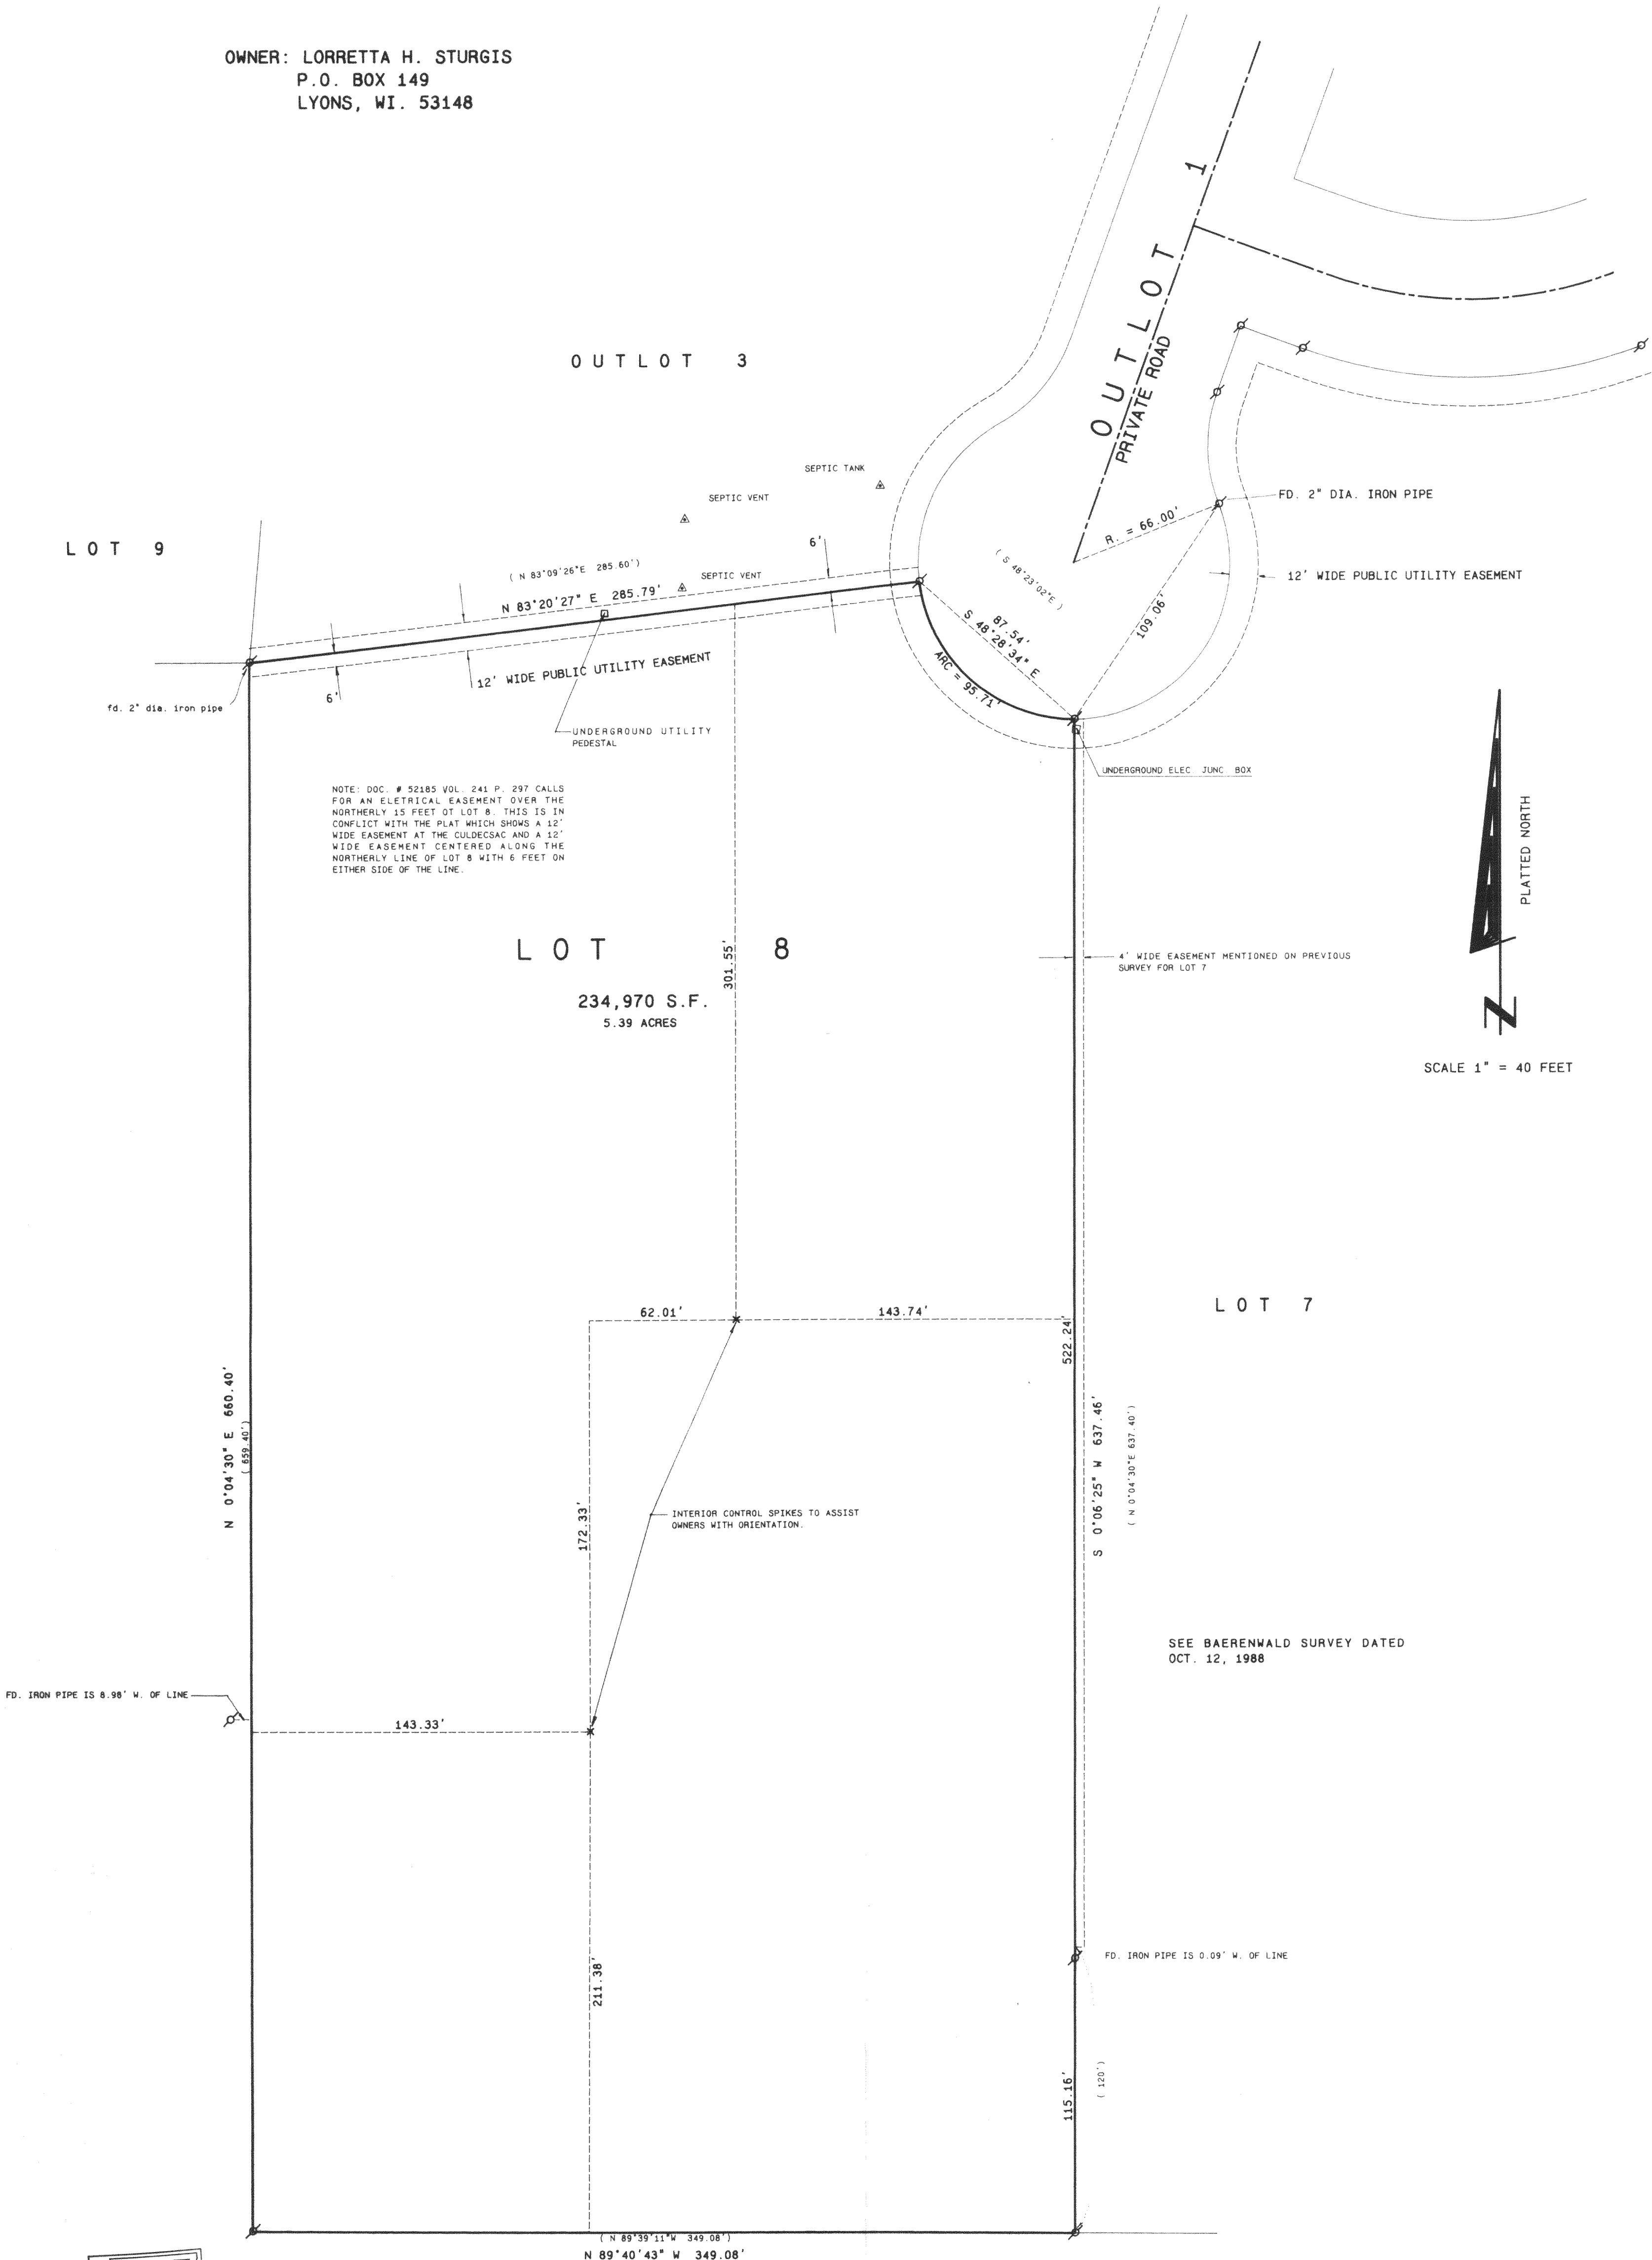

Kenneth B. Abernathy, Jr.
WISCONSIN REGISTERED LAND SURVEYOR,
S-1594
Date: 8-21-98 Job No. 16807