


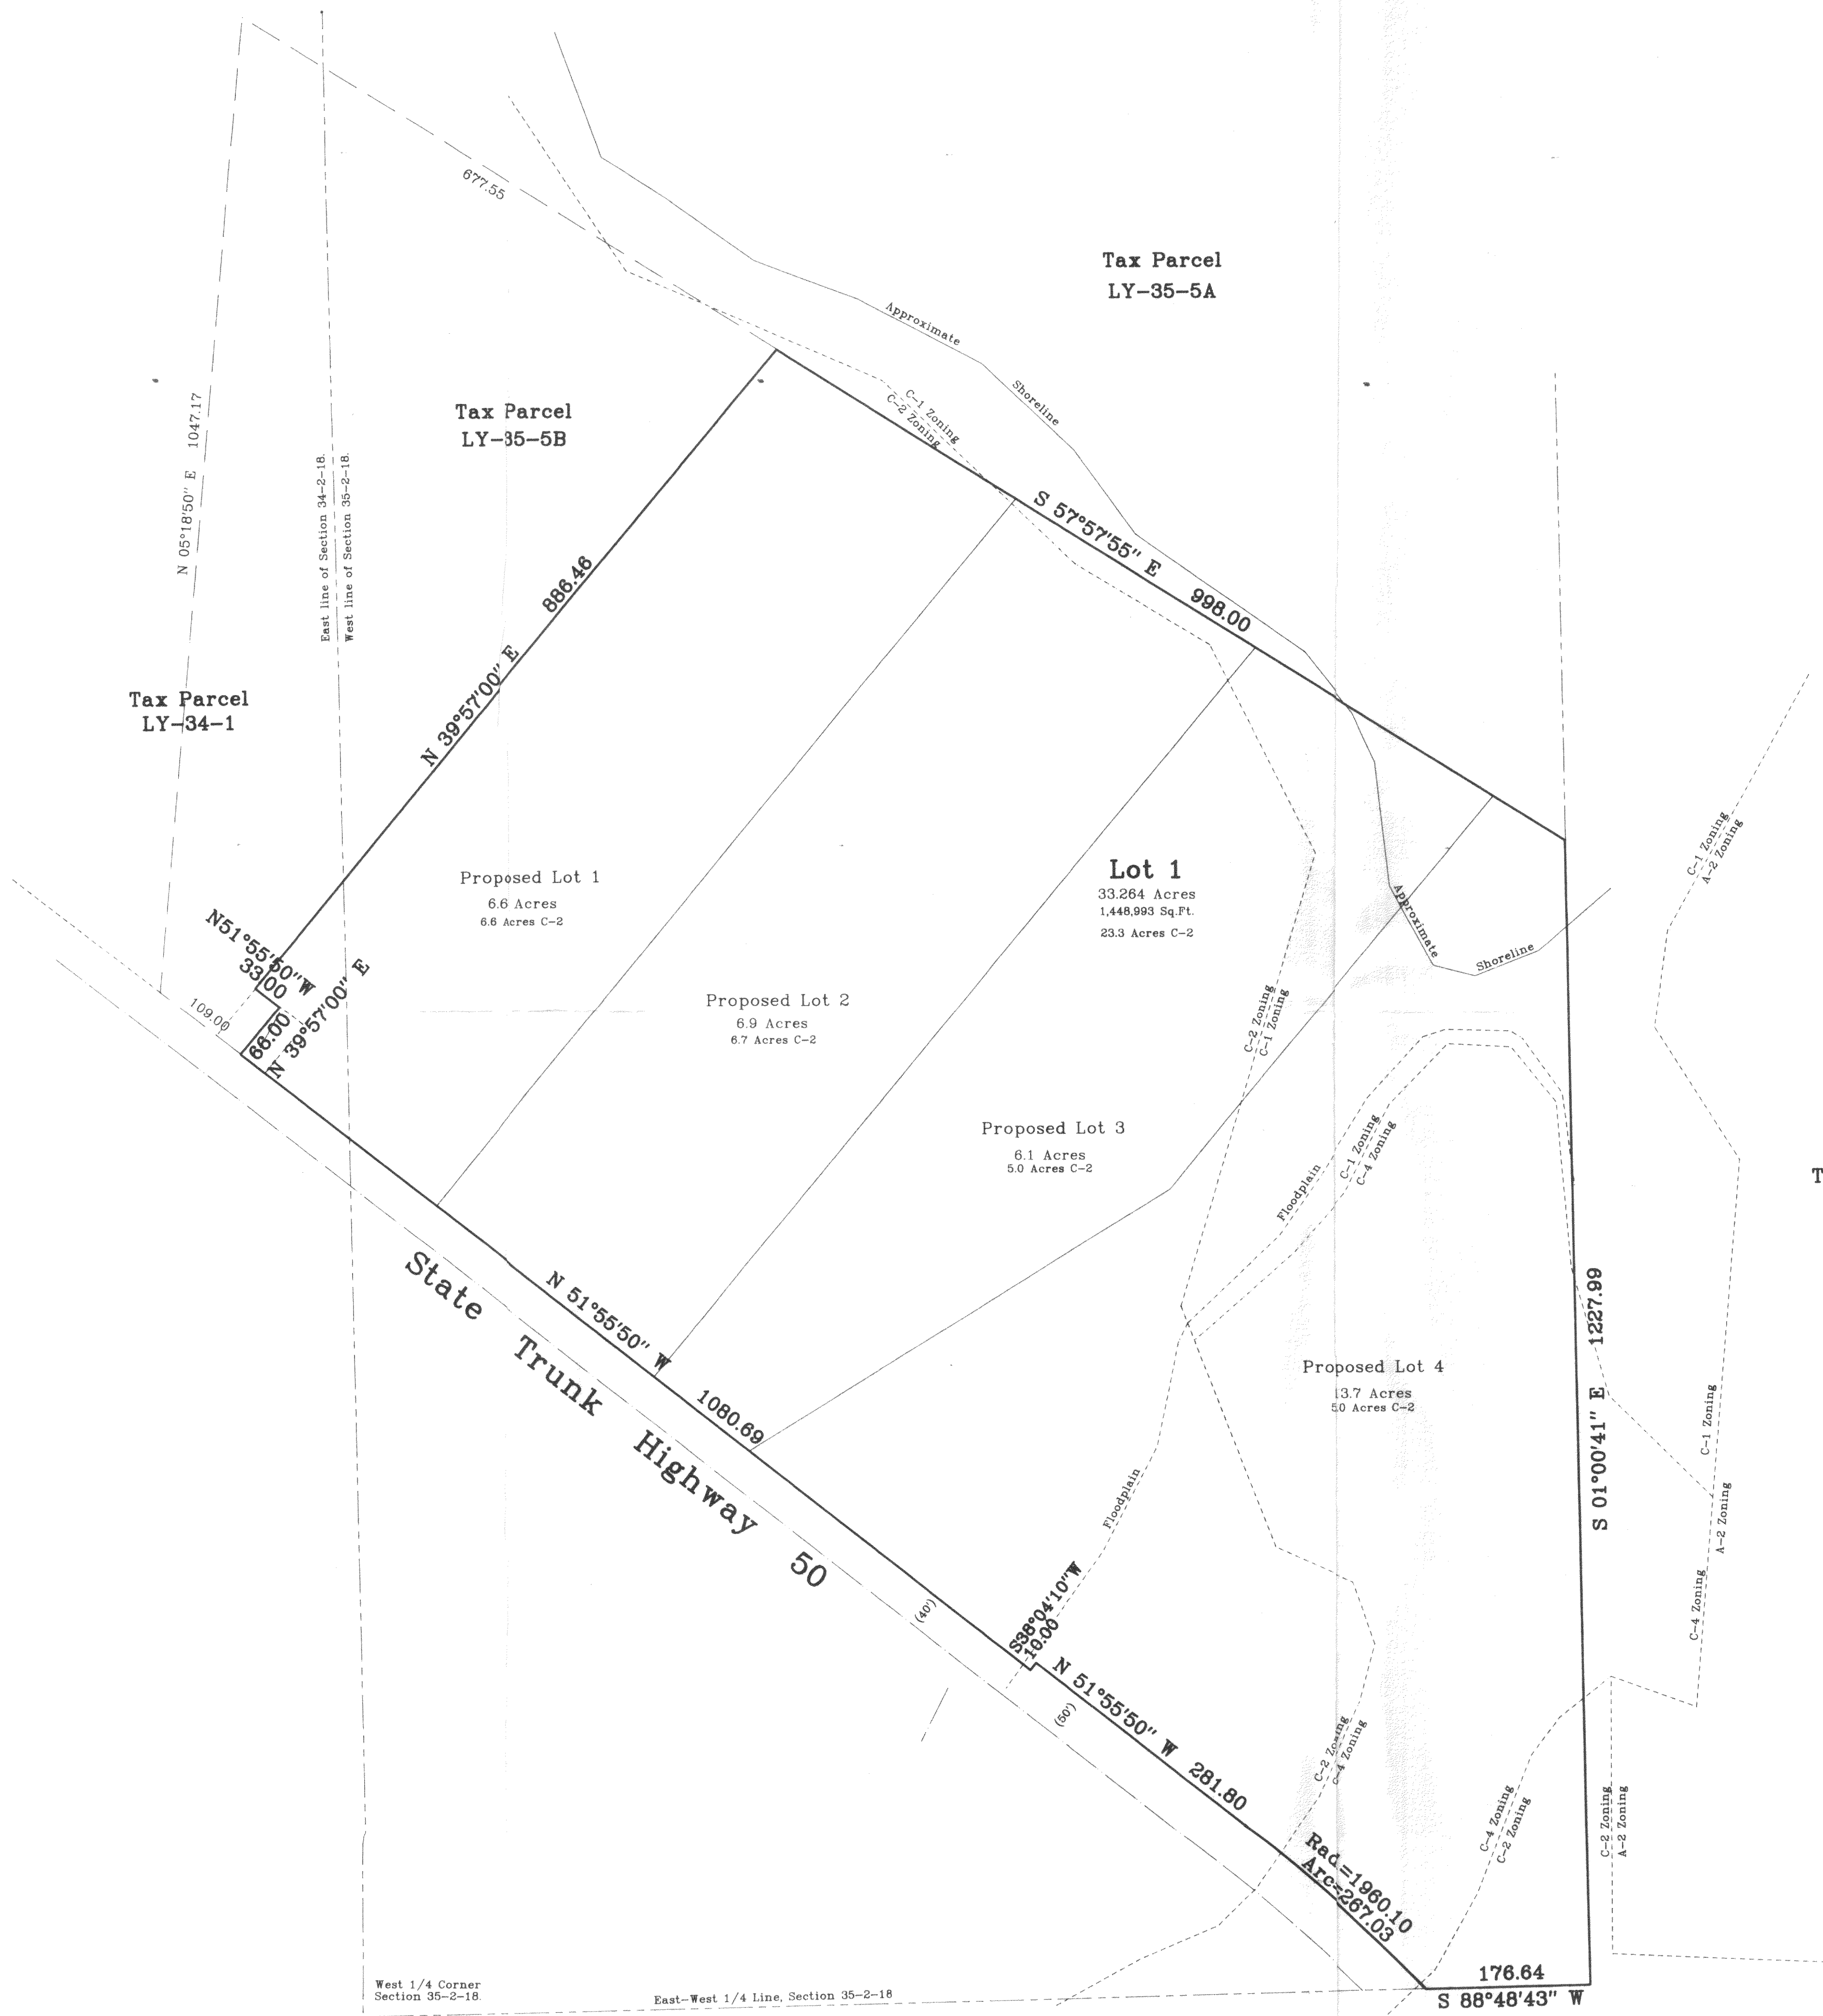

Property Exhibit


of
Lot 1 of Certified Survey Map No. 2009,
recorded in Vol. 9 of Certified Surveys of Walworth County on
Page 287, located in the Northeast 1/4 of Section 34, and the
Northwest 1/4 of Section 35, Town 2 North, Range 18 East,
Town of Lyons, Walworth County, Wisconsin.

Prepared for:

Paul Klabacha
13670 McCarthy Road
Lemont, Illinois. 60439

Bearings and distances are shown as
recorded on C.S.M. 2009.

Zoning lines are digitized from Walworth
County Zoning Maps.

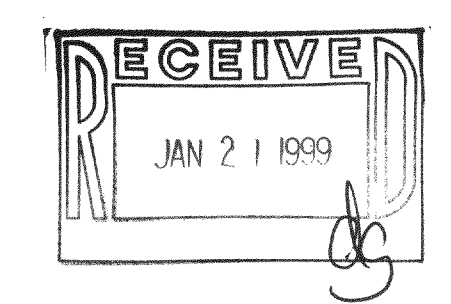


Jensen & Olson Land Surveying, LLC
45 South Wisconsin Street P.O. Box 322
Elkhorn, Wisconsin. 53121
Telephone: (414) 723-3434
Facsimile: (414) 723-8044


Legend

Sheet 1 of 2 Sheets.
Job Reference Number
1998.055

1998.055

Mapping date: Oct. 15, 1998.
Revisions:

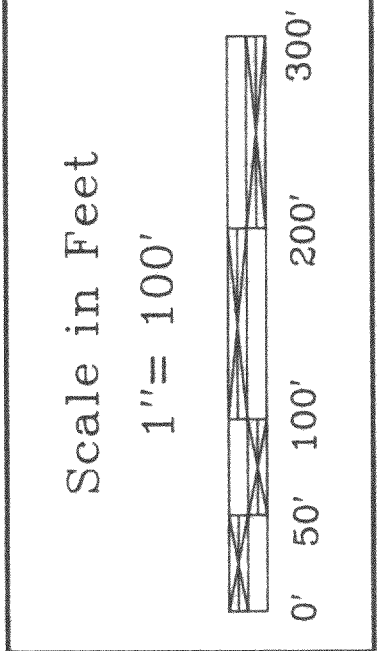

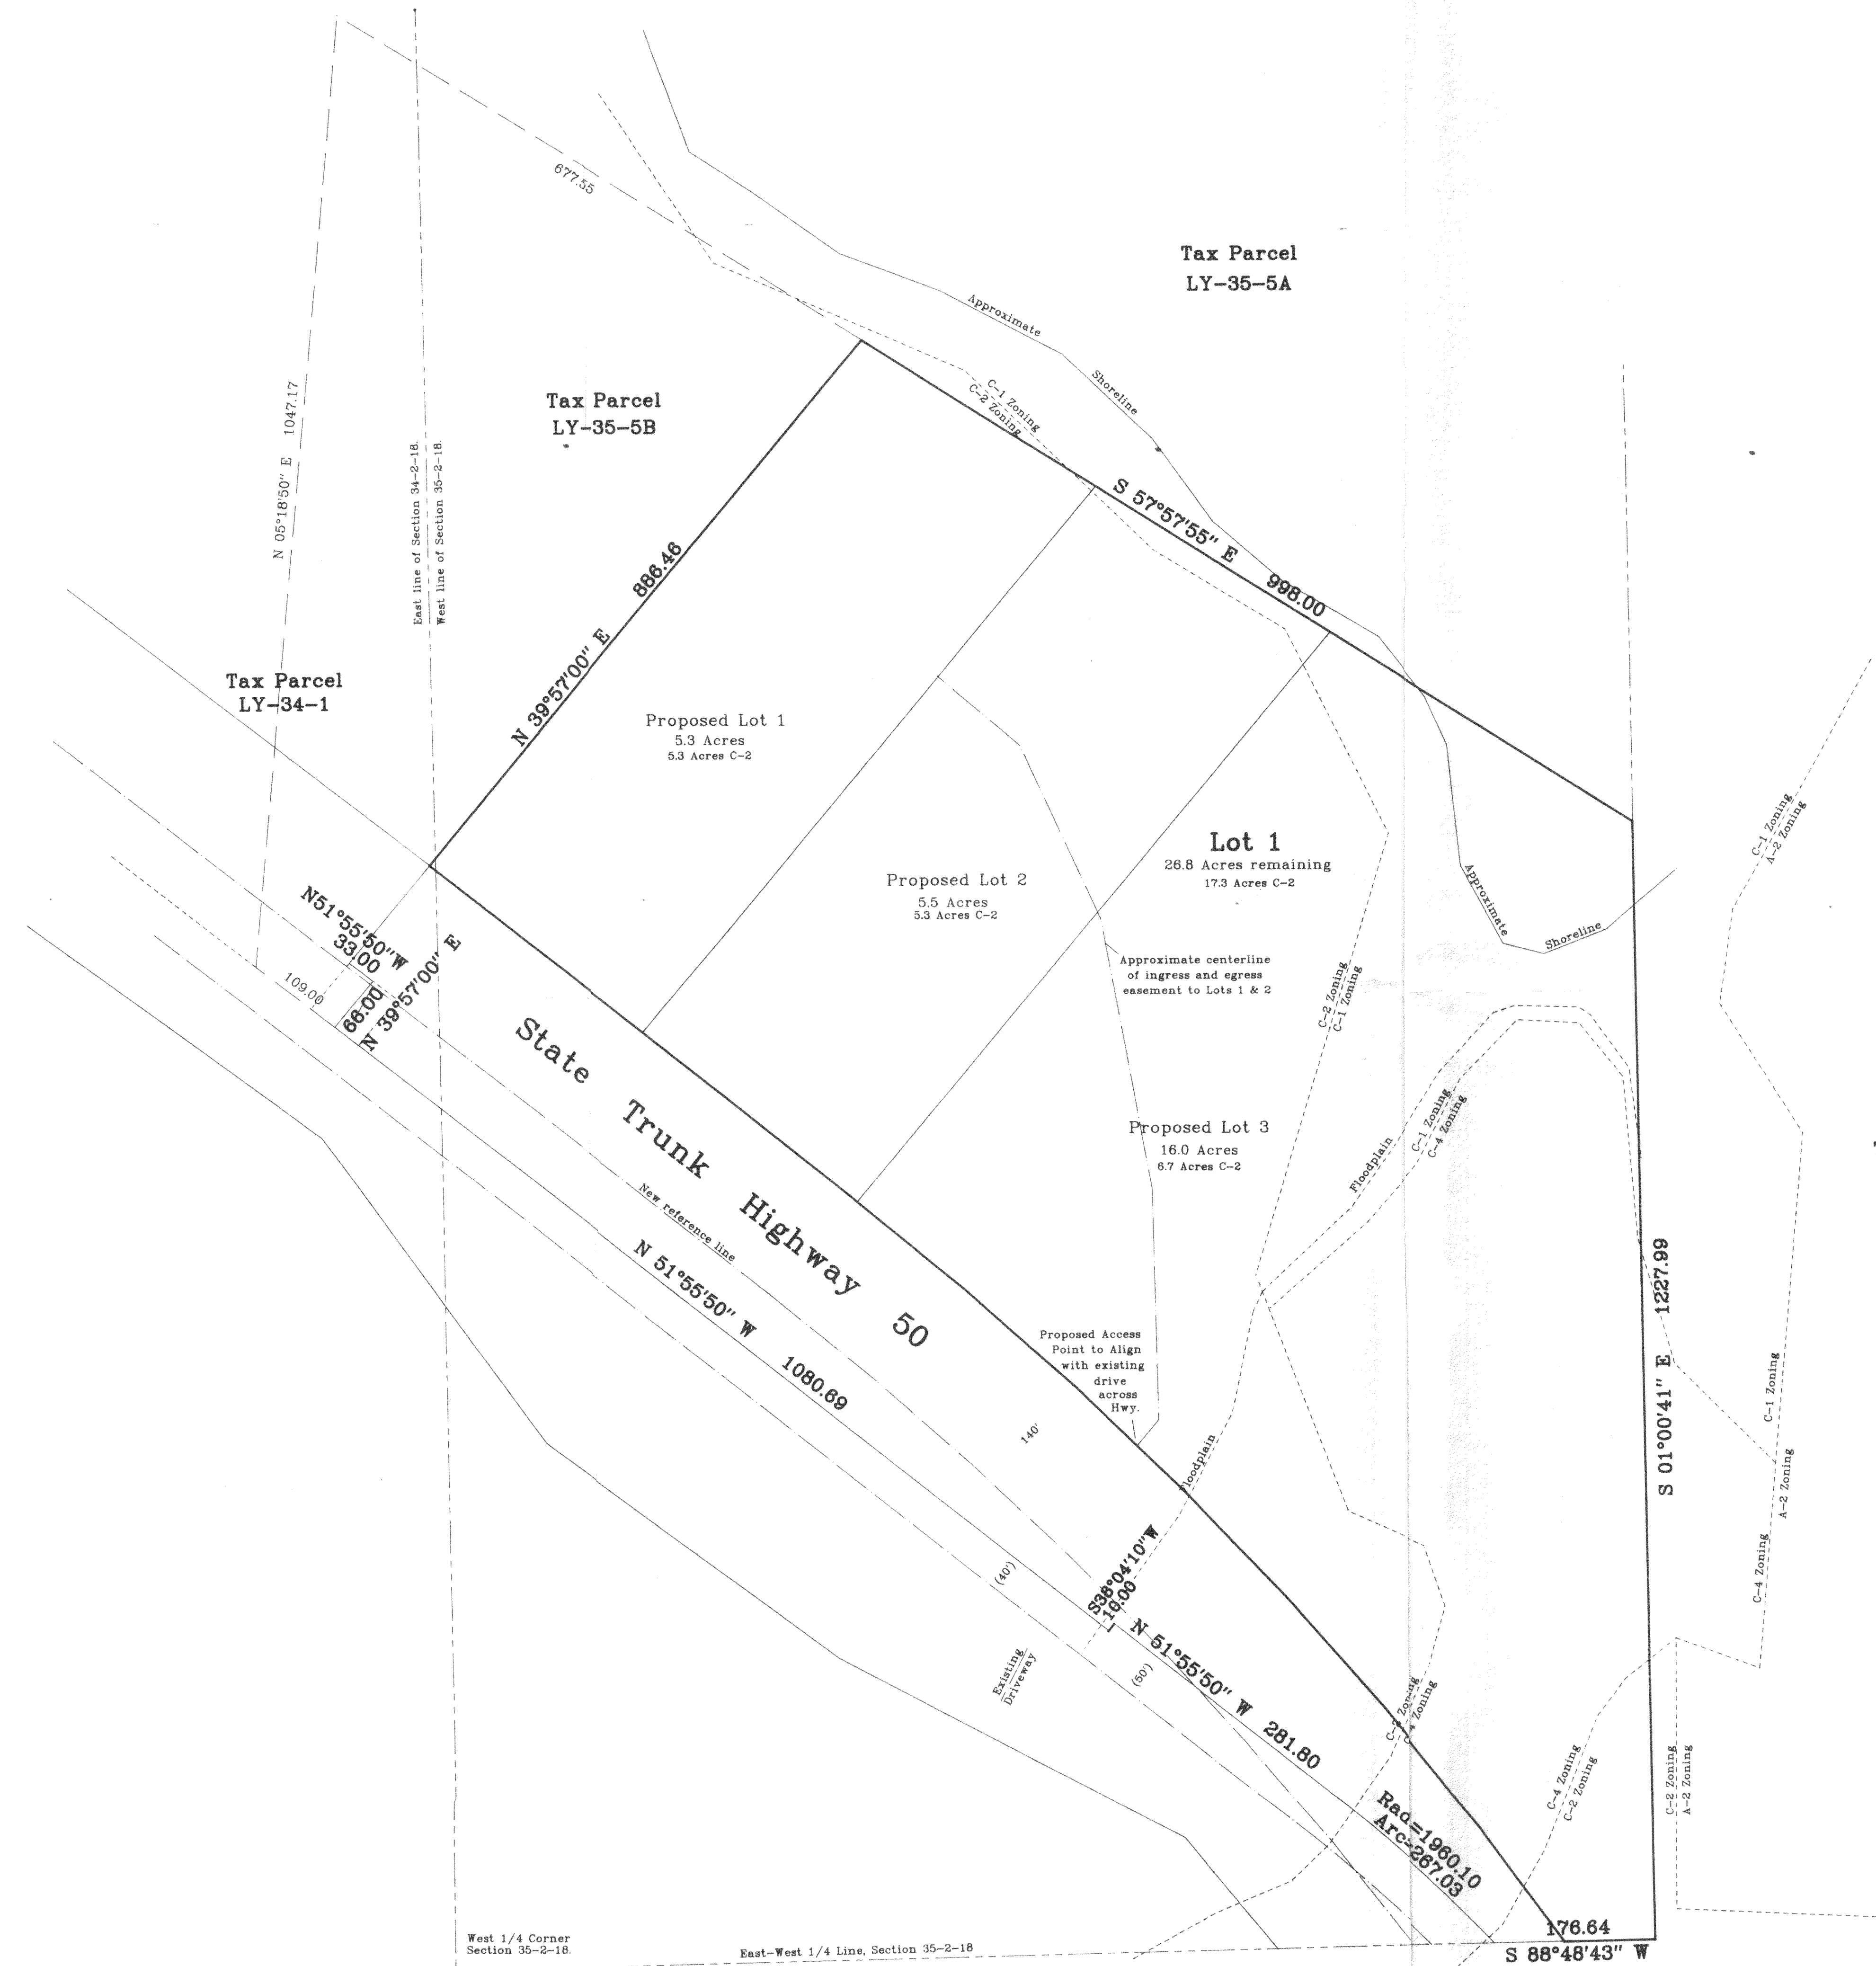



Property Exhibit

of
Lot 1 of Certified Survey Map No. 2009,
recorded in Vol. 9 of Certified Surveys of Walworth County on
Page 297, located in the Northeast 1/4 of Section 34, and the
Northwest 1/4 of Section 35, Town 2 North, Range 18 East,
Town of Lyons, Walworth County, Wisconsin.

After Proposed Highway 50 R.O.W. Change

Prepared for:

Paul Klabacha
13670 McCarthy Road
Lemont, Illinois. 60439

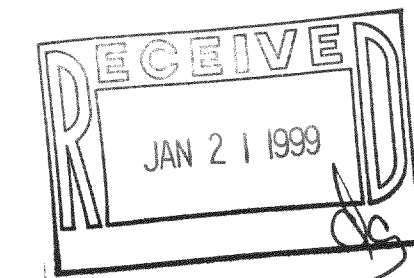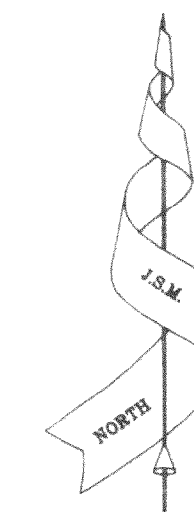

Bearings and distances are shown as
recorded on C.S.M. 2009.

Zoning lines are digitized from Walworth
County Zoning Maps.

Mapping date: Oct. 15, 1998.
Revisions:

Scale in Feet
1" = 100'



Jensen & Olson Land Surveying, LLC

45 South Wisconsin Street P.O. Box 322
Elkhorn, Wisconsin. 53121
Telephone: (414) 723-3434
Facsimile: (414) 723-8044

Legend

Sheet 2 of 2 Sheets.

Job Reference Number
1998.055

1998.055