
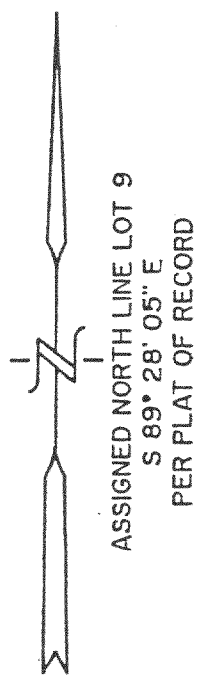


PLAT OF SURVEY

LOT 9 IN PARTRIDGE WOODS
A SUBDIVISION LOCATED IN THE NE 1/4, SE 1/4, & SW 1/4
SECTION 23, TOWN 2 NORTH, RANGE 18 EAST
WALWORTH COUNTY, WISCONSIN

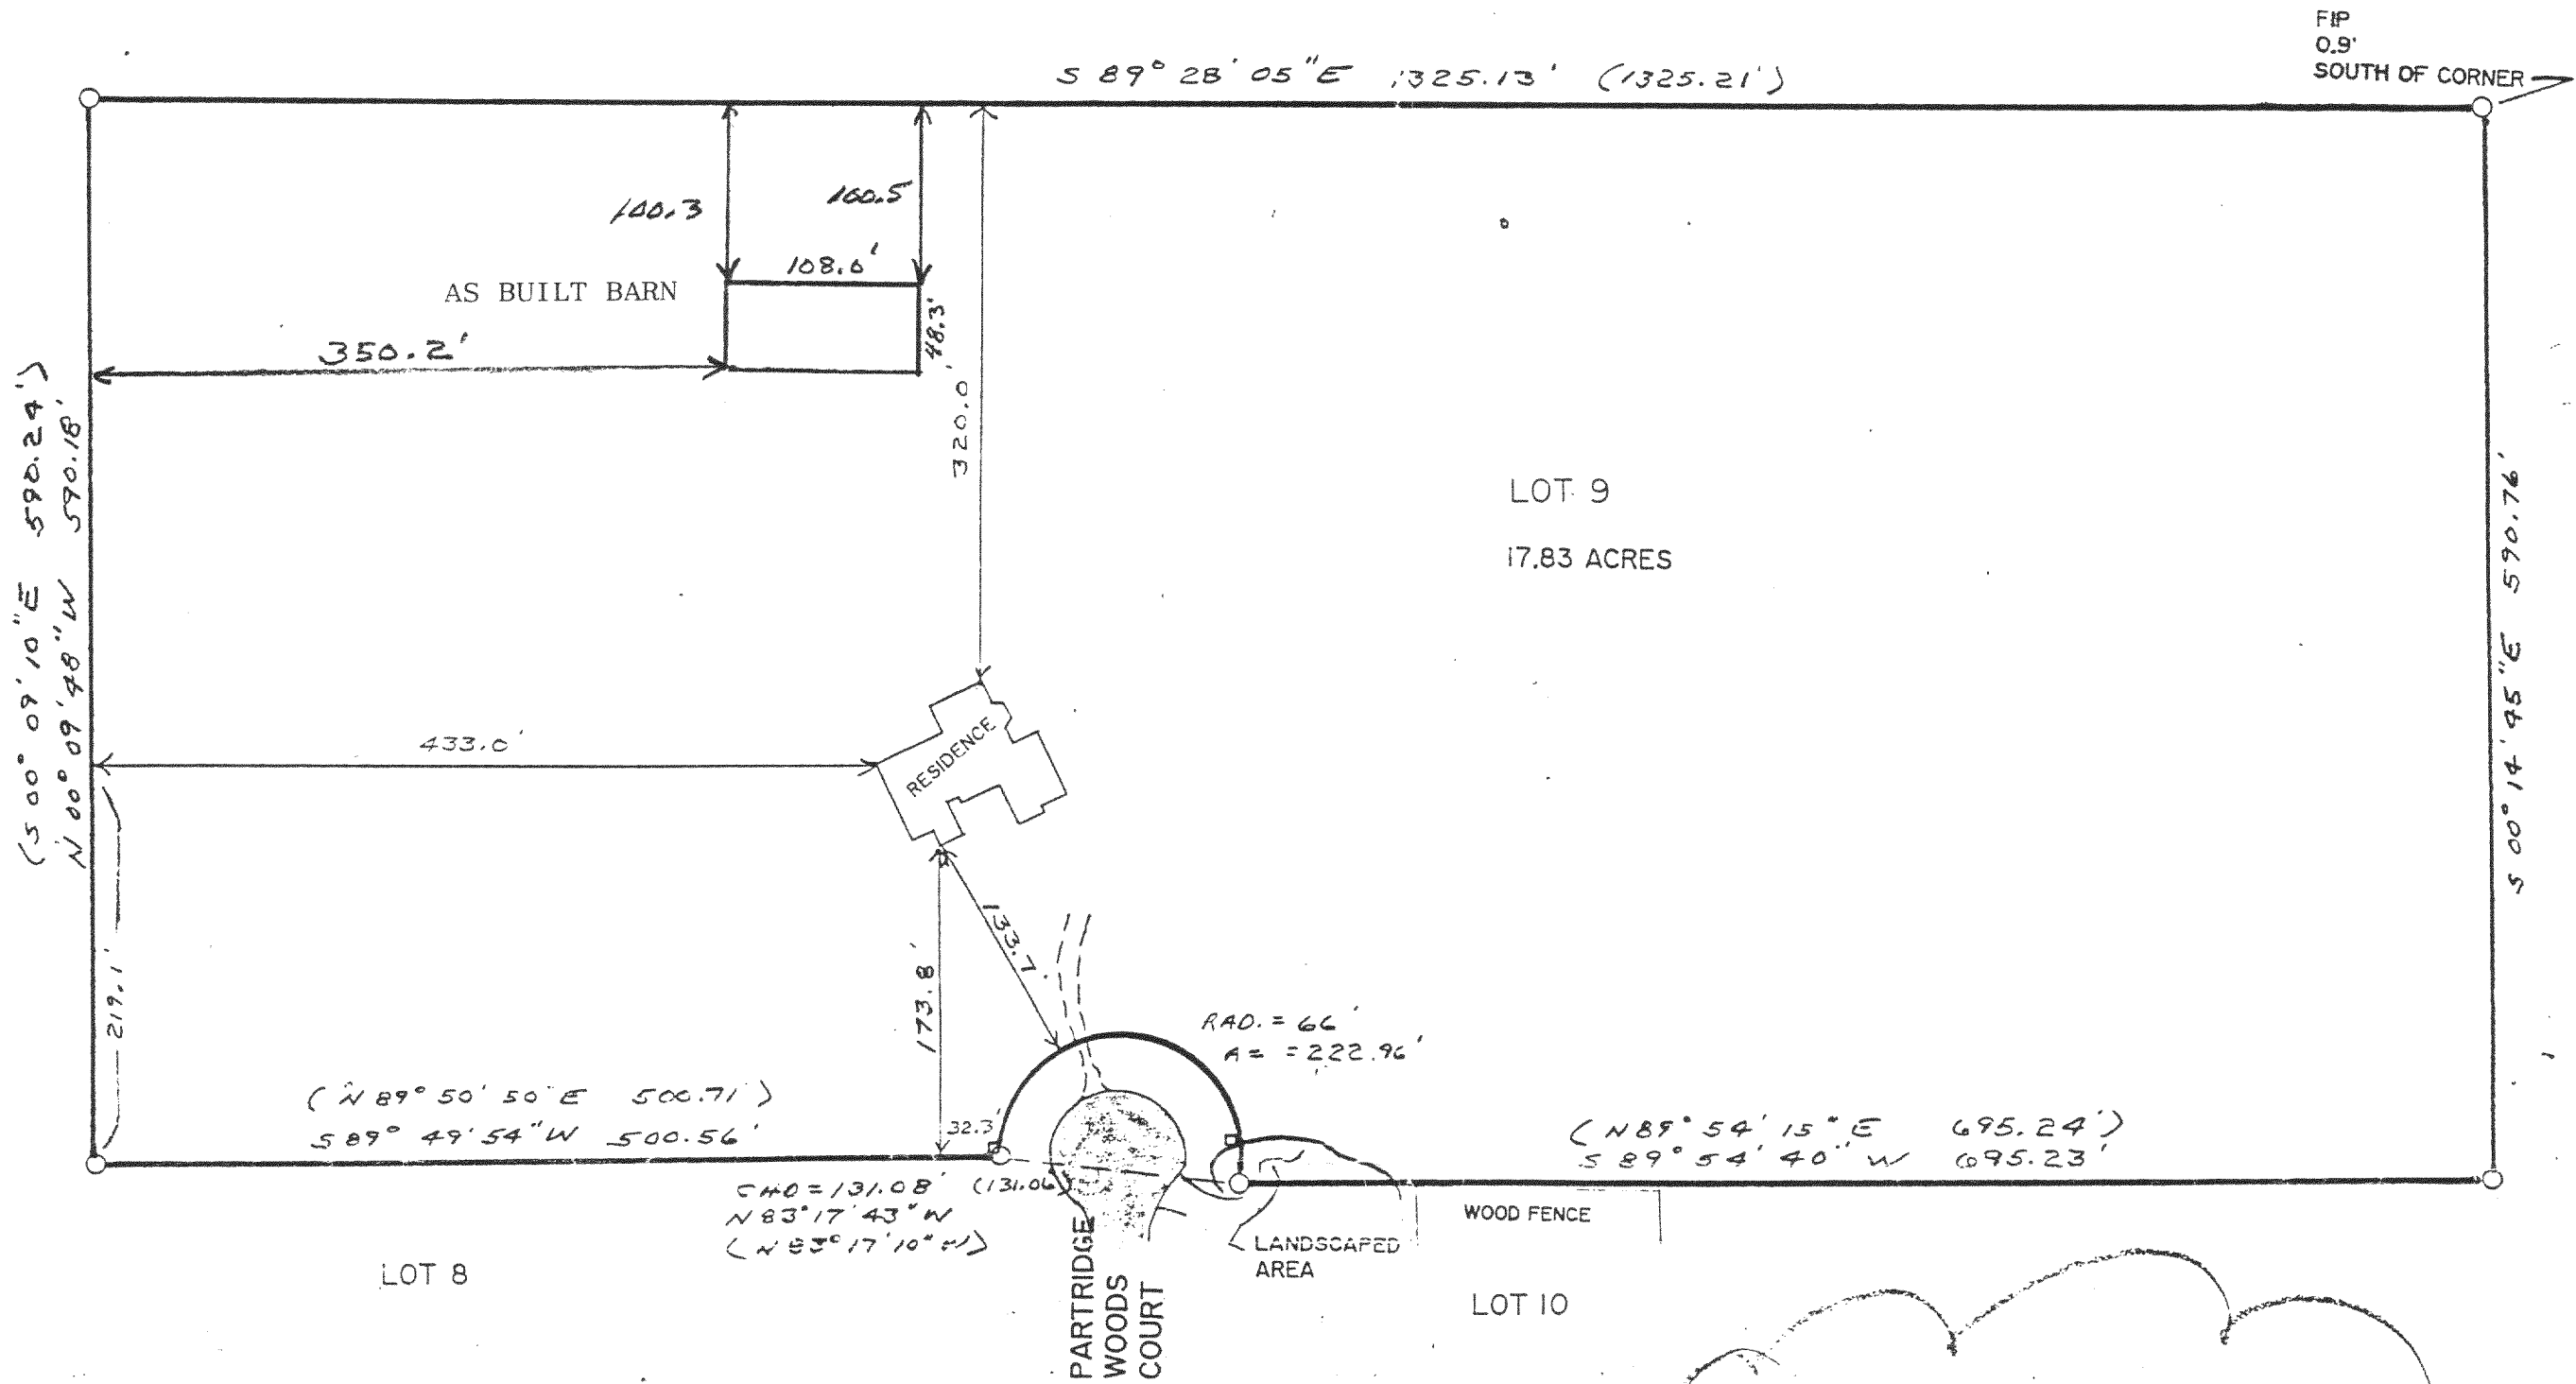




- LEGEND**
- = FOUND IRON PIPE STAKE
 - (---) = RECORDED AS
 - = TELEPHONE CONTROL BOX

NOTE: COPIES OF THIS MAP TO WHICH THE FOLLOWING CERTIFICATE WILL APPLY ARE BLUE LINE PRINTS SHOWING SURVEYOR'S ORIGINAL SEAL AND SIGNATURE IN BLACK INK. COPIES BY ANY OTHER MEANS MAY HAVE ALTERATIONS WHICH DO NOT REPRESENT THE SURVEYOR'S WORK PRODUCT.

I HEREBY CERTIFY THAT THIS PLAT OF SURVEY IS A TRUE AND ACCURATE REPRESENTATION OF THE BOUNDARY LINES OF THE SUBJECT PARCEL AND SHOWS THE SIZE AND LOCATION OF ALL BUILDINGS ON THE PARCEL SHOWN HEREON, TO THE BEST OF MY PROFESSIONAL KNOWLEDGE AND BELIEF. THIS SURVEY IS MADE FOR THE USE OF THE PRESENT OWNERS OF THE PROPERTY, AND ALSO THOSE WHO PURCHASE, MORTGAGE, OR GUARANTEE THE TITLE THERETO WITHIN ONE YEAR FROM THE DATE HEREOF.

DATED: 05/11/1993 *Peter S. Gordon*
PETER S. GORDON RLS 2101

REVISED
5/14/99 TO SHOW
BARN AS BUILT

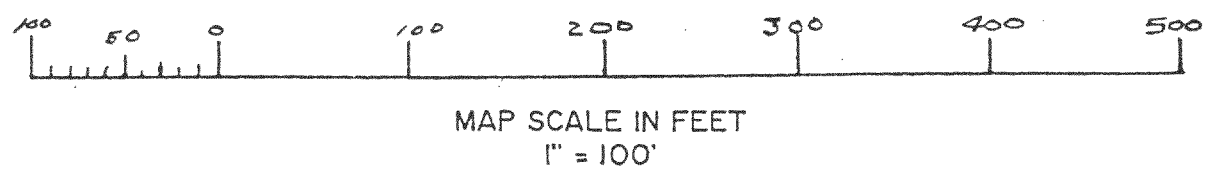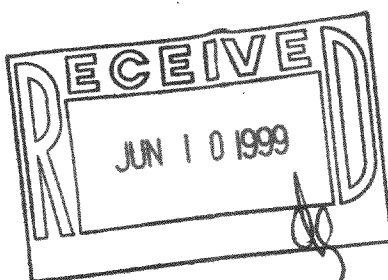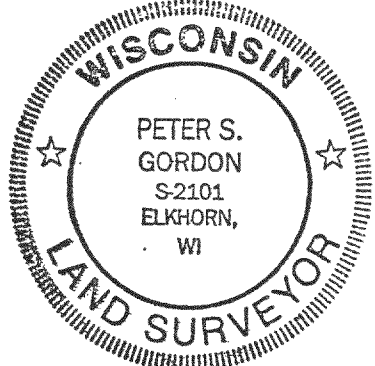

NPRW-9

218-1066

PLAT OF SURVEY
LOT 9 IN PARTRIDGE WOODS
A SUBDIVISION LOCATED IN THE NE 1/4, SE 1/4, & SW 1/4
SECTION 23, TOWN 2 NORTH, RANGE 18 EAST
WALWORTH COUNTY, WISCONSIN

FARRIS, HANSEN & ASSOCIATES, INC.
Engineering, Architecture, Surveying
7 Ridgeway Court P.O. Box 437
ELKHORN, WISCONSIN 53121
Office: (414) 723-2098
Fax: (414) 723-5886

REVISIONS

PROJECT NO
3829
DATE
05/11/93
SHEET NO.
1 OF 1

WORK ORDERED BY:

WORK ORDERED BY: BONNIE HATHAWAY
2330 PARTRIDGE WOODS
BURLINGTON, WI. 53105