


PLAT OF SURVEY

EXISTING RESIDENCE

UNDER CONSTRUCTION

SCALE 1" = 10 FEET

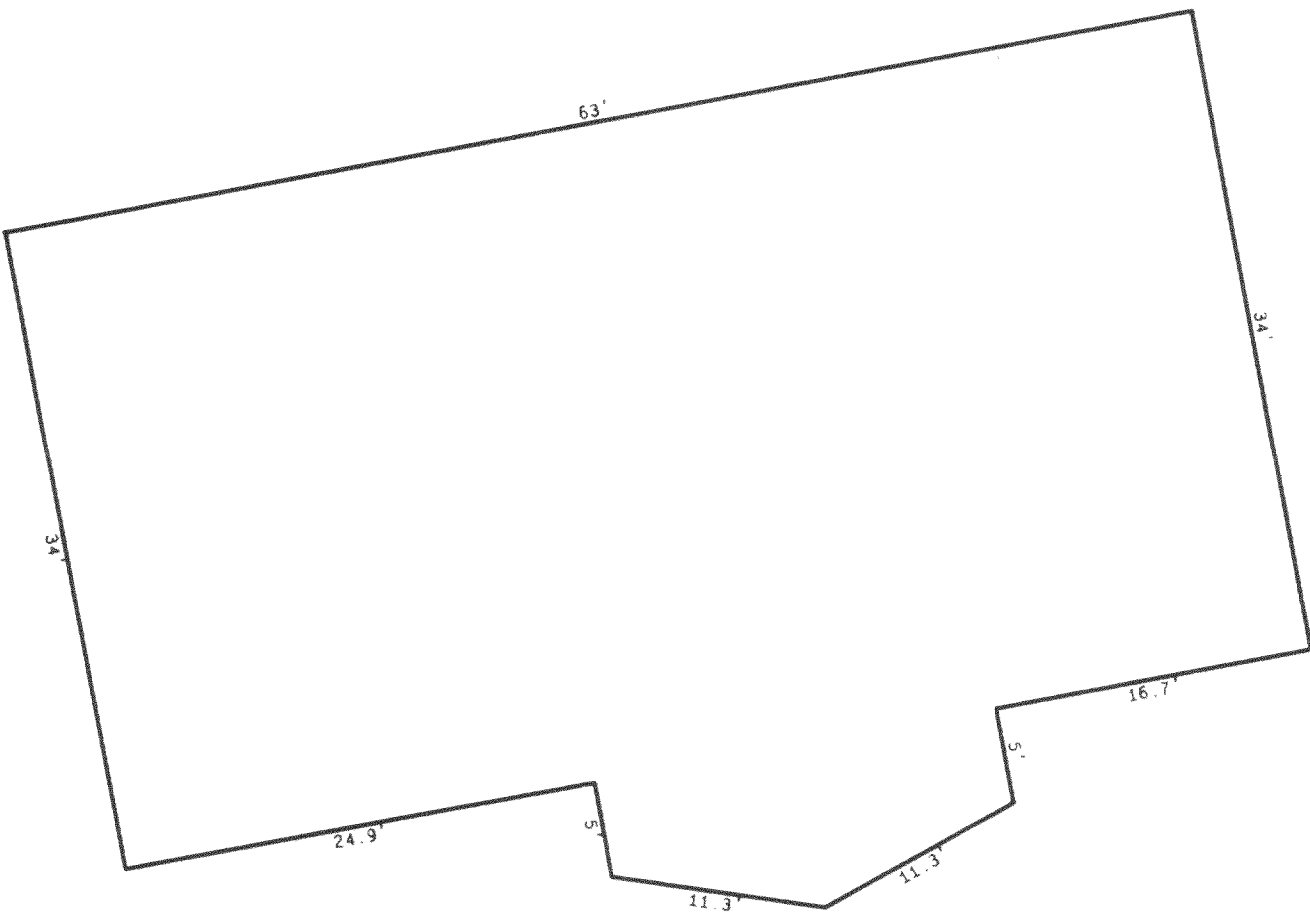

NOTE:
SEE RECORDED CERTIFIED SURVEY MAP FOR ADDITIONAL INFORMATION

CERTIFIED SURVEY MAP NO. 3078 VOL. 16 DOC. NO. 407781
PAGES 255 - 258


A CERTIFIED SURVEY MAP OF PART OF THE NORTHEAST 1/4 OF THE NORTHWEST 1/4 AND INCLUDING LOT 1 OF CERTIFIED SURVEY MAP NO. 2606 AS RECORDED IN VOL. 13 AS PAGES 116 AND 117 AS DOCUMENT NO. 309243, LOCATED IN THE NORTHEAST 1/4 OF THE NORTHWEST 1/4 OF SECTION 24, T. 2 N., R. 18 E., WALWORTH COUNTY, WISCONSIN.

OWNER: KELLE E. TOLNE HOLEHOUSE
1529 HIGHLAND DR.
LAKE GENEVA, WI 53147

Kenneth B. Abernathy Jr.
Wis. Reg. No. S-1594
Abernathy & Associates
W4056 Bray Road
Elkhorn, Wisconsin 53121
(414) 723-4260
DATE 12/31/98

THIS IS A LOT LINE
ADJUSTMENT (SEE NOTES SHEET 3)
VOL. 661 P. 1759 DOC. NO. 406456

NORTH 1/4 CORNER
SEC. 24-2-18
(rd. conc. mon. with brass cap)

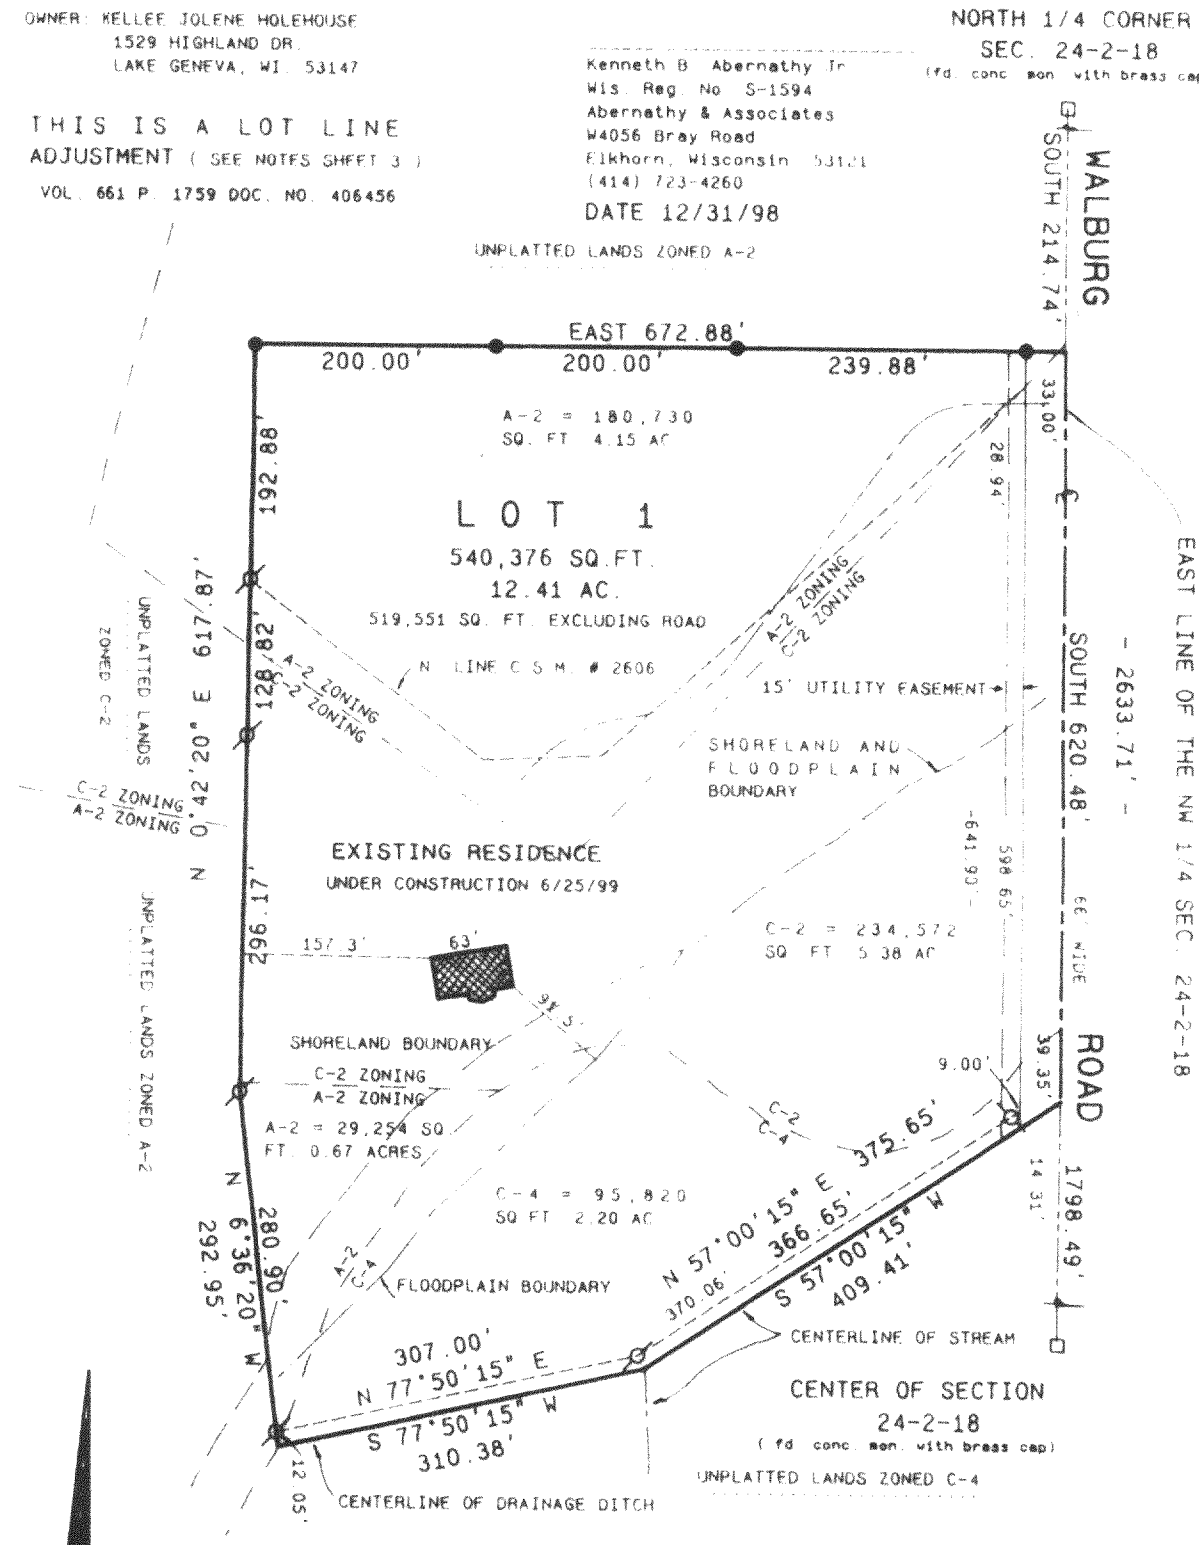


BASIS FOR BEARINGS
THE EAST LINE OF THE
NORTHWEST 1/4 OF SECTION 24,
T. 2 N., R. 18 E. WAS ASSUMED
TO BEAR NORTH AS PREVIOUSLY
PLATTED

LEGEND
1" DIA. IRON PIPE FOUND
3/4" DIA. IRON ROD 24" LONG,
WEIGHING 1.5 LBS./LIN. FT. SET
WALWORTH COUNTY SECTION CORNER
FOUND, CONC. WITH BRASS CAP

SOIL TYPES ST. CHARLES SILT
LOAM, CASCO RODMAN COMPLEX,
SEBEWA SILT LOAM, NAVAN SILT
LOAM, ADRIAN MUCK

SHEET 1 of 4 SHEETS
proj. no. 98.1018

- Legend
- 1" FOUND IRON PIPE
 - FOUND IRON ROD
 - FOUND BRASS CAPPED MONUMENT
 - FOUND CONCRETE MONUMENT
 - + CHISEL CUT IN CONCRETE
 - SET IRON ROD, 24" LONG, WEIGHING 1.5 LBS. LINEAL FT., 3/4" DIA.
 - SET IRON ROD, 30" LONG, WEIGHING 4.5 LBS. LINEAL FT., 1 1/16" DIA.
 - (xx) RECORDED AS DIMENSION
 - x-x- EXISTING FENCE

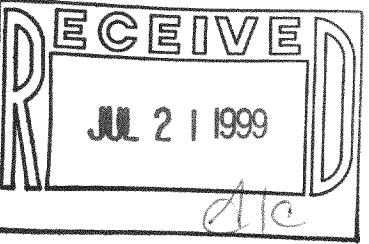

SCALE: 1" = 160 FEET



"I hereby certify that the above described property has been surveyed by me or under my direction and that the above map is a true representation thereof and shows the size and location of the property, its exterior boundaries, the location of all visible structures and dimensions of all principal buildings thereon, boundary fences, apparent easements, roadways and visible encroachments, if any."
"This survey is made for the use of the present owners of the property, and also those who purchase, mortgage or guarantee the title thereto within one year from date hereof."
Kenneth B. Abernathy Jr.
KENNETH B. ABERNATHY, JR.
WISCONSIN REGISTERED LAND SURVEYOR,
S-1594
Date: JUNE 25, 1999 Job No. 98.1018

NA-3078-1 218-1107