



PLAT OF SURVEY

PATHFINDER SURVEYING
FORMERLY KOLB LAND CONSULTING
929 WILLIAMS STREET LAKE GENEVA, WI. 53147
(262) 248-3697


ORDERED BY: R J AMANN BUILDERS

DATE: 1-7-2000

DESCRIPTION: LOT 2 OF CERTIFIED SURVEY MAP NO. 1188 A C.S.M.
BEING LOT 5 OF LYON'S INDUSTRIAL PARK AND LOCATED
IN THE SE 1/4 OF SECTION 19, T2N, R18, WALWORTH
COUNTY, WISCONSIN.

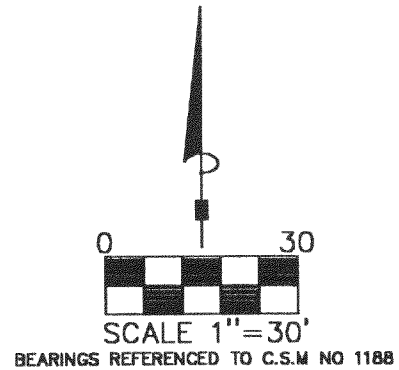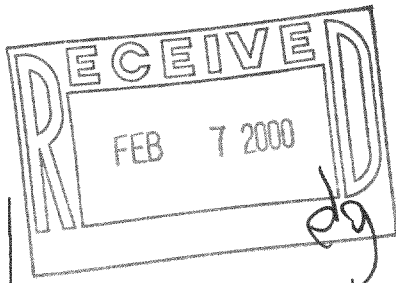

CREST DRIVE (66') WIDE

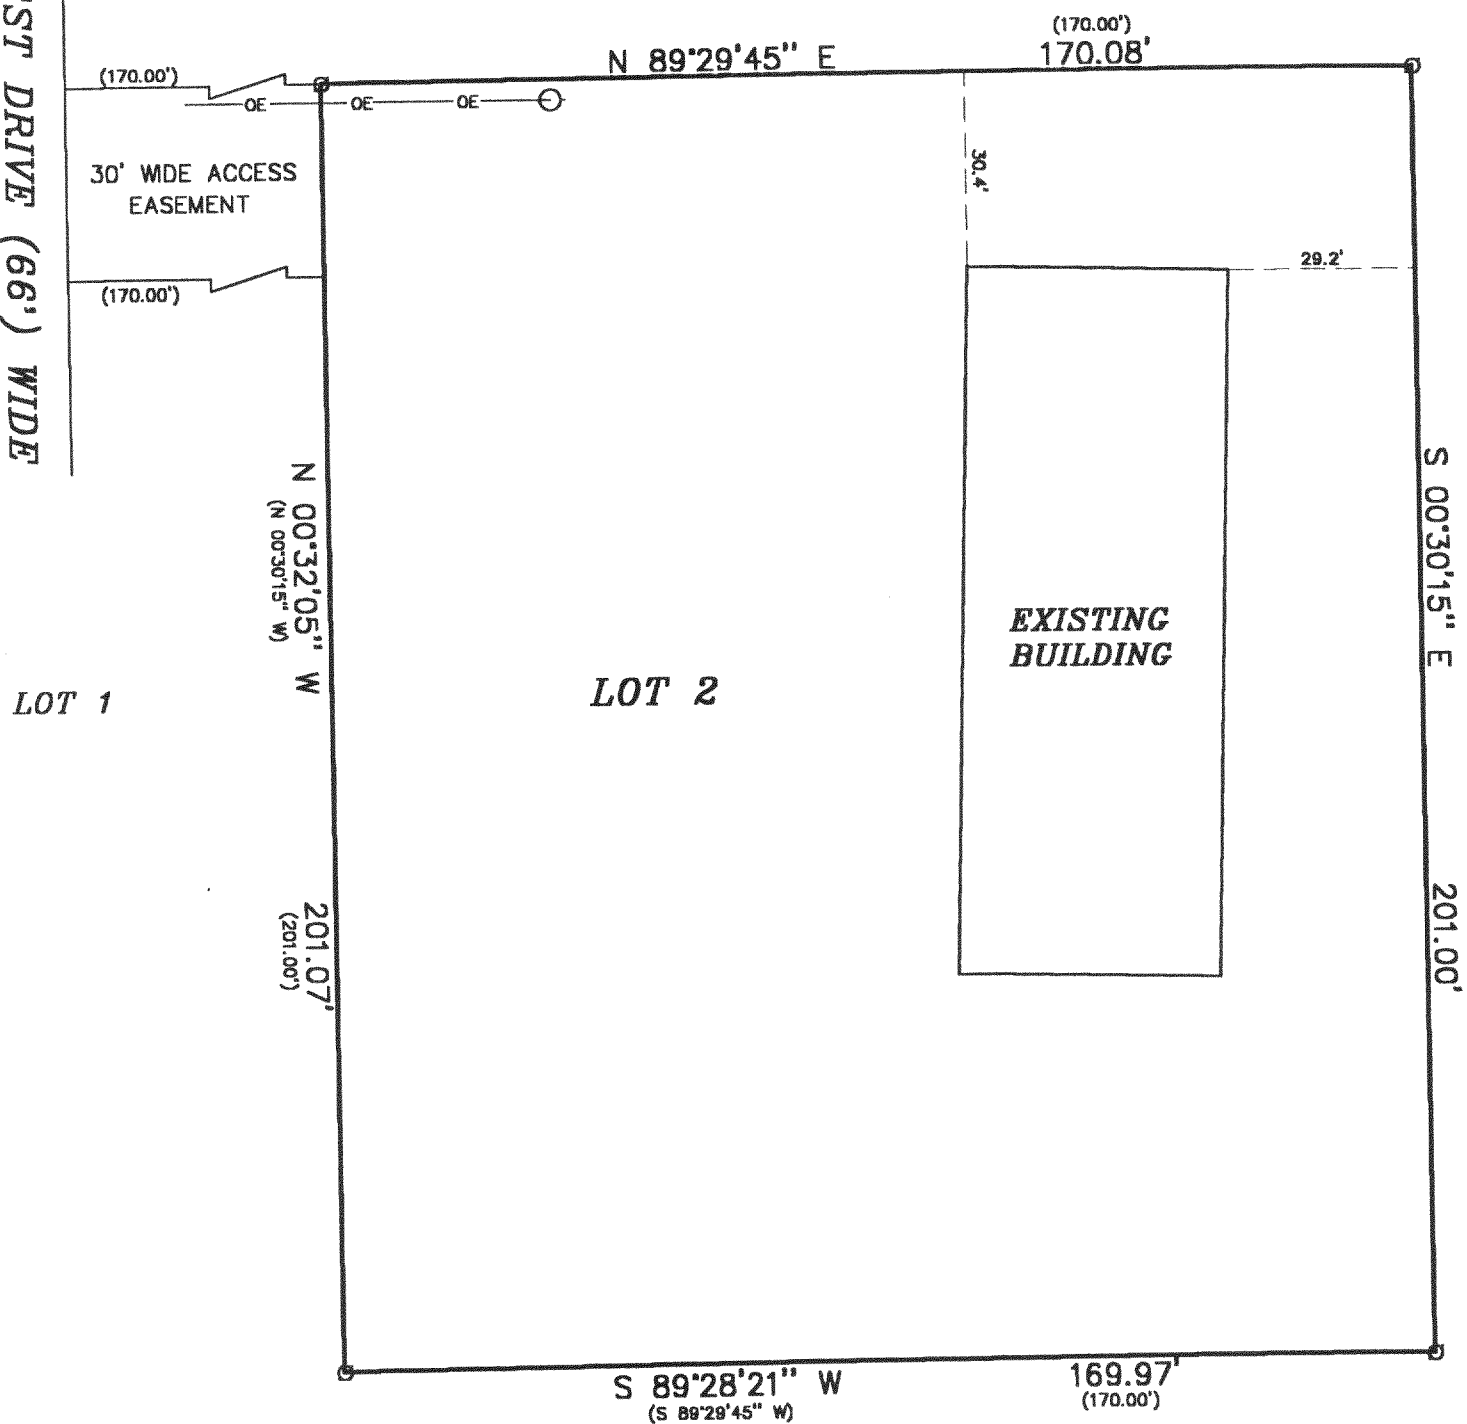

THE ABOVE MAP IS A TRUE REPRESENTATION THEREOF AND
SHOWS THE SIZE AND LOCATION OF ALL THE PROPERTY,
EXTERIOR BOUNDARIES, THE LOCATION OF ALL VISIBLE
BOUNDARY FENCES, APPARENT EASEMENTS, ROADWAYS
AND VISIBLE ENCROACHMENTS, IF ANY

THIS SURVEY IS MADE FOR THE USE OF THE PRESENT
OWNERS OF THE PROPERTY, AND ALSO THOSE WHO
PURCHASE, MORTGAGE OR GUARANTEE TITLE THERETO
WITHIN ONE (1) YEAR FROM DATE HERETO.

LEGEND

- ⊗ FOUND IRON PIPE
- ⊙ POWER POLE
- (XXXXX) RECORDED AS
- OE— OVERHEAD UTILITIES



John P. Krott
JOHN P. KROTT, R.L.S. 2258

NOTE: THIS IS NOT A CERTIFIED COPY
UNLESS SEAL IS IN RED.

JOB NUMBER # 99299 NA 1188 00002

NA-1188-2

218-1139