


HAROLD H. KOLB
REGISTERED PROFESSIONAL LAND SURVEYOR
LAKE GENEVA, WISCONSIN

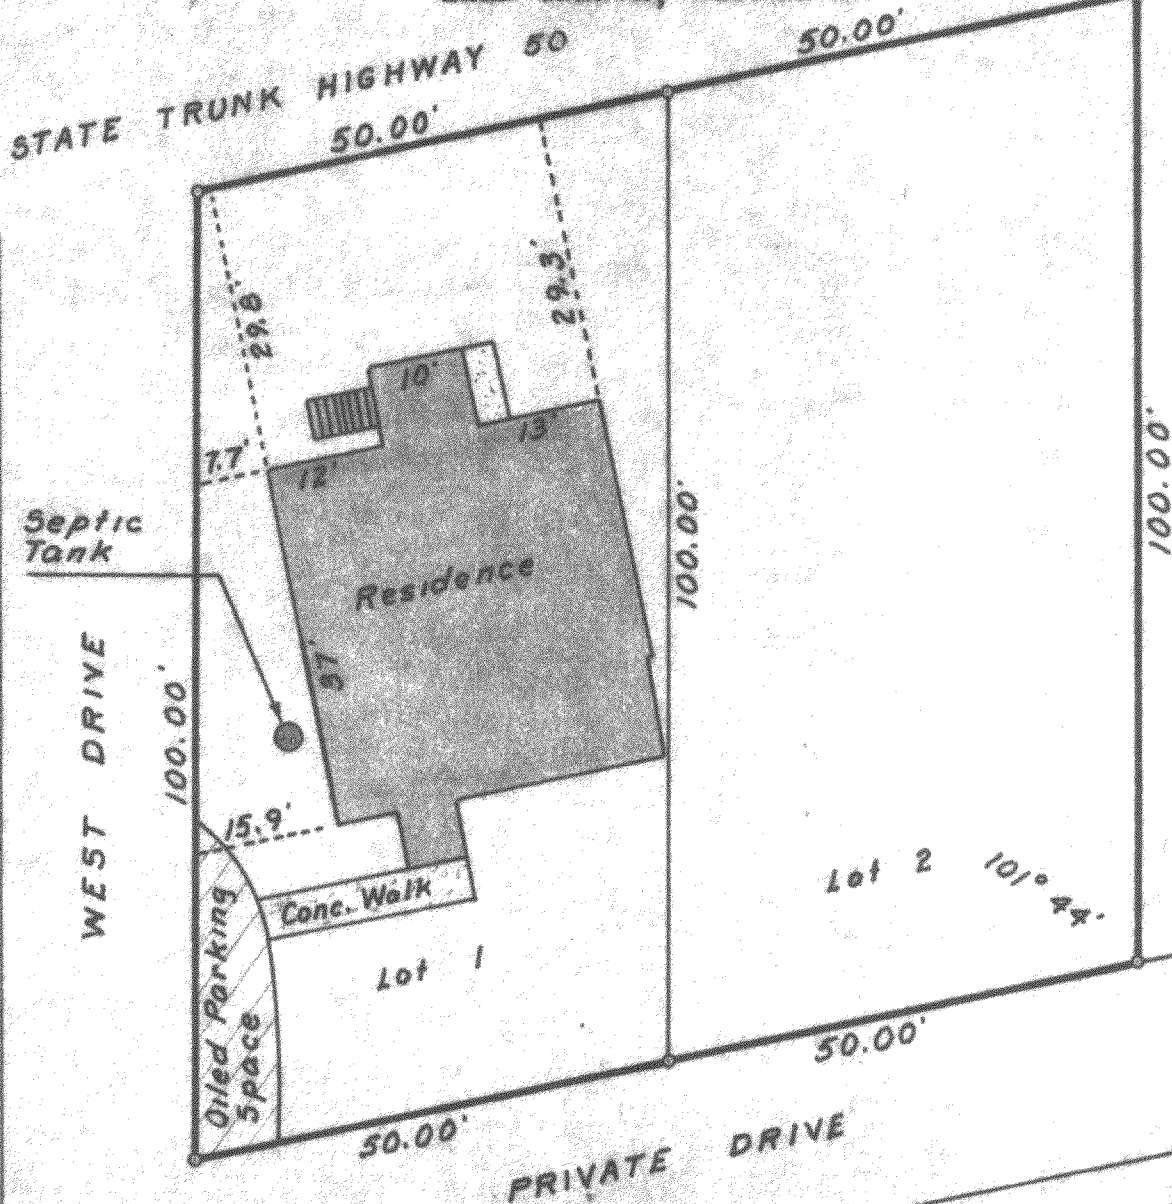

PLAT OF SURVEY OF
Lots 1 and 2, Lake Geneva Golf Hills,
located in Section 31, T 2 N, R 18 E, Walworth
County, Wisconsin.
State of Wisconsin)
County of Walworth)

I certify that I have surveyed the above described
property and that the above plat is a correct survey and
true representation thereof and correctly shows the
exterior boundary lines and location of buildings and other
improvements on said property and the correct measurements
thereof.

Dated this 28th day of March, 1963.

Harold H. Kolb

Harold H. Kolb, Wisconsin Surveyor, S-157

o - Iron Pipe
Found

218-115
~~118-228~~