



PLAT OF SURVEY

OF

J.K. SURVEYING INC.
N3705 WILLOW BEND LANE
LAKE GENEVA, WI. 53147
262-248-369

LOTS 113 AND 114 LAKE GENEVA GOLF HILL SUBDIVISION, LOCATED IN THE TOWN OF LYONS (DEEDED LINN), WALWORTH COUNTY, WISCONSIN. RESERVING, HOWEVER, A LIFE ESTATE IN THE GRANTOR, AND THE WEST 13 FEET OF THE SOUTH 1/2 OF LOT 111 AND THE WEST 13 FEET OF LOT 112.

ORDERED BY : LOLA JOHANSEN
CENTURY 21 SKANDIA REALTY
DELAVER WI.

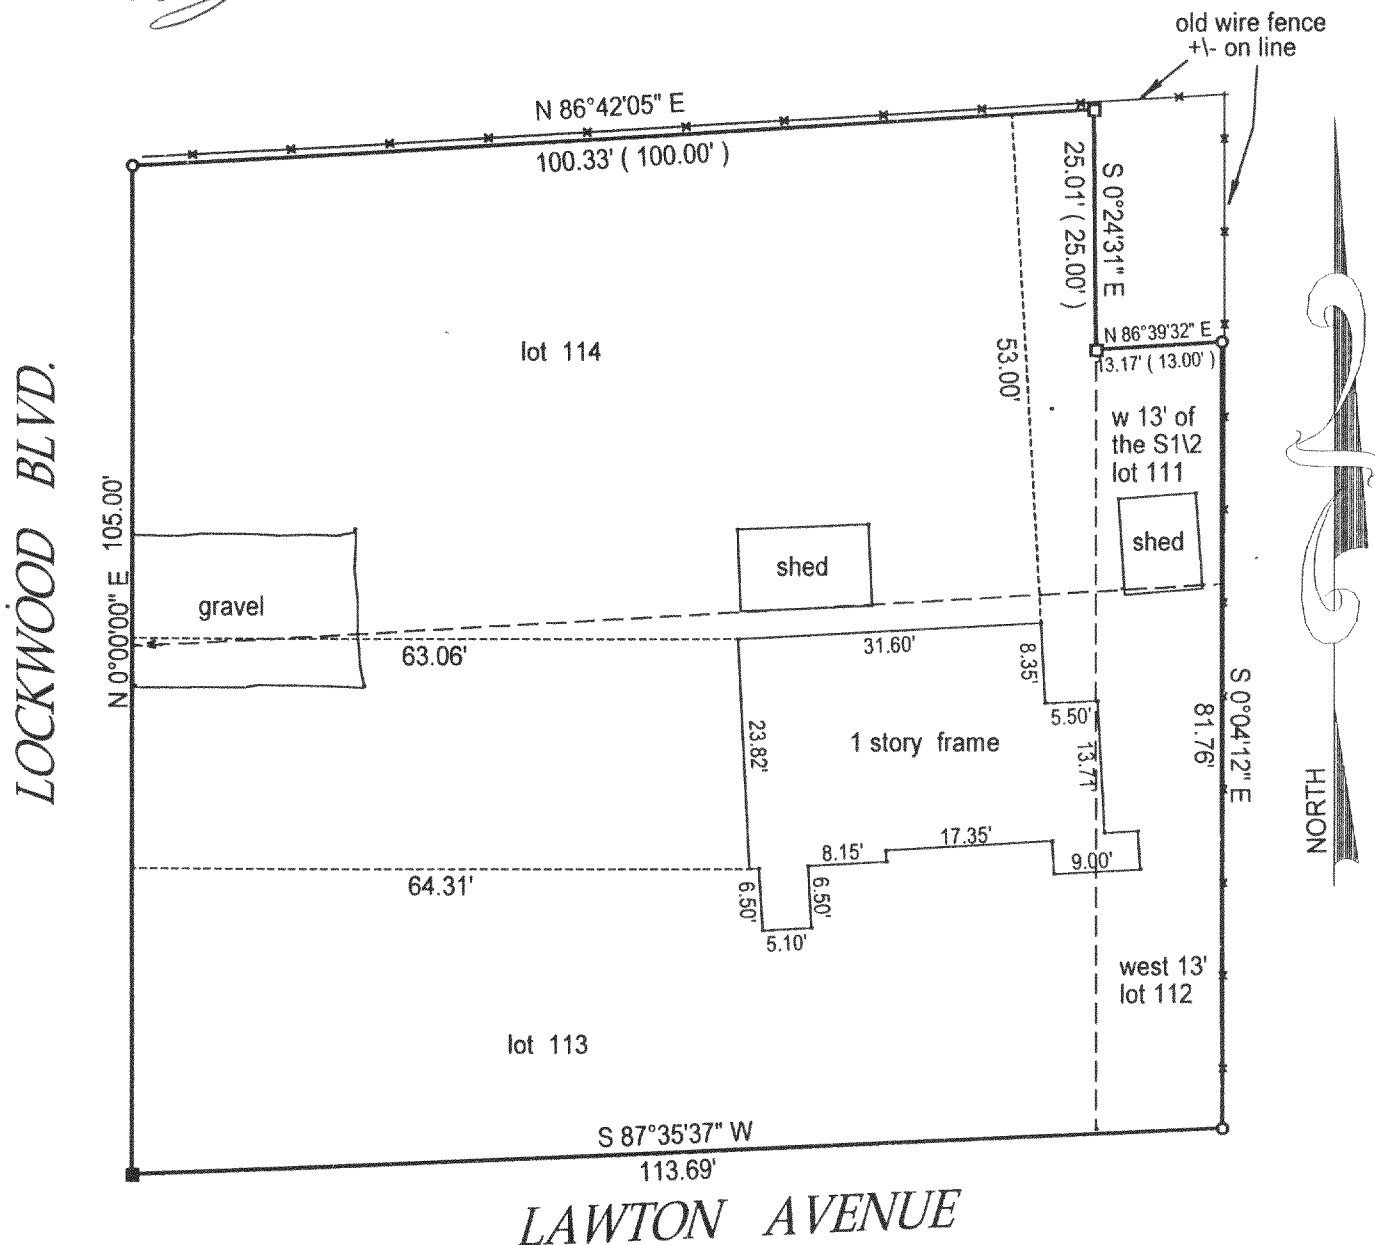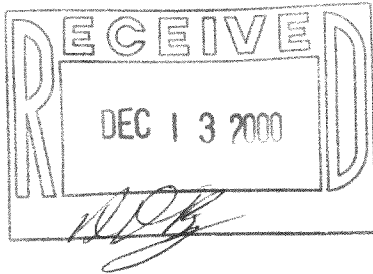

() = recorded as

- = set iron bar
- = found iron bar
- = found iron pipe
- = set iron pipe

COMPARE LEGAL DESCRIPTION ABOVE AND DRAWING WITH DEED. FOR BUILDING RESTRICTIONS AND EASEMENTS NOT SHOWN, REFER TO DEED, ABSTRACT SOURCES AND LOCAL MUNICIPAL CODES. NOTIFY THE SURVEYOR IMMEDIATELY OF ANY DISCREPANCY.

"I hereby certify that I have surveyed the above described property and that the above map is a true representation thereof and shows the size and location of all visible structures, apparent easements and encroachments if any."


This survey is made for the present owners of the property, and those who purchase, mortgage, or guarantee the title thereto, within one year from the date hereof.

JOB# 00-511

SCALE: 1"=20'

TAX KEY #
NGH 00088
NGH 00089

DATED THIS 9 TH DAY OF October 20 00

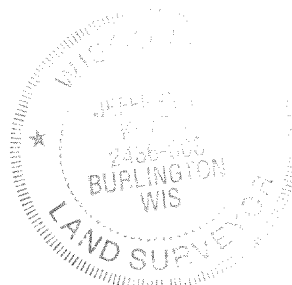

Jeffrey L. Kimps
JEFFREY L. KIMPS S - 2436
Wisconsin Registered Land Surveyor
(original if signed in red)

NGH-88
NGH-89 218-1226