


Wisconsin Registered Land Surveyor S-1594

**W4056 BRAY RD.
ELKHORN, WI. 53121
PHONE: (262) 723-4260 (OFFICE)
(262) 723-7209 (FAX)
Email: abernathy@elknet.net**

LOT 1 OF CERTIFIED SURVEY MAP NUMBER 1707, LOCATED IN THE SW 1/4 OF THE SW 1/4 OF SECTION 28, TOWN 2 NORTH, RANGE 18 EAST, LYONS TOWNSHIP, WALWORTH COUNTY, WISCONSIN, EXCEPTING THEREFROM THAT PROPERTY CONVEYED TO THE STATE OF WISCONSIN, DEPARTMENT OF TRANSPORTATION, AS RECORDED IN VOLUME 659, PAGE 7923, DOCUMENT NO. 401280 AS FOUND IN WALWORTH COUNTY RECORDS.

OWNER: EXOTIC ENTERPRISES, INC.
N3010 S.T.H. "67"
LAKE GENEVA, WI 53147

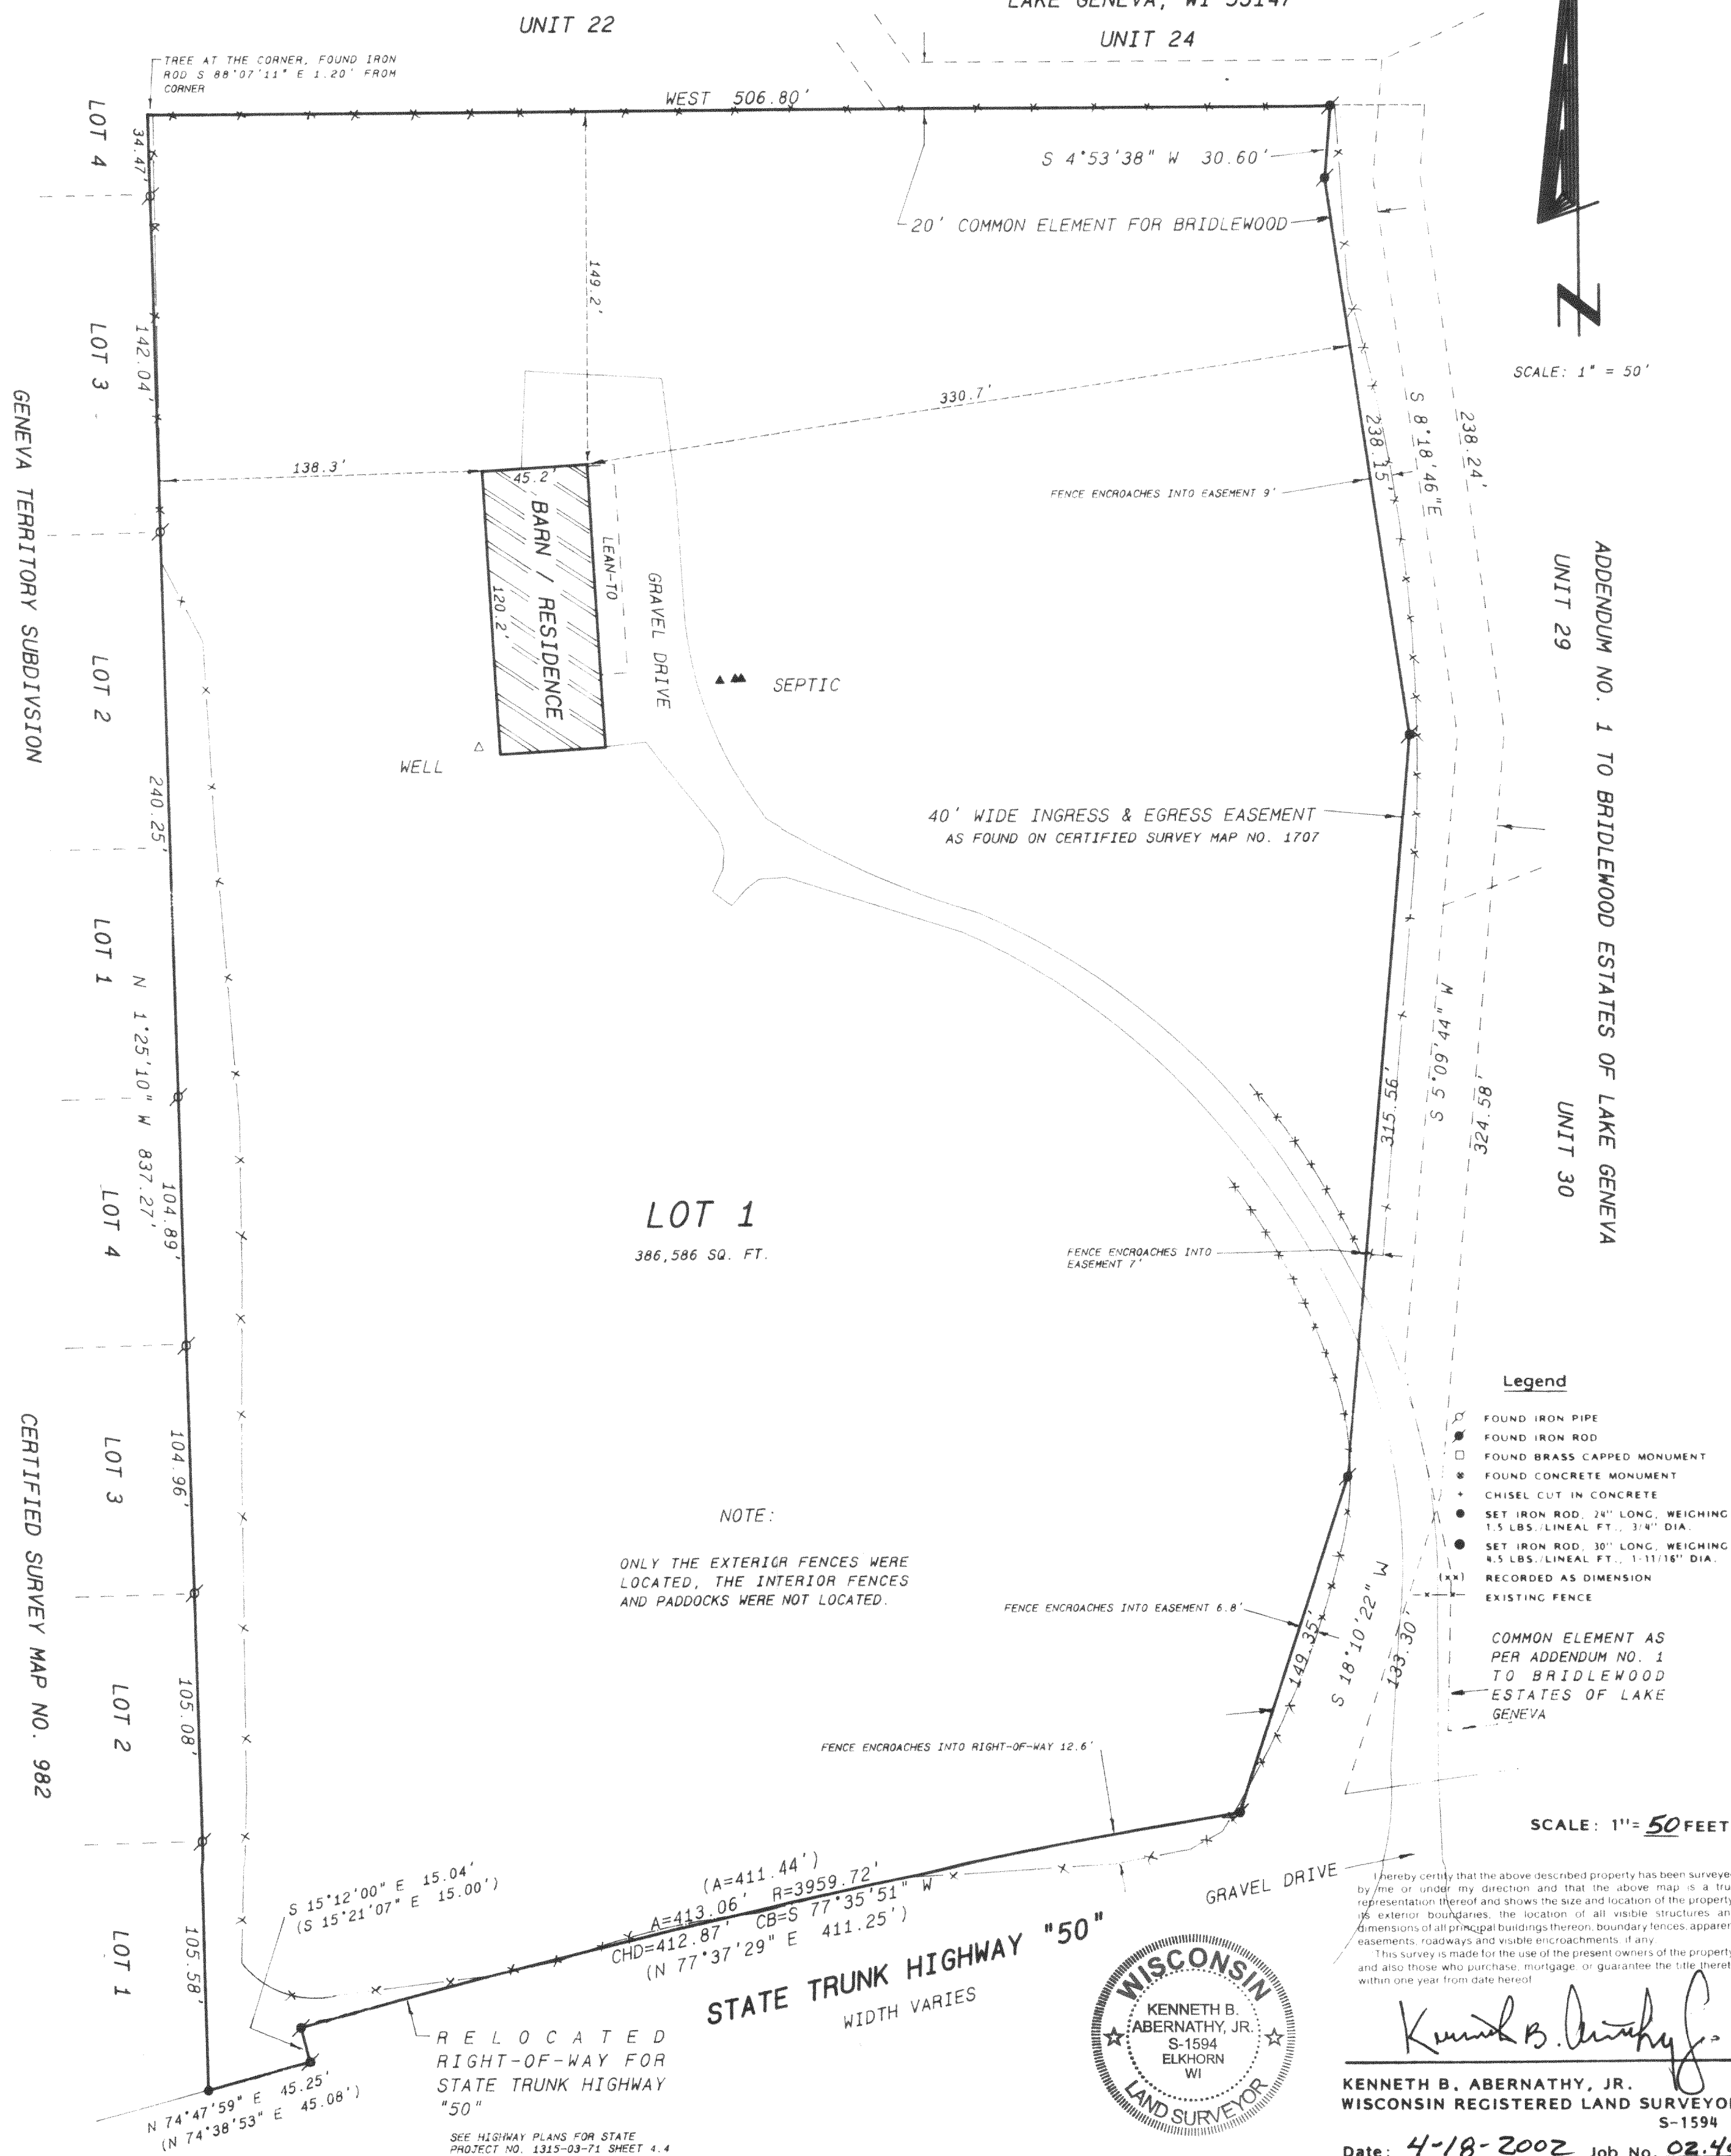

I hereby certify that the above described property has been surveyed by me or under my direction and that the above map is a true representation thereof and shows the size and location of the property, its exterior boundaries, the location of all visible structures and dimensions of all principal buildings thereon, boundary fences, apparent easements, roadways and visible encroachments, if any.

This survey is made for the use of the present owners of the property and also those who purchase, mortgage or guarantee the title thereto within one year from date hereof.

KENNETH B. ABERNATHY, JR.
WISCONSIN REGISTERED LAND SURVEYOR,
S-1594

Date: 4-18-2002 Job No. 02.404

NA-1707-1 218-1299