
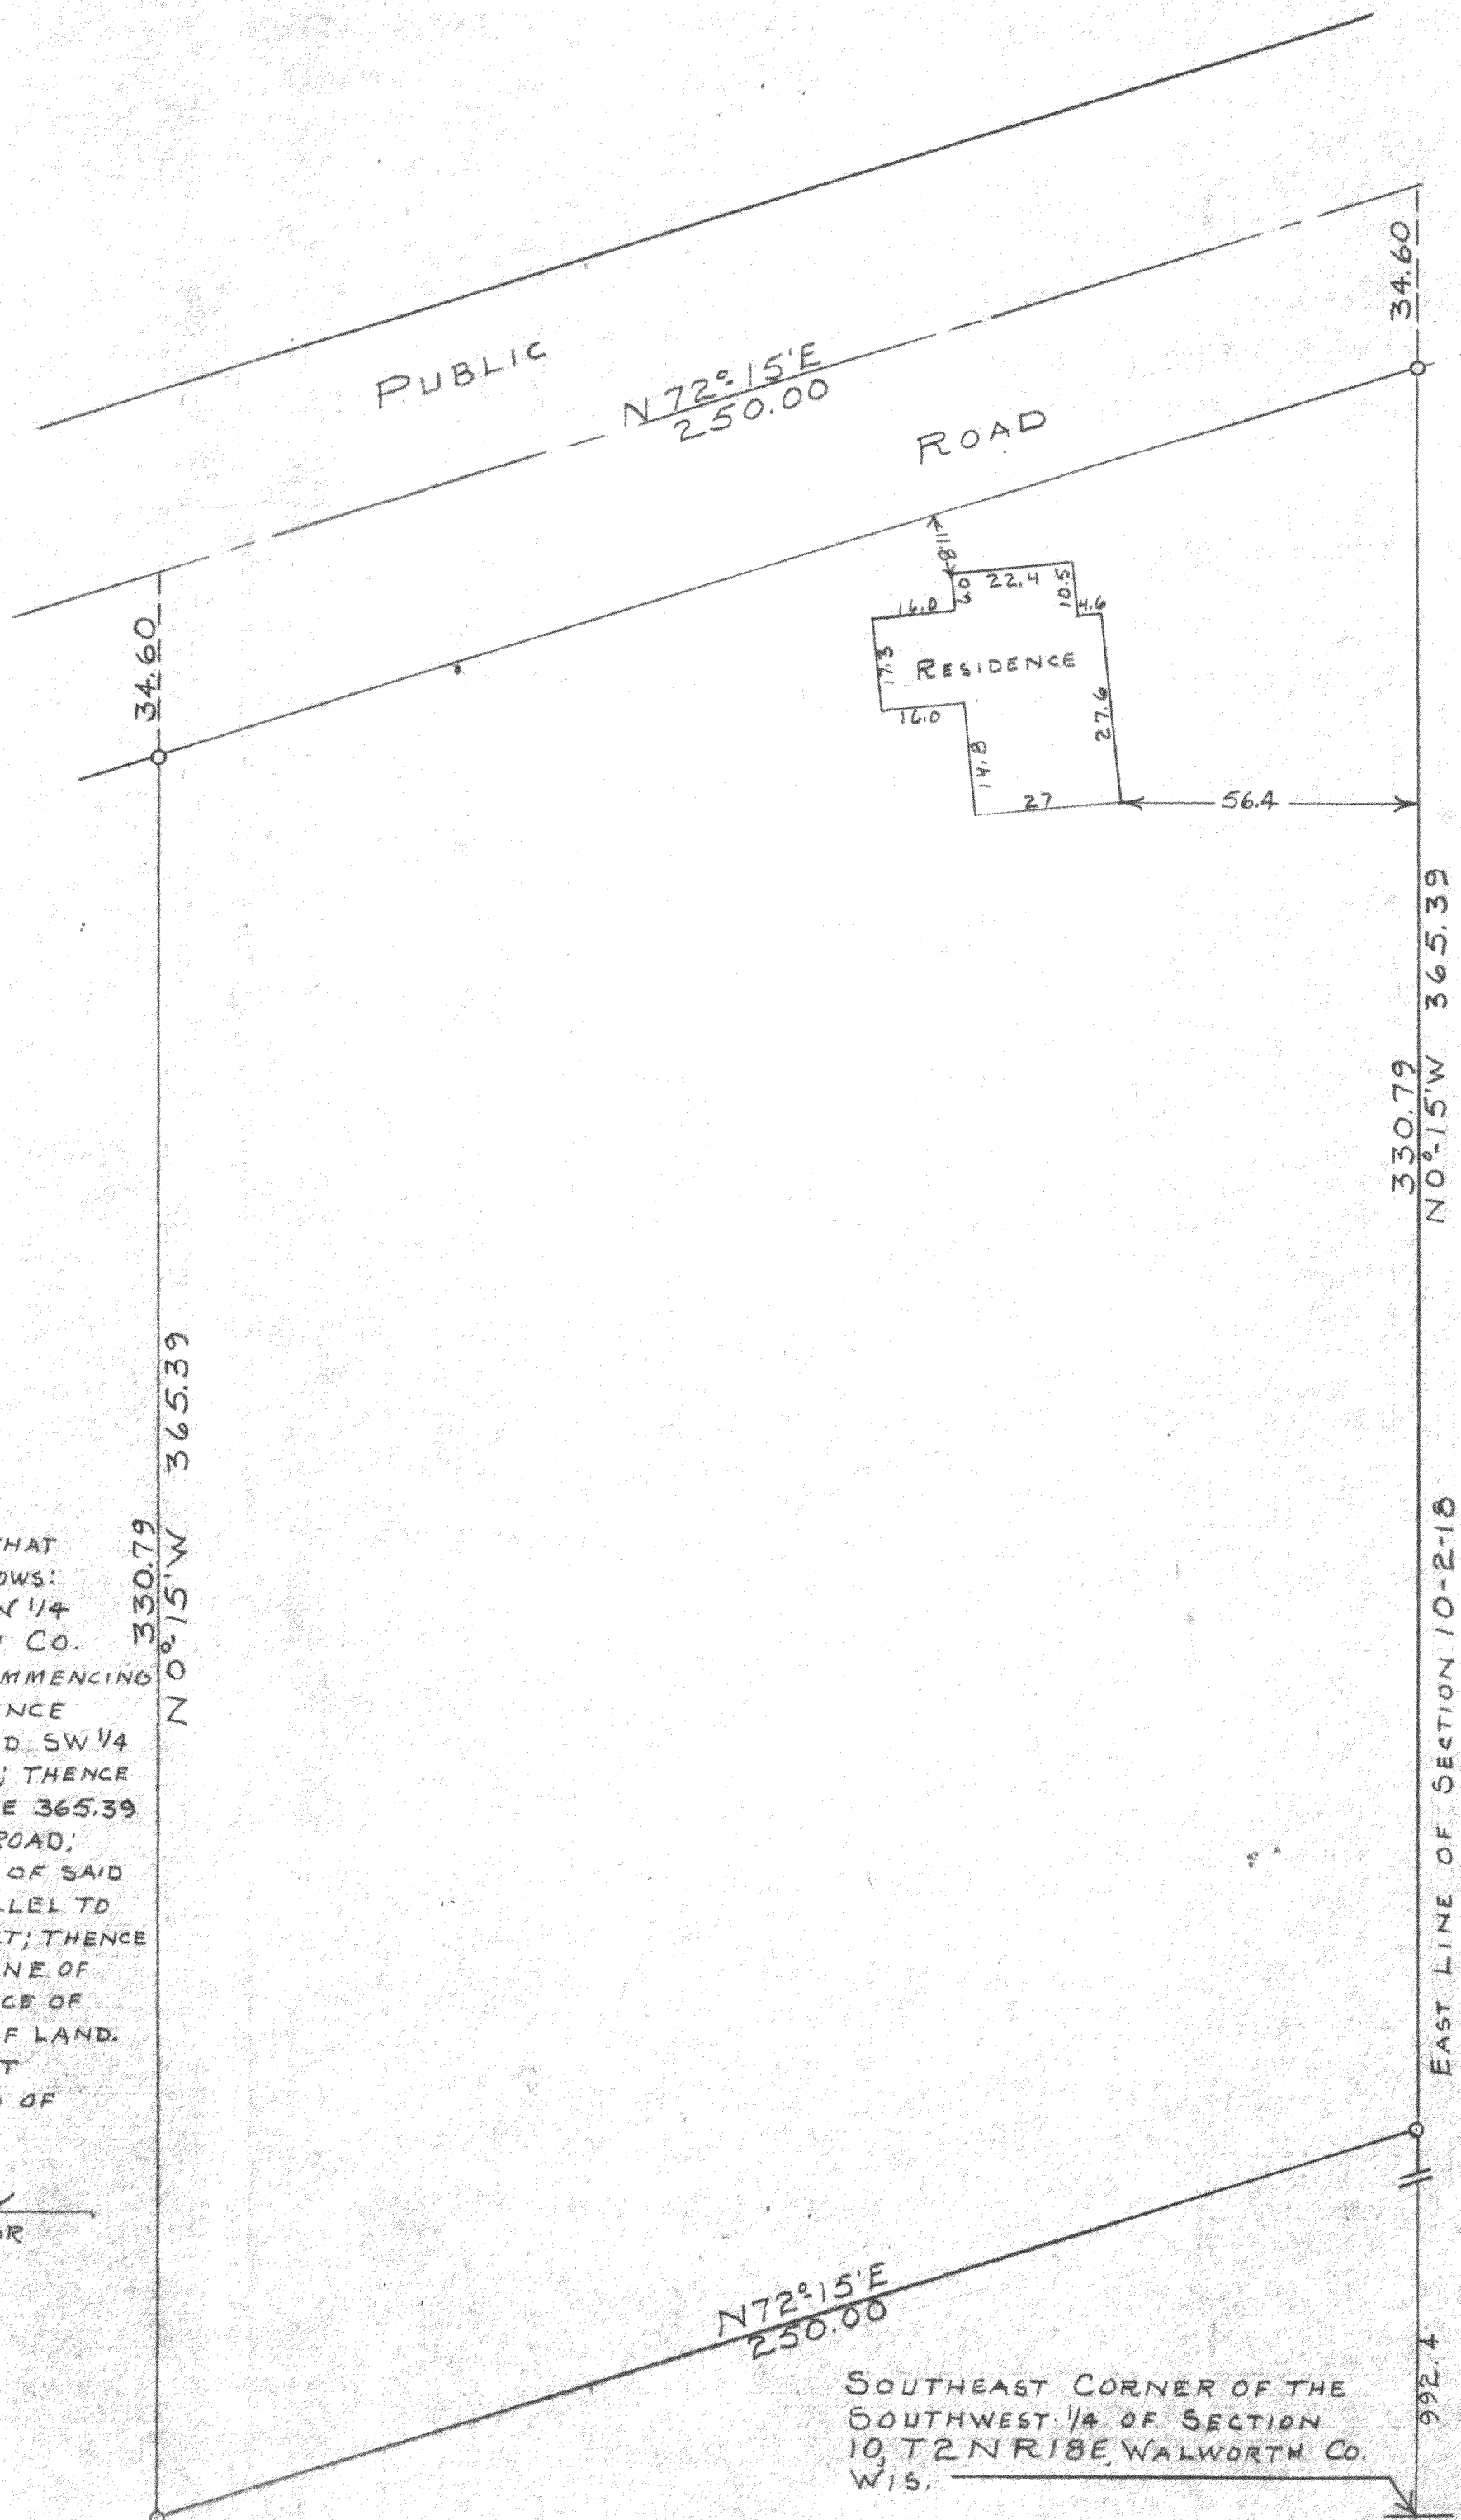


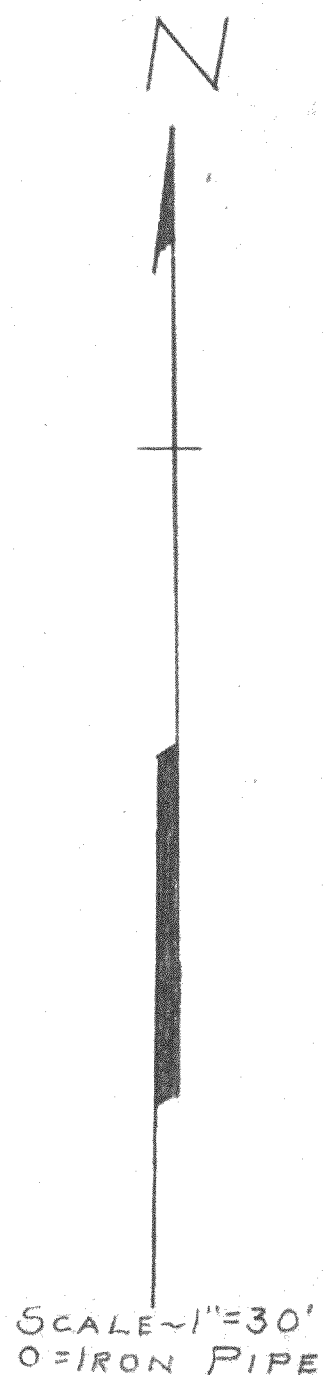

STATE OF WISCONSIN
WALWORTH COUNTY) SS

I, GEORGE T. DUNHAM, DO HEREBY CERTIFY THAT
I HAVE SURVEYED THE PROPERTY DESCRIBED AS FOLLOWS:
A PARCEL OF LAND LOCATED IN THE SW 1/4
OF SECTION 10, T2N R18E OF WALWORTH CO.
WIS. DESCRIBED AS FOLLOWS, TO-WIT: COMMENCING
AT THE SE CORNER OF SAID SW 1/4; THENCE
N 0° 15' W ALONG THE EAST LINE OF SAID SW 1/4
992.4 FEET TO THE PLACE OF BEGINNING; THENCE
CONTINUE N 0° 15' W ALONG SAID EAST LINE 365.39
FEET TO THE CENTERLINE OF THE PUBLIC ROAD;
THENCE S 72° 15' W ALONG THE CENTERLINE OF SAID
ROAD 250.00 FEET; THENCE S 0° 15' E PARALLEL TO
THE EAST LINE OF SAID SW 1/4, 365.39 FEET; THENCE
N 72° 15' E PARALLEL TO THE CENTERLINE OF
SAID ROAD 250.00 FEET TO THE PLACE OF
BEGINNING CONTAINING 2.00 ACRES OF LAND.

AND THAT THE ADJOINING PLAT IS A CORRECT
REPRESENTATION OF THE PROPERTY LINES AND OF
THE IMPROVEMENTS LOCATED THEREON.
SEPT. 23, 1958

George T. Dunham
GEORGE T. DUNHAM, SURVEYOR
DELAVER, WISCONSIN

Ly-10-64 (part of) 218-13