


PLAT OF SURVEY
-OF-


LOTS 120, 121 AND 122 IN LAKE GENEVA GOLF HILLS, TOWN OF LYONS, ACCORDING
TO THE RECORDED PLAT THEREOF, WALWORTH COUNTY, WISCONSIN.

SURVEY FOR: CENTURY 21, AFFILIATED
SURVEY LOCATION: 3153 LOCKWOOD BLVD.

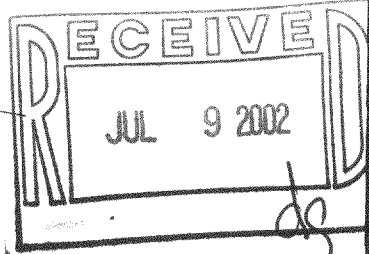

NOTE: CURVES AS SHOWN ARE APPROXIMATE, NO
CURVE DATA IS GIVEN ON THE ORIGINAL
PLAT TO DETERMINE CURVE DATA.

LOCKWOOD BOULEVARD
50' WIDE

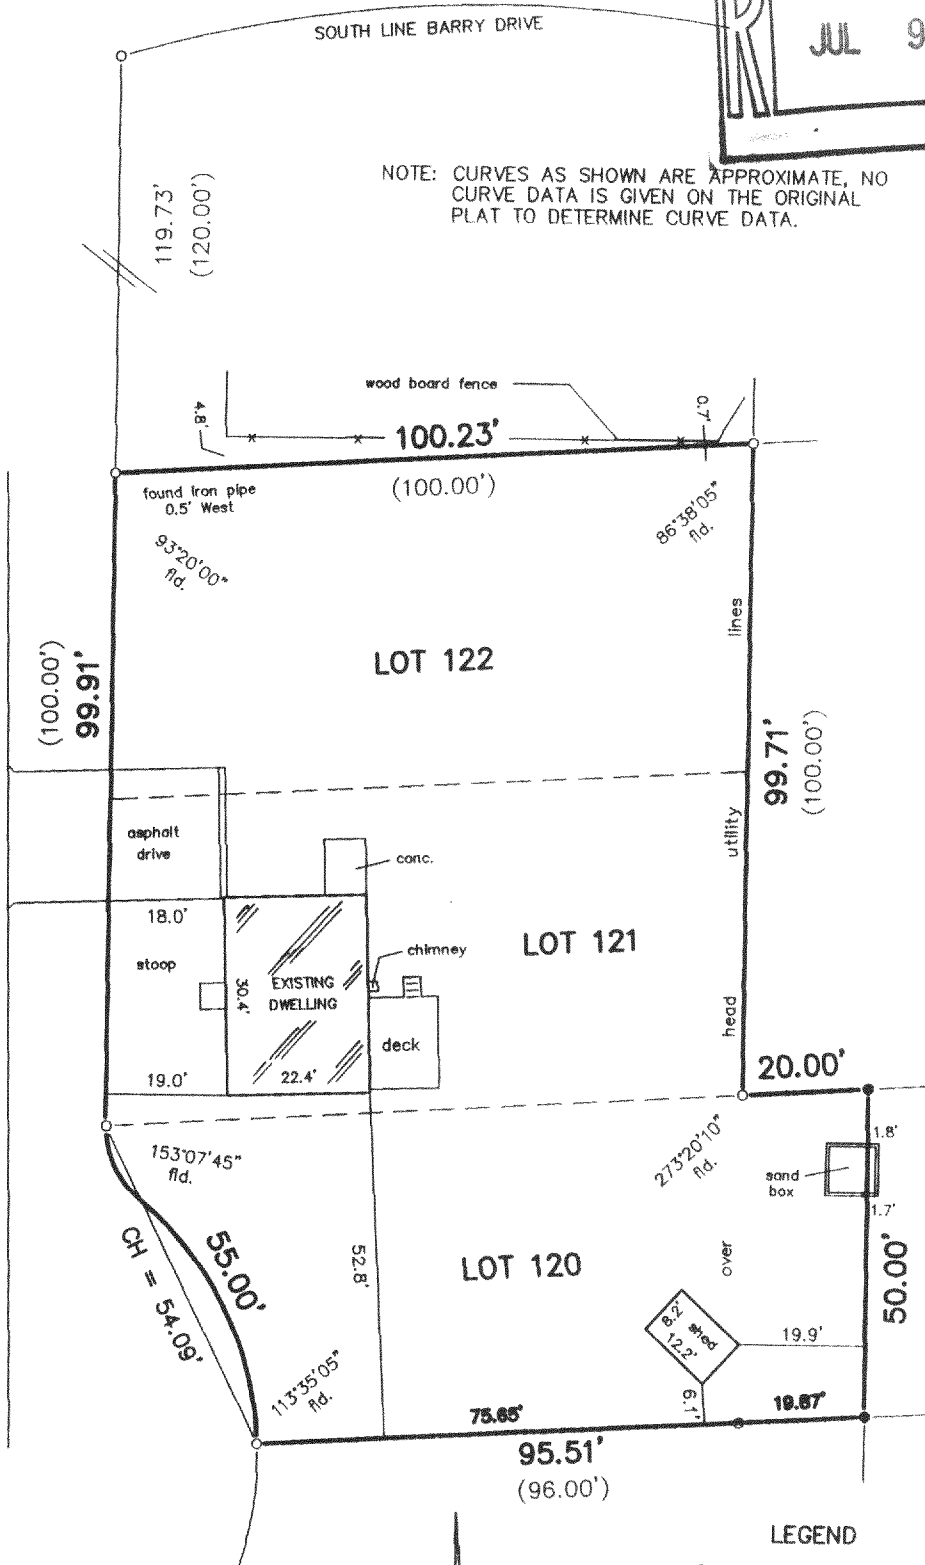


LEGEND

- FOUND IRON PIPE
- SET IRON PIPE
- () PLATTED AS


SCALE: 1" = 30'

"I hereby certify that I have surveyed the above described
property and that the above map is a correct representation thereof
and shows the size and location of the property, its exterior
boundaries, the location of all visible structures and dimensions
of all principal buildings thereon, boundary fences, apparent
easements, roadways and encroachments, if any."

"This survey is made for the use of the present owners of the
property, and those who purchase, mortgage, or guarantee the
title thereto within one year from date hereof."

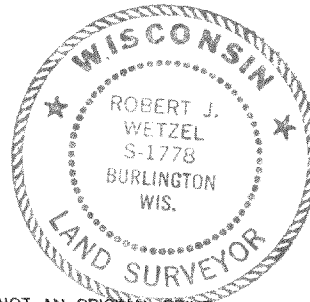

THIS IS NOT AN ORIGINAL PRINT
UNLESS THIS SEAL IS RED.

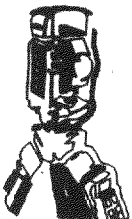

B.W. SURVEYING, INC.

412 N. PINE STREET
BURLINGTON, WI 53105
(262)-767-0225

Robert J. Wetzel
ROBERT J. WETZEL S-1778

APRIL 26, 2002
DATE

5396
JOB NUMBER

NGH-92
NGH-93

218-1305