


PREPARED FOR;
BOB REAVIS
1413 GREENFIELD AVE.
BURLINGTON, WI. 53105

PLAT OF SURVEY

- OF -

UNIT NO. 116 - 1413 GREENFIELD AVE. OF COUNTRY ESTATES
CONDOMINIUM, AS RECORDED IN VOL. 150 RECORDS, PAGE
1 WAL WORTH COUNTY REGISTER OF DEEDS. SECTION 8,
TOWN 2 NORTH, RANGE 18 EAST, WAL WORTH COUNTY,
WISCONSIN.

J.K. SURVEYING INC.
N3705 WILLOWBEND LANE
LAKE GENEVA, WI, 53147
262-248-3697

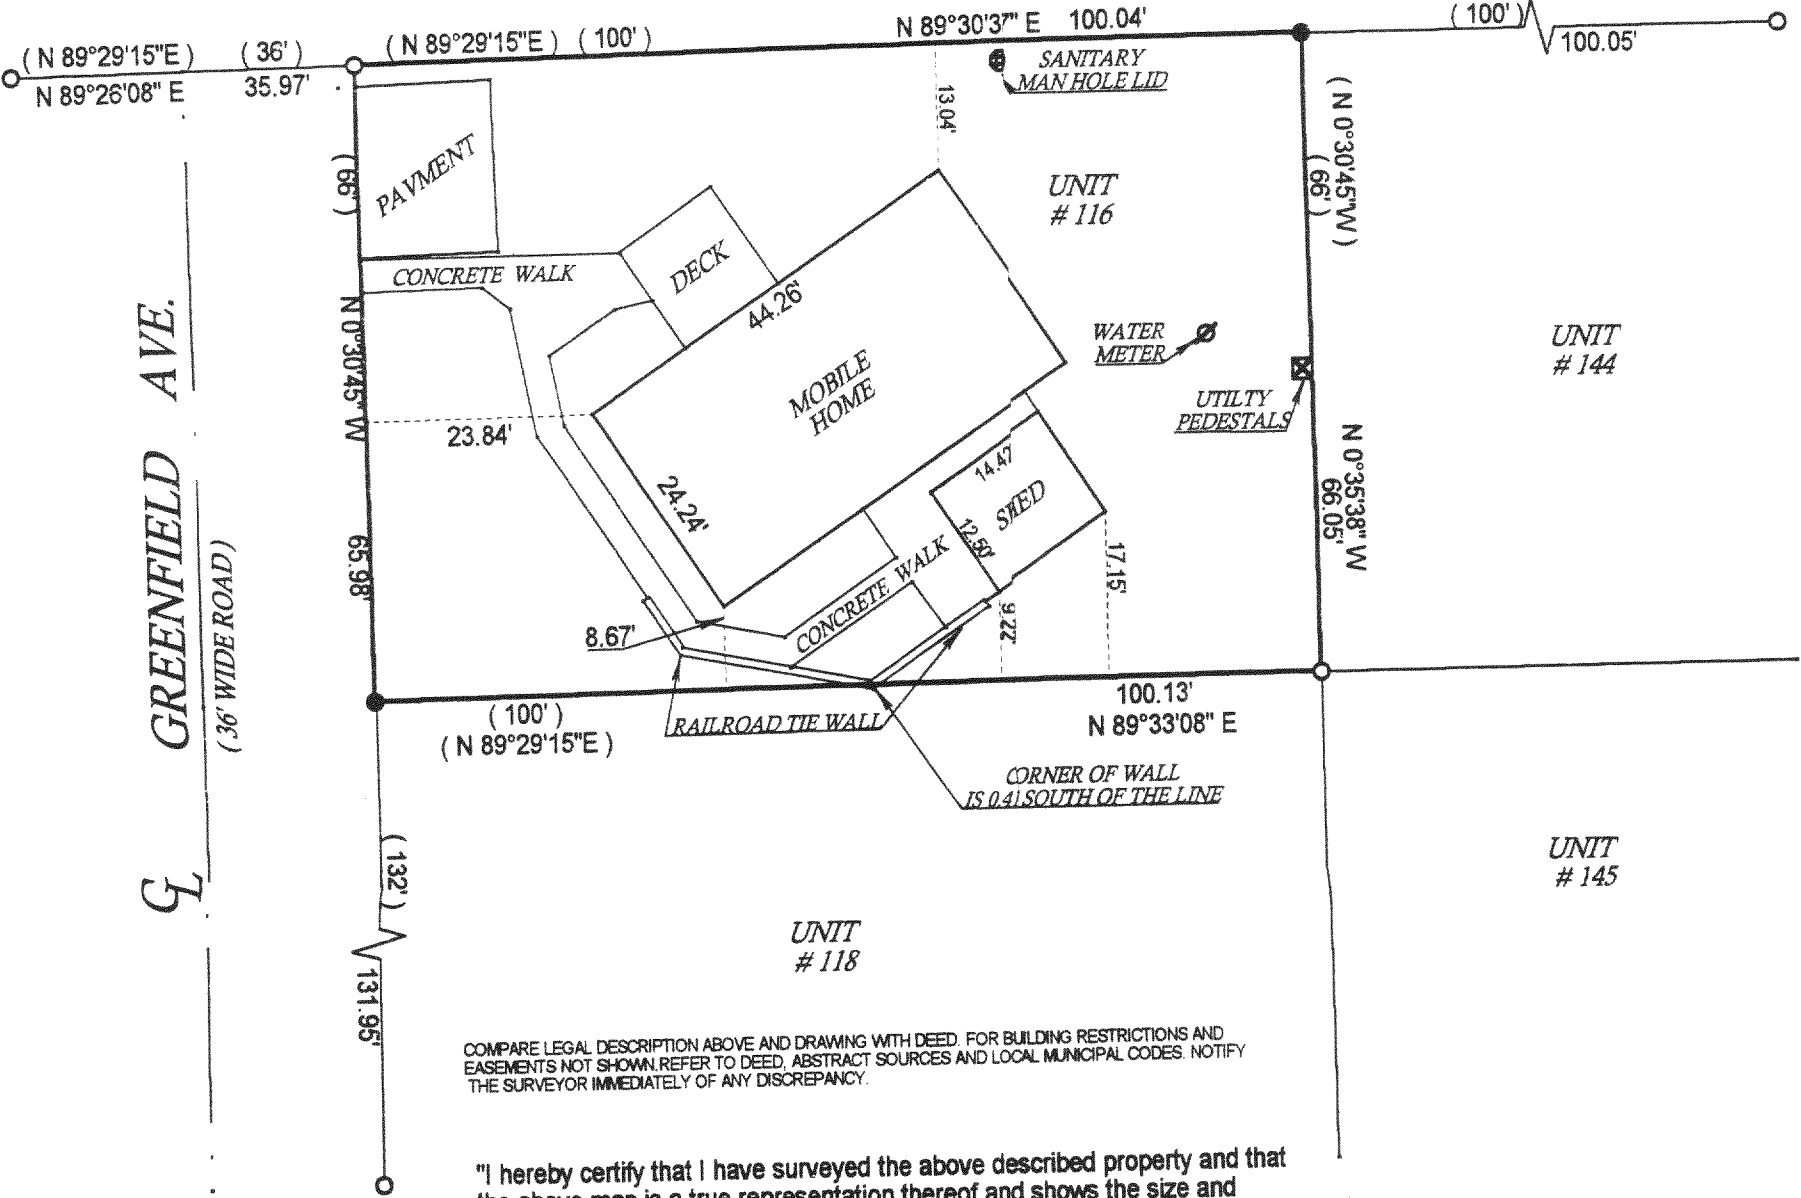

RECEIVED
AUG 16 2002
[Signature]

NORTH

- () = recorded as
- = found iron bar
- = found iron pipe
- = set iron pipe
- = set iron bar

SCALE 1" = 20'
JOB # 02-292
TAX ID # NCS 00116

COMPARE LEGAL DESCRIPTION ABOVE AND DRAWING WITH DEED. FOR BUILDING RESTRICTIONS AND EASEMENTS NOT SHOWN, REFER TO DEED, ABSTRACT SOURCES AND LOCAL MUNICIPAL CODES. NOTIFY THE SURVEYOR IMMEDIATELY OF ANY DISCREPANCY.

"I hereby certify that I have surveyed the above described property and that the above map is a true representation thereof and shows the size and location of all visible structures, apparent easements and encroachments if any."
This survey is made for the present owners of the property, and those who purchase, mortgage, or guarantee the title thereto, within one year from the date hereof. DATED THIS 24 TH, DAY OF JUNE 20 02.



[Signature]
JOHN KROTT S - 2258
Wisconsin Registered Land Surveyor
(original if signed in red)

NCS-116

218-1317