

PREPARED FOR:
VERN STEPHAN
818 HIGH STREET
LAKE GENEVA, WI. 53147

PLAT OF SURVEY


- OF -

J.K. SURVEYING INC.
N3705 WILLOWBEND LANE
LAKE GENEVA, WI, 53147
262-248-3697

LOT 1 OF CERTIFIED SURVEY MAP # 1188 A C.S.M. BEING LOT 5
OF LYON'S INDUSTRIAL PARK AND LOCATED IN THE SOUTHEAST
1/4 OF SECTION 19, TOWN 2 NORTH, RANGE 18 EAST, WALWORTH
COUNTY, WISCONSIN.

CREST DRIVE

(66' WIDE ROAD)

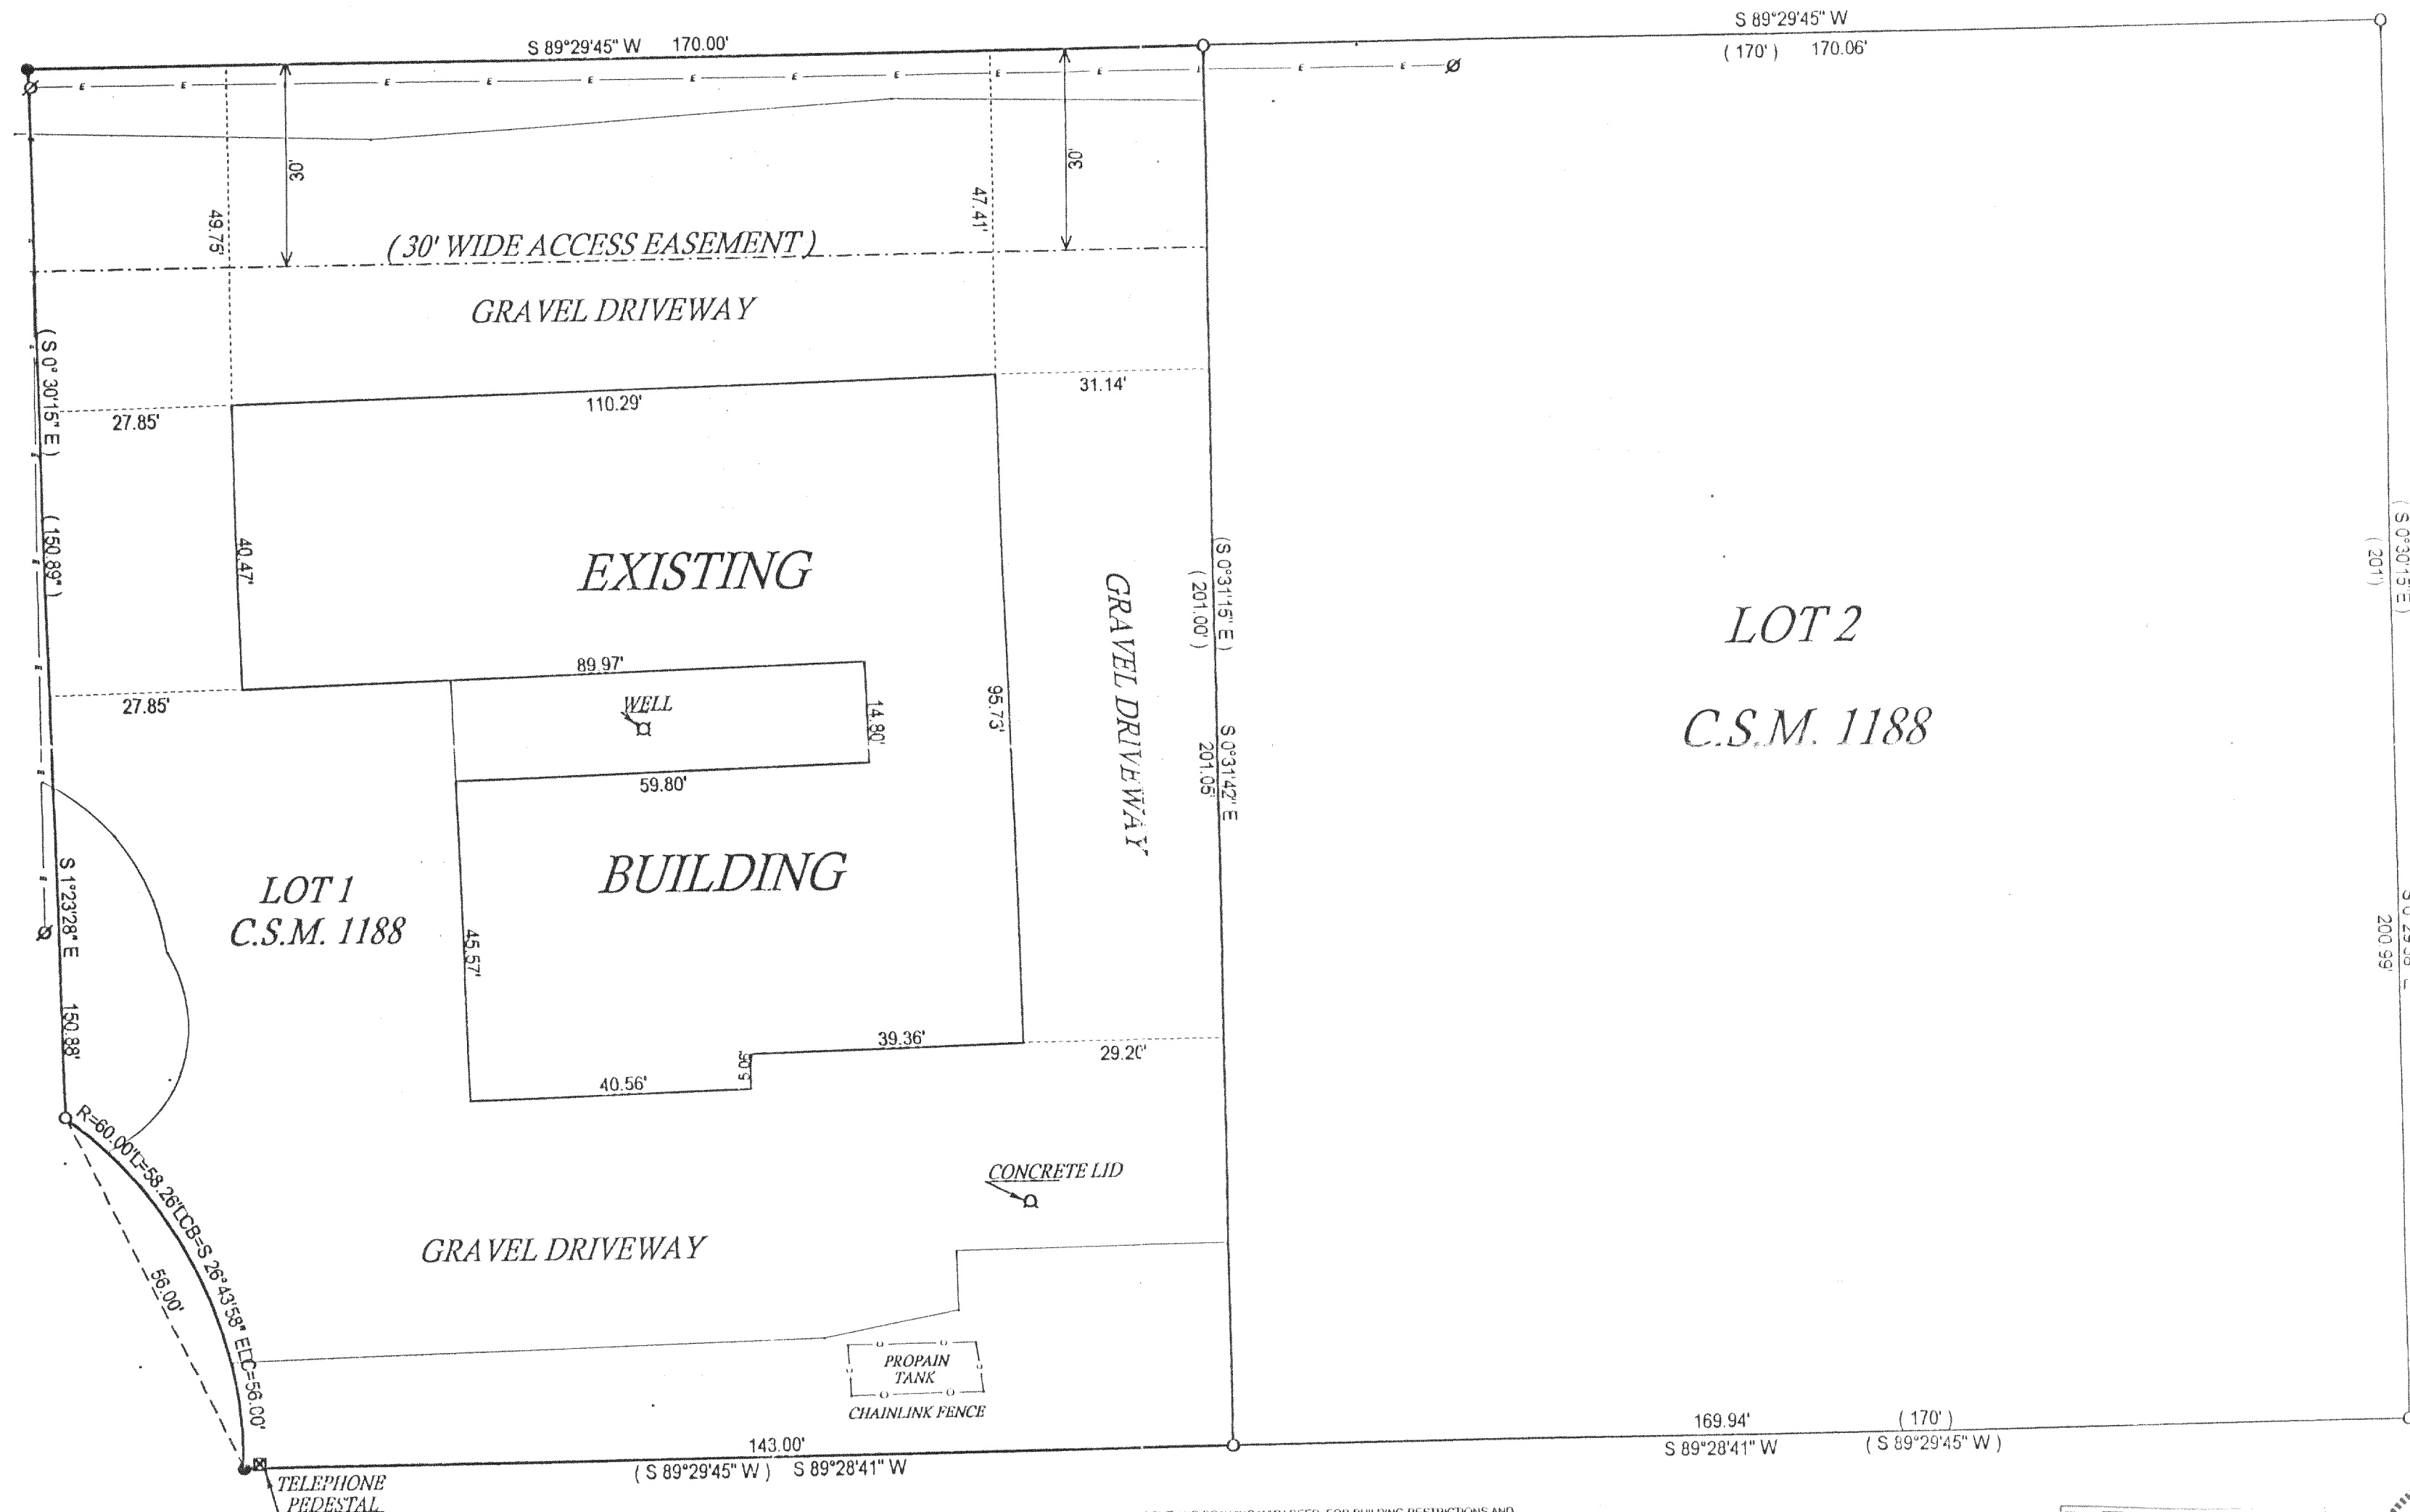

- ⊗ = power pole
- () = recorded as
- = iron pipe found
- = iron pipe set

SCALE 1" = 20'

JOB # 02-256



TAX # NA118900001

COMPARE LEGAL DESCRIPTION ABOVE AND DRAWING WITH DEED FOR BUILDING RESTRICTIONS AND EASEMENTS NOT SHOWN REFER TO DEED, ABSTRACT SOURCES AND LOCAL MUNICIPAL CODES. NOTIFY THE SURVEYOR IMMEDIATELY OF ANY DISCREPANCY.

"I hereby certify that I have surveyed the above described property and that the above map is a true representation thereof and shows the size and location of all visible structures, apparent easements and encroachments if any."

This survey is made for the present owners of the property, and those who purchase, mortgage, or guarantee the title thereto, within one year from the date hereof.

DATED THIS 6 TH, DAY OF JUNE 20 02

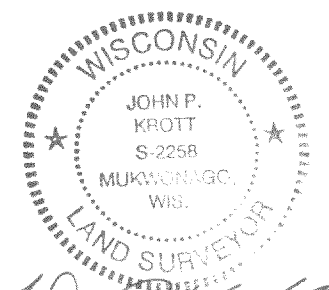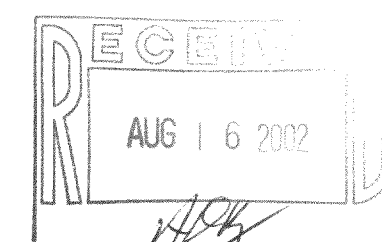

JOHN KROTT S - 2258
Wisconsin Registered Land Surveyor
(original if signed in red)

218-1322