

**PLAT OF SURVEY
-OF-**


LOT 14, BLOCK 2, FIRST ADDITION TO KNOLL BROOK, BEING
A SUBDIVISION OF PART OF THE NORTHWEST 1/4 OF THE
SOUTHWEST 1/4 AND PART OF THE SOUTHWEST 1/4 OF
THE SOUTHWEST 1/4 OF SECTION 10, TOWNSHIP 2 NORTH,
RANGE 18 EAST, TOWN OF LYONS, WALWORTH COUNTY,
WISCONSIN.

SURVEY FOR: GENE AND JOETTE MATHER
SURVEY ADDRESS: 6172 RAVEN COURT

TOP OF FOUNDATION ELEVATION = 101.8'

CURVE DATA

CENTRAL ANGLE = $62^{\circ}12'48''$
RADIUS = 60.00'
CHORD = 62.00'
CHORD BEARING = $542^{\circ}48'16''E$

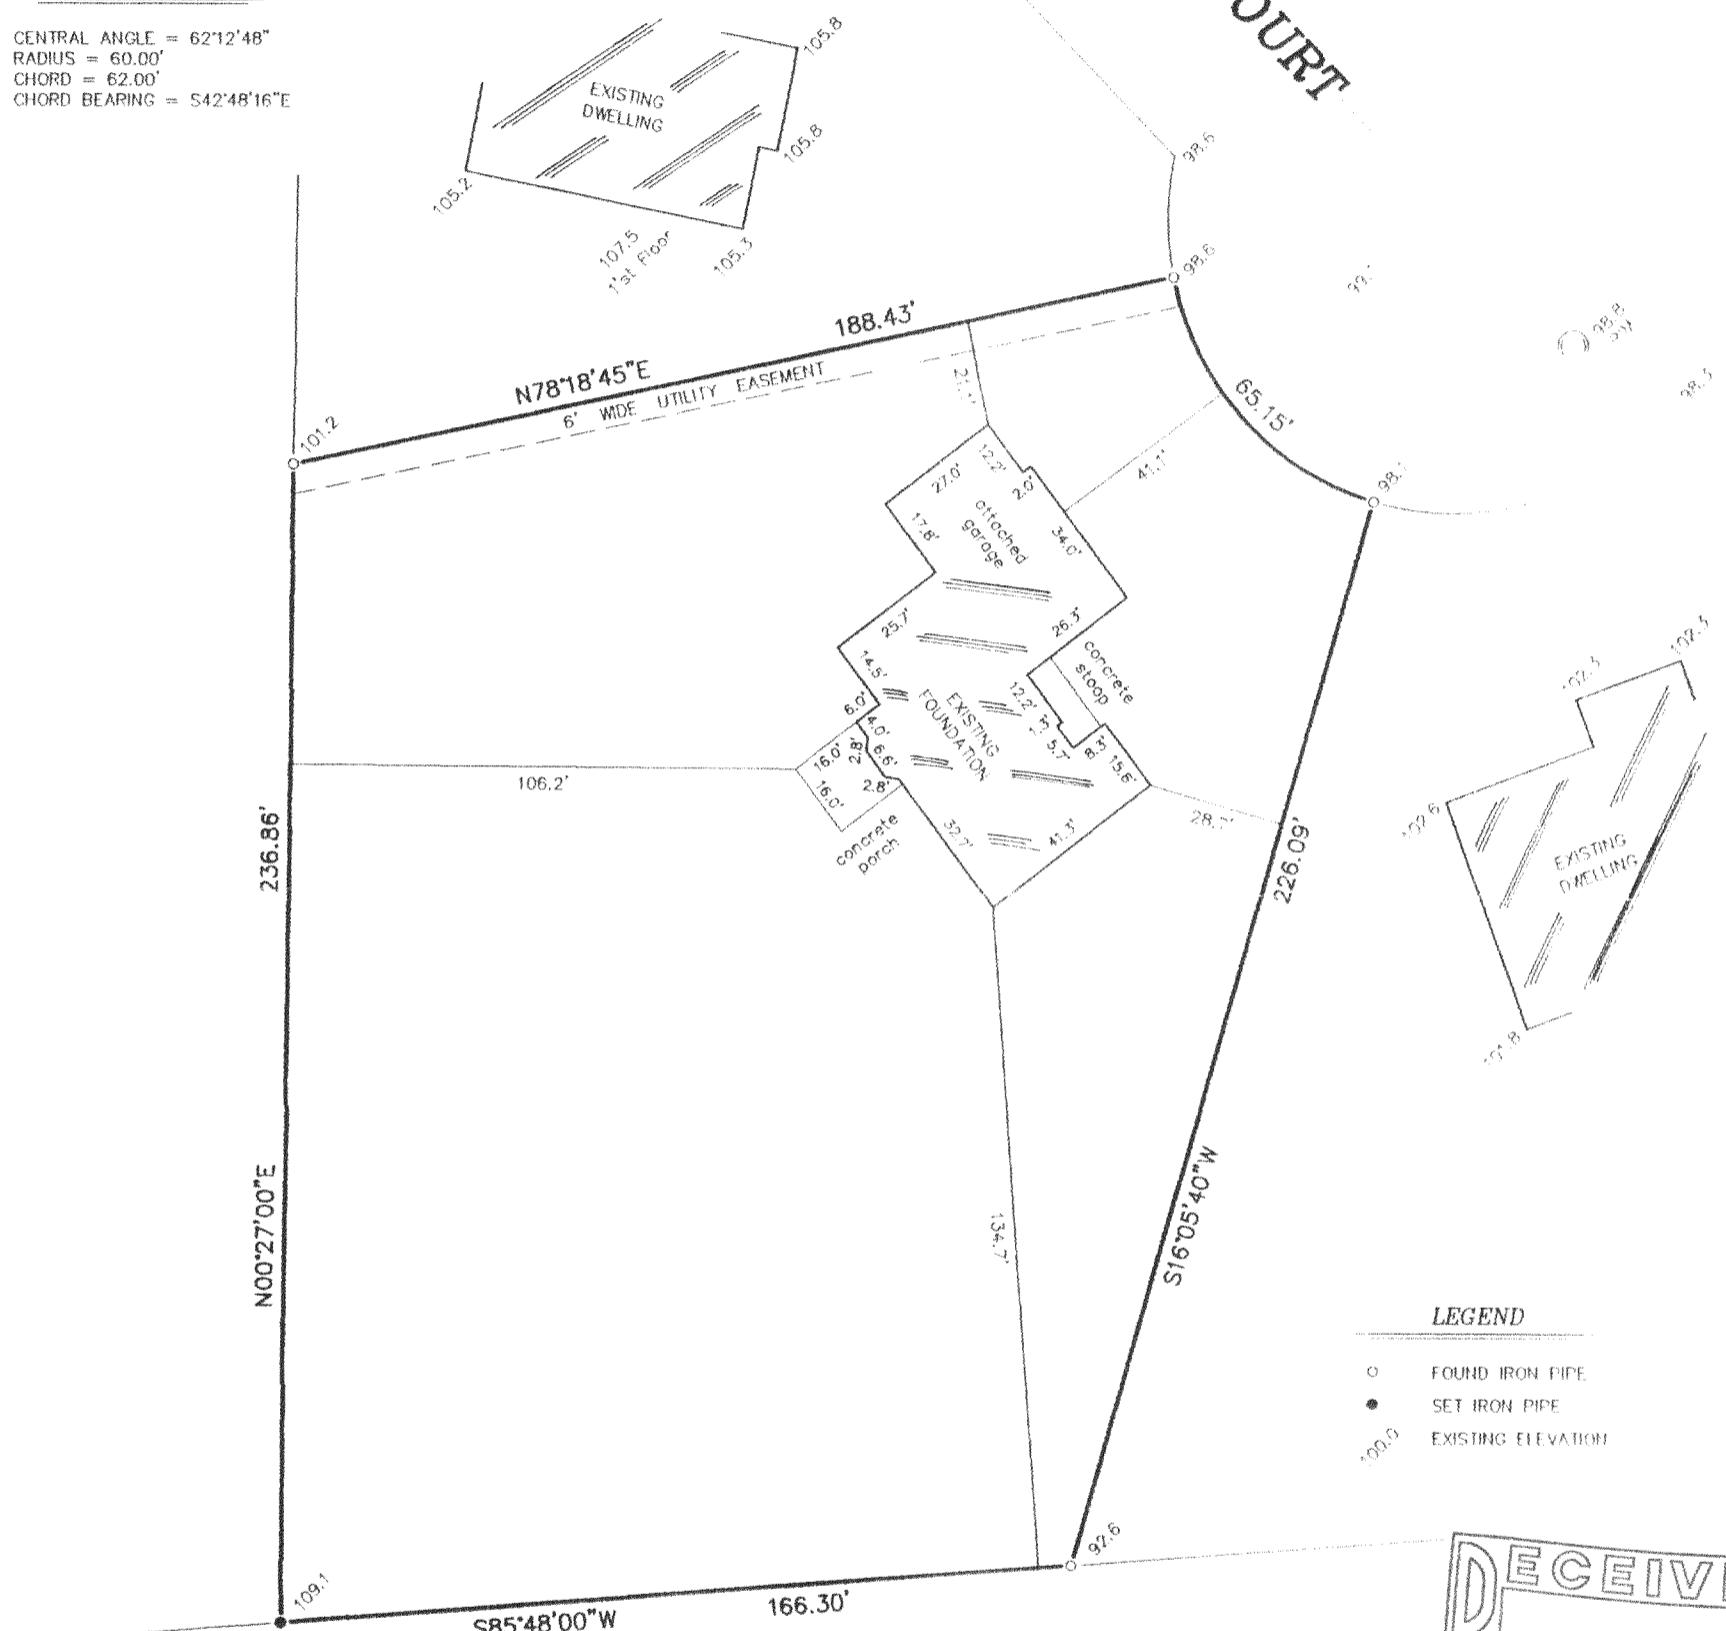


"I hereby certify that I have surveyed the above described property and that the above map is a correct representation thereof and shows the size and location of the property, its exterior boundaries, the location of all visible structures and dimensions of all principal buildings thereon, boundary fences, apparent easements, roadways and encroachments, if any."

"This survey is made for the use of the present owners of the property, and those who purchase, mortgage, or guarantee the title thereto within one year from date hereof."

SCALES

$$1'' = 40'$$

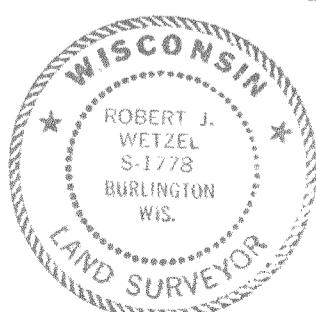

THIS IS NOT AN ORIGINAL PRINT
UNLESS THIS SEAL IS RED.

B.W. SURVEYING, INC.
LAND SURVEYS
MAPPING AND PLANNING
412 N. PINE STREET
BURLINGTON, WI 53105
(262)-767-0225

Robert
ROBERT J. WETZEL
REVISED: 09/20/02
AUGUST 16, 2002
DATE

5517
JOB NUMBER

5517

KODAK WONDER

218-1340

NKOI - 13