

PLAT OF SURVEY

J.K. SURVEYING INC.
N3705 WILLOWBEND LANE
LAKE GENEVA, WI, 53147
262-248-3697

- OF -


UNIT 203 PHASE TWO OF COUNTRY ESTATES, LOCATED IN THE NORTHWEST 1/4 OF SECTION 8
AND IN THE NORTHEAST 1/4 OF SECTION 7, TOWN 2 NORTH, RANGE 18 EAST, WALWORTH
COUNTY, WISCONSIN.

TOGETHER WITH THE EXCHANGE OF RIGHTS OF USE WITH UNIT 202 OF THEIR LIMITED
COMMON ELEMENTS COMMONLY KNOWN AS INDIVIDUAL GROUNDS AS RECORDED
IN THE WALWORTH COUNTY REGISTER OF DEEDS AS DOCUMENT NUMBER 12974,
VOLUME 369 PAGE 819; REFERED TO AS EXHIBIT "A & B".

ORDERED BY :

ROMAN W. BULKIEWICZ
HOMESTEAD LAKES REALTY
LAKE GENEVA, WI

PROPERTY ADDRESS
7009 CLOVER CT.

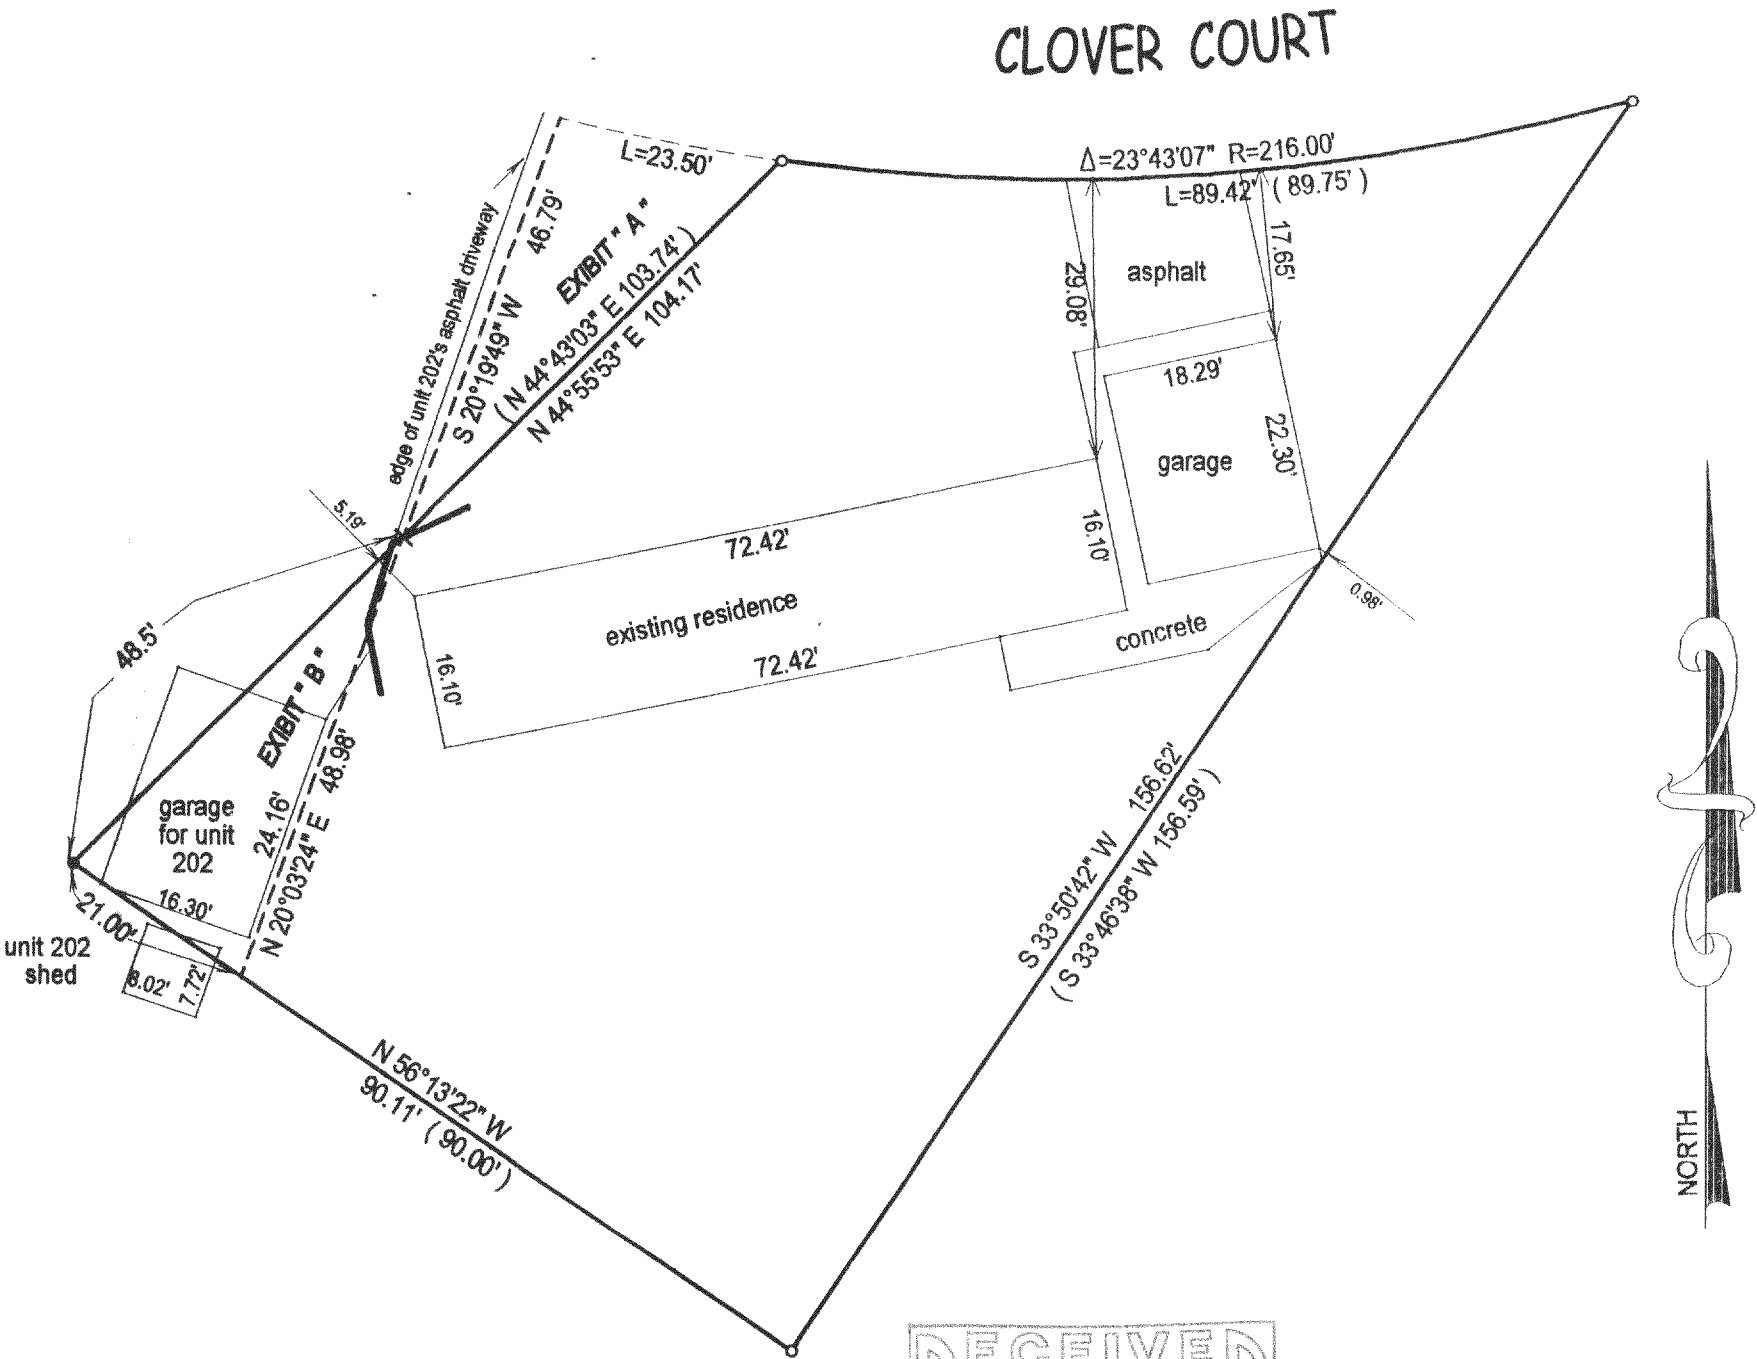


- () = recorded as
- = found iron bar
- = found iron pipe
- = set iron pipe
- = set iron bar

SCALE 1" = 20'

JOB # 02-402

TAX ID #

NCS 00203

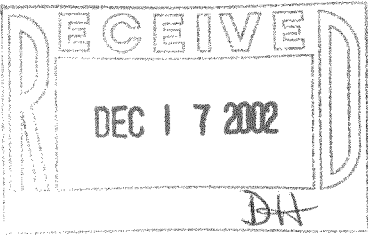

COMPARE LEGAL DESCRIPTION ABOVE AND DRAWING WITH DEED. FOR BUILDING RESTRICTIONS AND
EASEMENTS NOT SHOWN, REFER TO DEED, ABSTRACT SOURCES AND LOCAL MUNICIPAL CODES. NOTIFY
THE SURVEYOR IMMEDIATELY OF ANY DISCREPANCY.

"I hereby certify that I have surveyed the above described property and that
the above map is a true representation thereof and shows the size and
location of all visible structures, apparent easements and encroachments
if any."

This survey is made for the present owners of the property, and those who
purchase, mortgage, or guarantee the title thereto, within one year from
the date hereof.

DATED THIS 27 TH, DAY OF AUGUST 20 02 .



JEFFREY L. KIMPS S - 2436
Wisconsin Registered Land Surveyor
(original if signed in red)

NCS-203

218-1350