
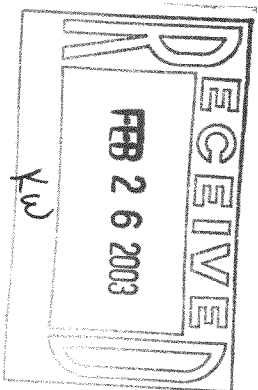
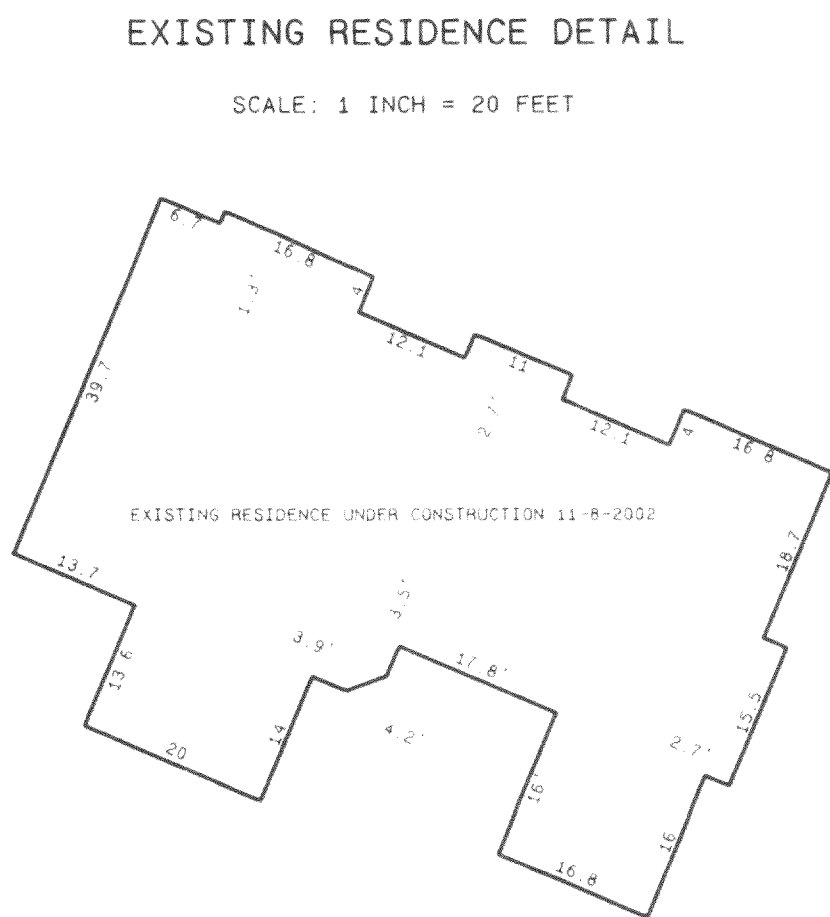
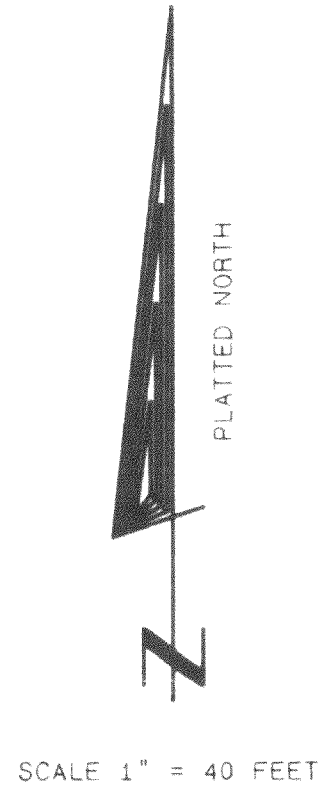


PLAT OF SURVEY

LOT 8 OF THE REPLAT OF STURGIS PARTNERS LTD.
SUBDIVISION, LOCATED IN SECTIONS 22 AND 23, TOWN 2
NORTH, RANGE 18 EAST, TOWN OF LYONS, WALWORTH COUNTY,
WISCONSIN.


OWNERS: THOMAS & KIMBERLY ROUCE
P.O. BOX 81
LYONS, WI. 53148

ORDERED BY: MIDWEST BUILDERS OF BURLINGTON
TIM WEILER
5152 RUEDEBUSCH RD.
BURLINGTON, WI 53105

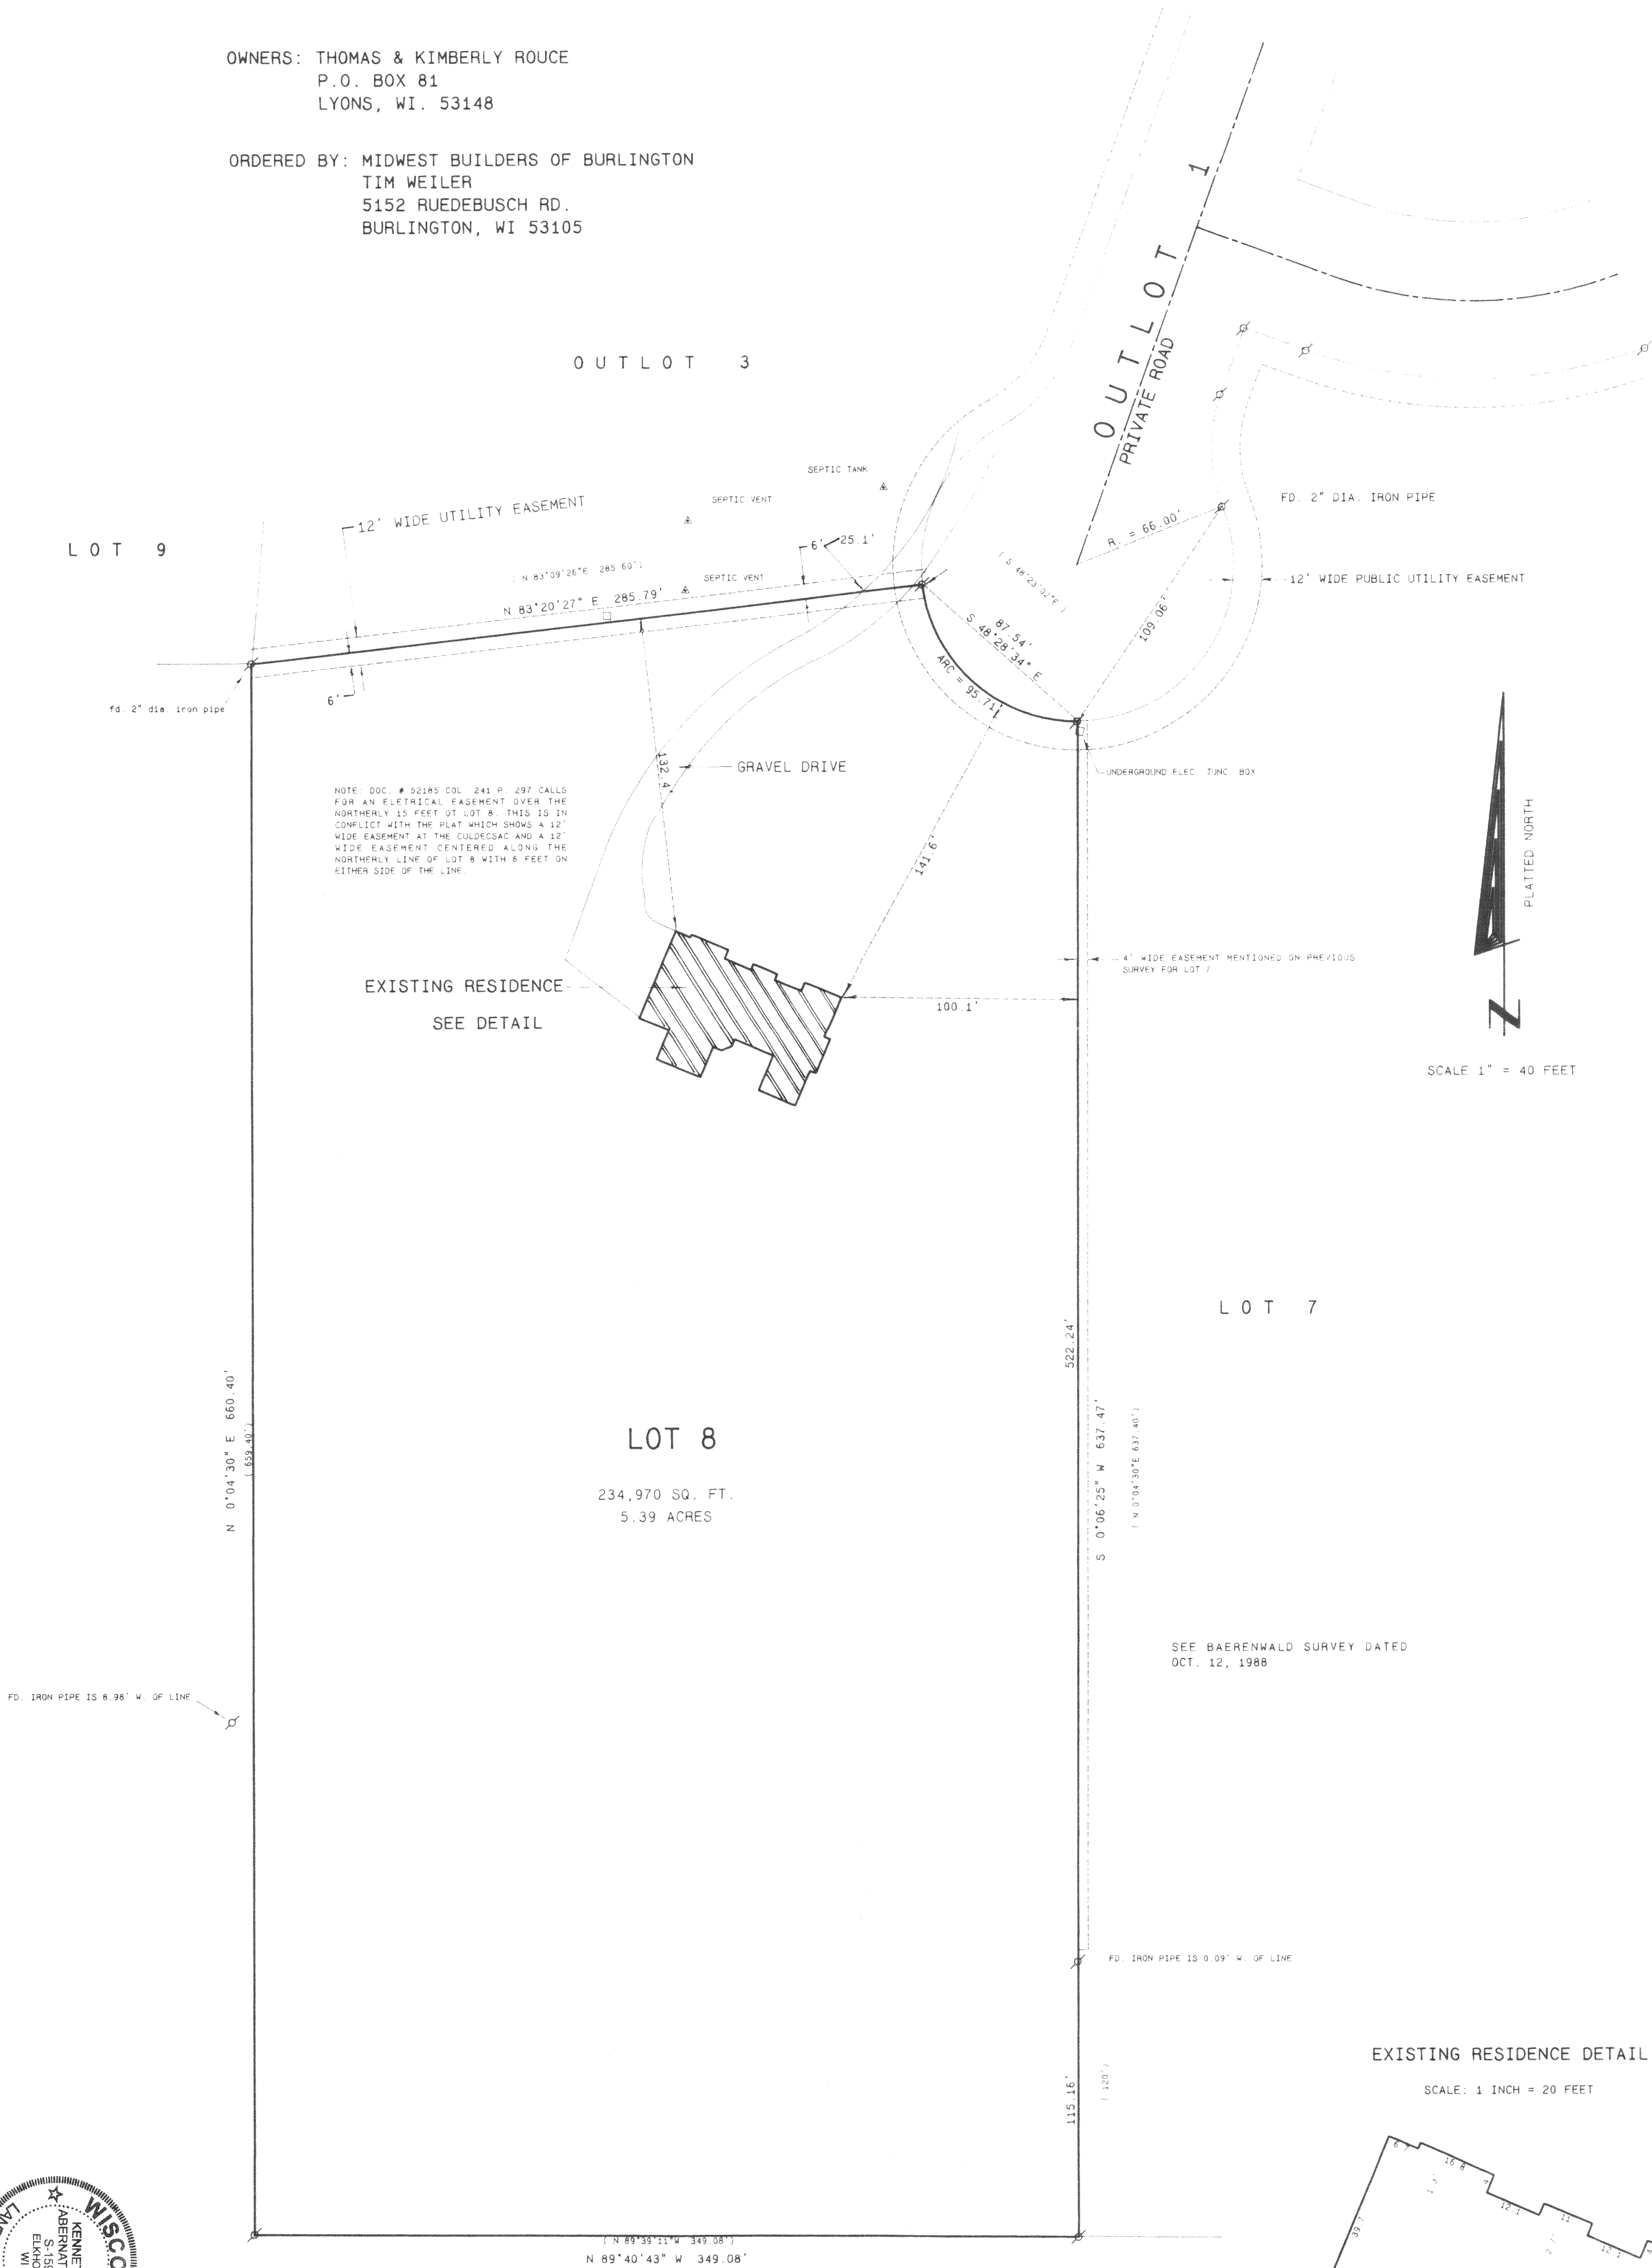

- Legend**
- FOUND IRON PIPE
 - FOUND BRASS CAPED MONUMENT
 - FOUND CONCRETE MONUMENT
 - SET IRON ROD 3/4" LONG, WEIGHING 1.5 LBS. (LINEAL FT. - 3" DIA.)
 - SET IRON ROD 3/4" LONG, WEIGHING 1.5 LBS. (LINEAL FT. - 3" DIA.)
 - RECORDED AS DIMENSION
 - EXISTING FENCE

SCALE: 1"= 40 FEET

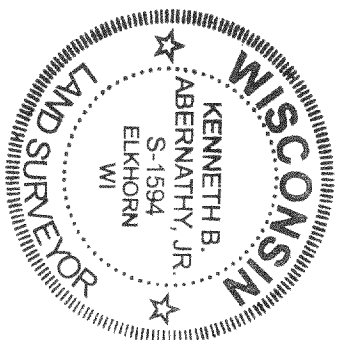

REVISED TO SHOW PROPOSED RESIDENCE JULY 18, 2002
REVISED TO SHOW RESIDENCE "AS BUILT" NOV. 11, 2002

Kenneth B. Abernathy, Jr.
KENNETH B. ABERNATHY, JR.
WISCONSIN REGISTERED LAND SURVEYOR,
S-1594
Date: 8-21-98 Job No. 9880Z