

# Plat of Survey


of

## Unit 151 of Phase I of Country Estates,

a condominium located in the Northwest 1/4 of Section 8, Town 2 North, Range 18 East, Town of Lyons, Walworth County, Wisconsin.

Surveyed for: **Coldwell Banker, Beardsley & Associates**



598 Milwaukee Avenue  
Burlington, Wisconsin 53105

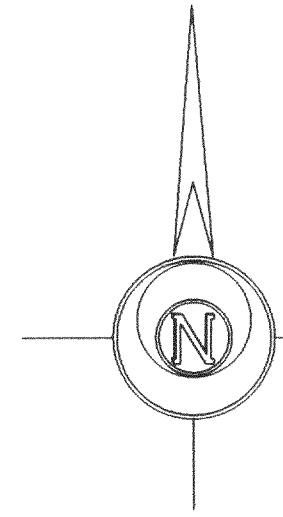

Bearings referenced to the  
plat of Country Estates.

### Circle Drive

(36' Wide)

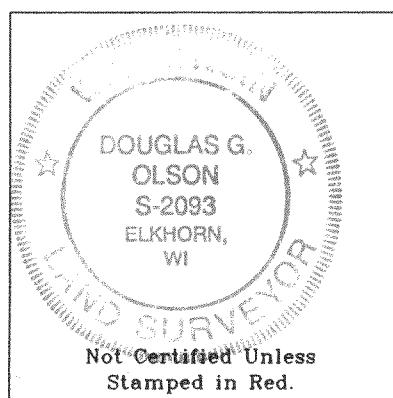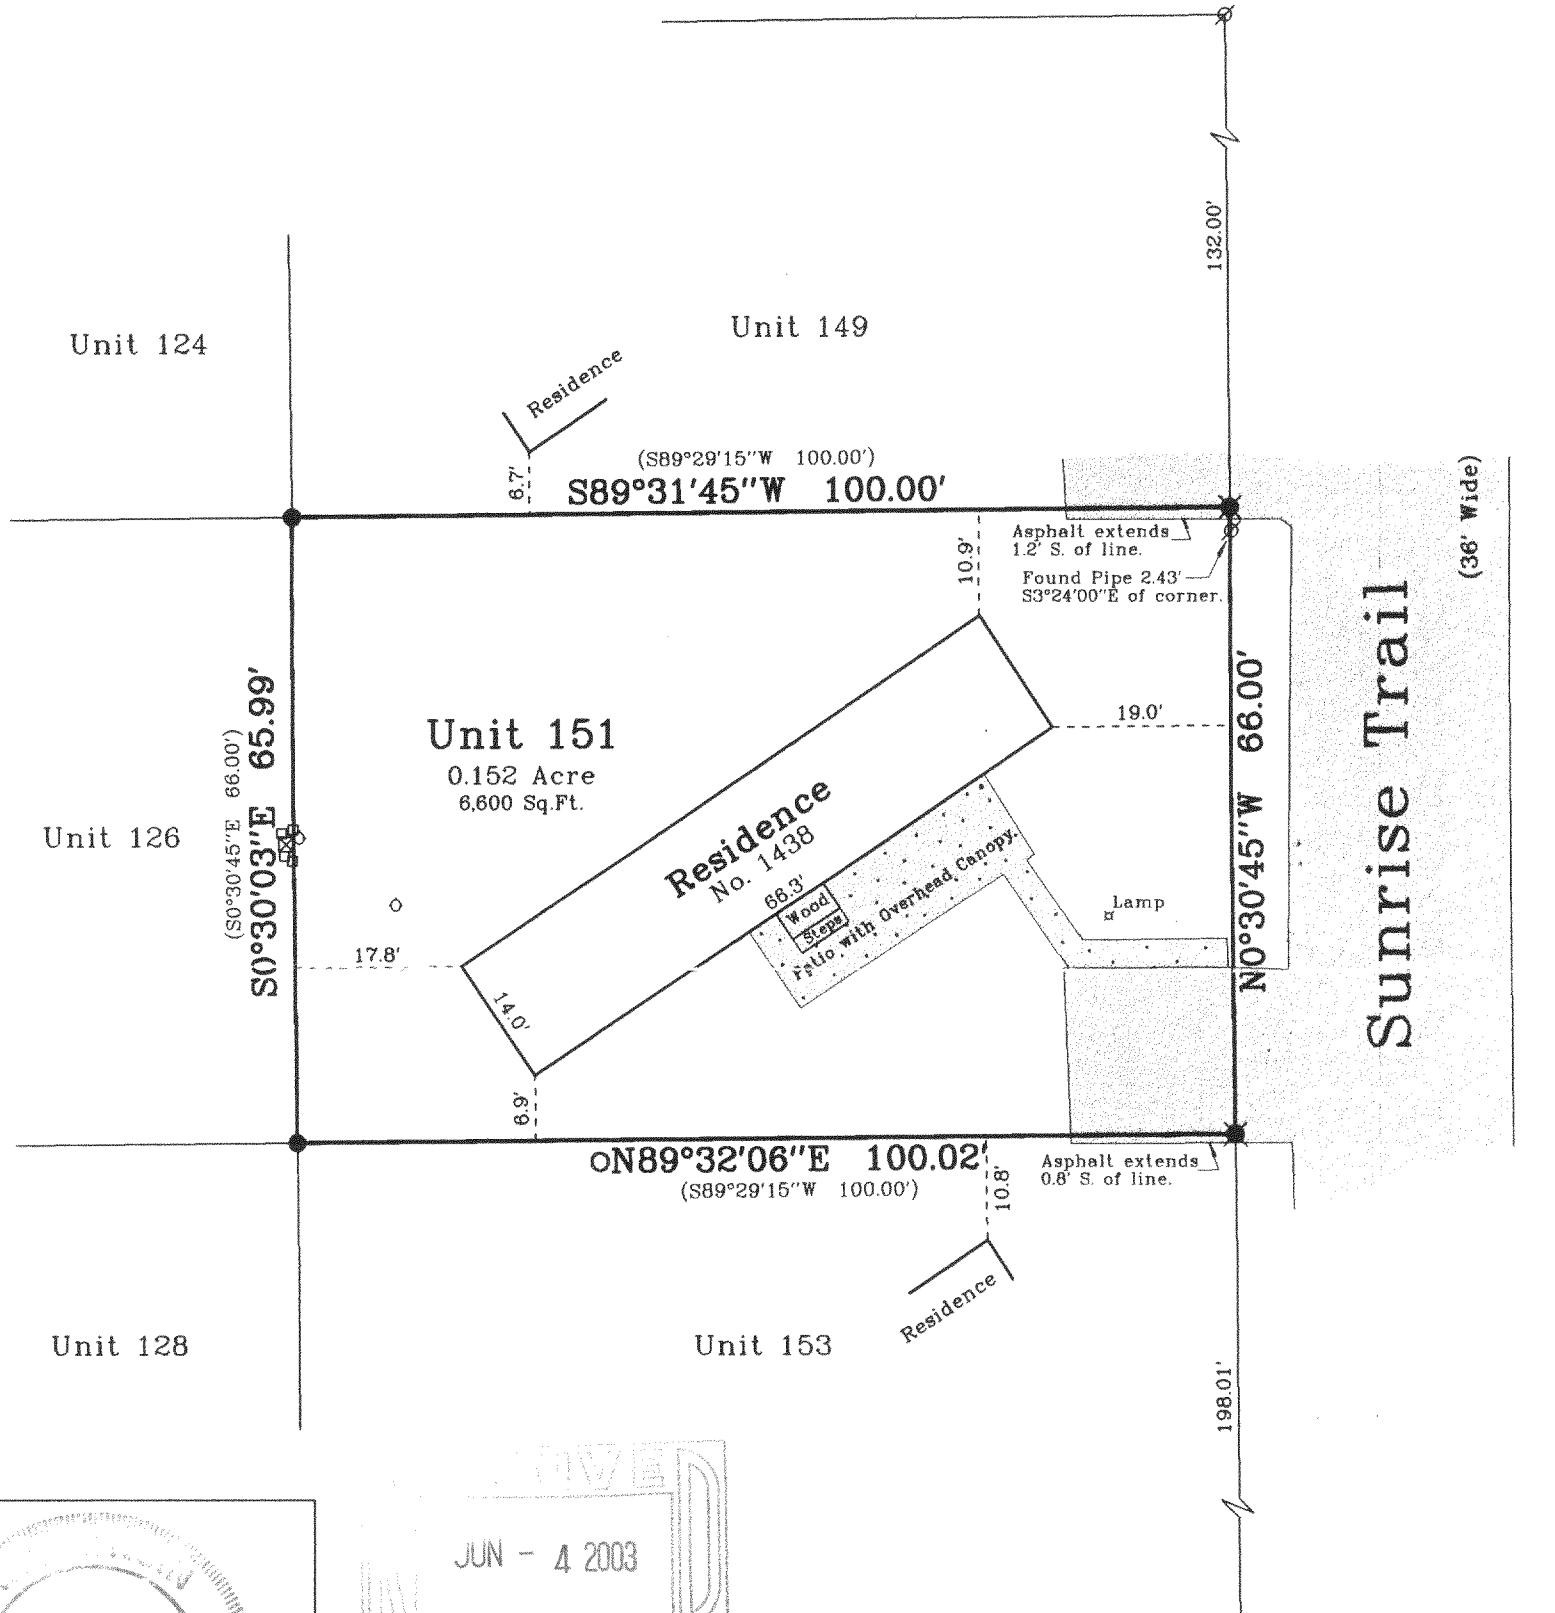

Copyright © 2003 by Jensen & Olson Land Surveying, LLC.

All rights reserved. No part of this survey plat may be reproduced or transmitted in any form by any means - graphic, electronic, or mechanical, including photocopying, tracing, or information storage and retrieval systems - without permission in writing from Douglas G. Olson, Jensen & Olson Land Surveying, LLC.

I, Douglas G. Olson, Wisconsin Registered Land Surveyor, do hereby certify that this survey was performed by me or under my direction in full compliance with the owner's/agent's instructions and Chapter A-E 7 of the Wisconsin Administrative Code "Minimum Standards for Property Surveys"; and that this map is an accurate representation thereof to the best of my knowledge and belief.

Douglas G. Olson  
Wisconsin Registered Land Surveyor - 2093

#### Notes:

- This survey plat is not certified unless signed and sealed in red ink.
- This survey is subject to Wisconsin lien laws. This Plat of Survey is the notice of intent to file lien. Lien waiver required.

Douglas G. Olson  
Wisconsin Registered Land Surveyor - 2093

#### Legend

- Found Iron Pipe
- Set Iron Rod, 3/4" diameter
- Set RR Spike
- Recorded Information
- Concrete Surface
- Asphalt Surface
- Water Valve of meter
- Utility pedestals & meters
- Manhole



#### Jensen & Olson Land Surveying, LLC

45 South Wisconsin Street P.O. Box 322  
Elkhorn, Wisconsin 53121  
Telephone: (262) 723-3434  
Facsimile: (262) 723-8044

Scale: 1" = 20'  
0' 10' 20' 40' 60'

Survey date: April 24, 2003.

Revisions:

Sheet 1 of 1 Sheets.

Job Reference Number:

2003.064