


PLAT OF SURVEY

-OF-

LOTS 9-14, BLOCK 5, VILLAGE OF SPRINGFIELD, ACCORDING TO THE RECORDED PLAT THEREOF. SAID LAND BEING IN THE TOWNSHIP OF LYONS, WALWORTH COUNTY, WISCONSIN.

SURVEY FOR: RUTH VORPAGEL
SURVEY LOCATION: 7641 SPRINGFIELD ROAD

PROPOSED GARAGE WAS NOT STAKED BY THIS OFFICE.

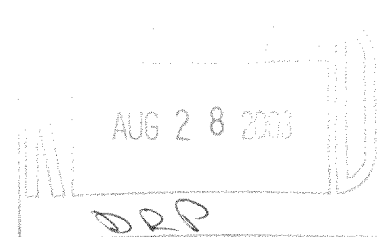

LEGEND

FOUND STANDARD WALWORTH COUNTY MONUMENT


"I hereby certify that I have surveyed the above described property and that the above map is a correct representation thereof and shows the size and location of the property, its exterior boundaries, the location of all visible structures and dimensions of all principal buildings thereon, boundary fences, apparent easements, roadways and encroachments, if any."

"This survey is made for the use of the present owners of the property, and those who purchase, mortgage, or guarantee the title thereto within one year from date hereof."

SCALE: 1" = 40'

ROSE STREET
66' WIDE
NOT CONSTRUCTED

S.T.H.
"120"

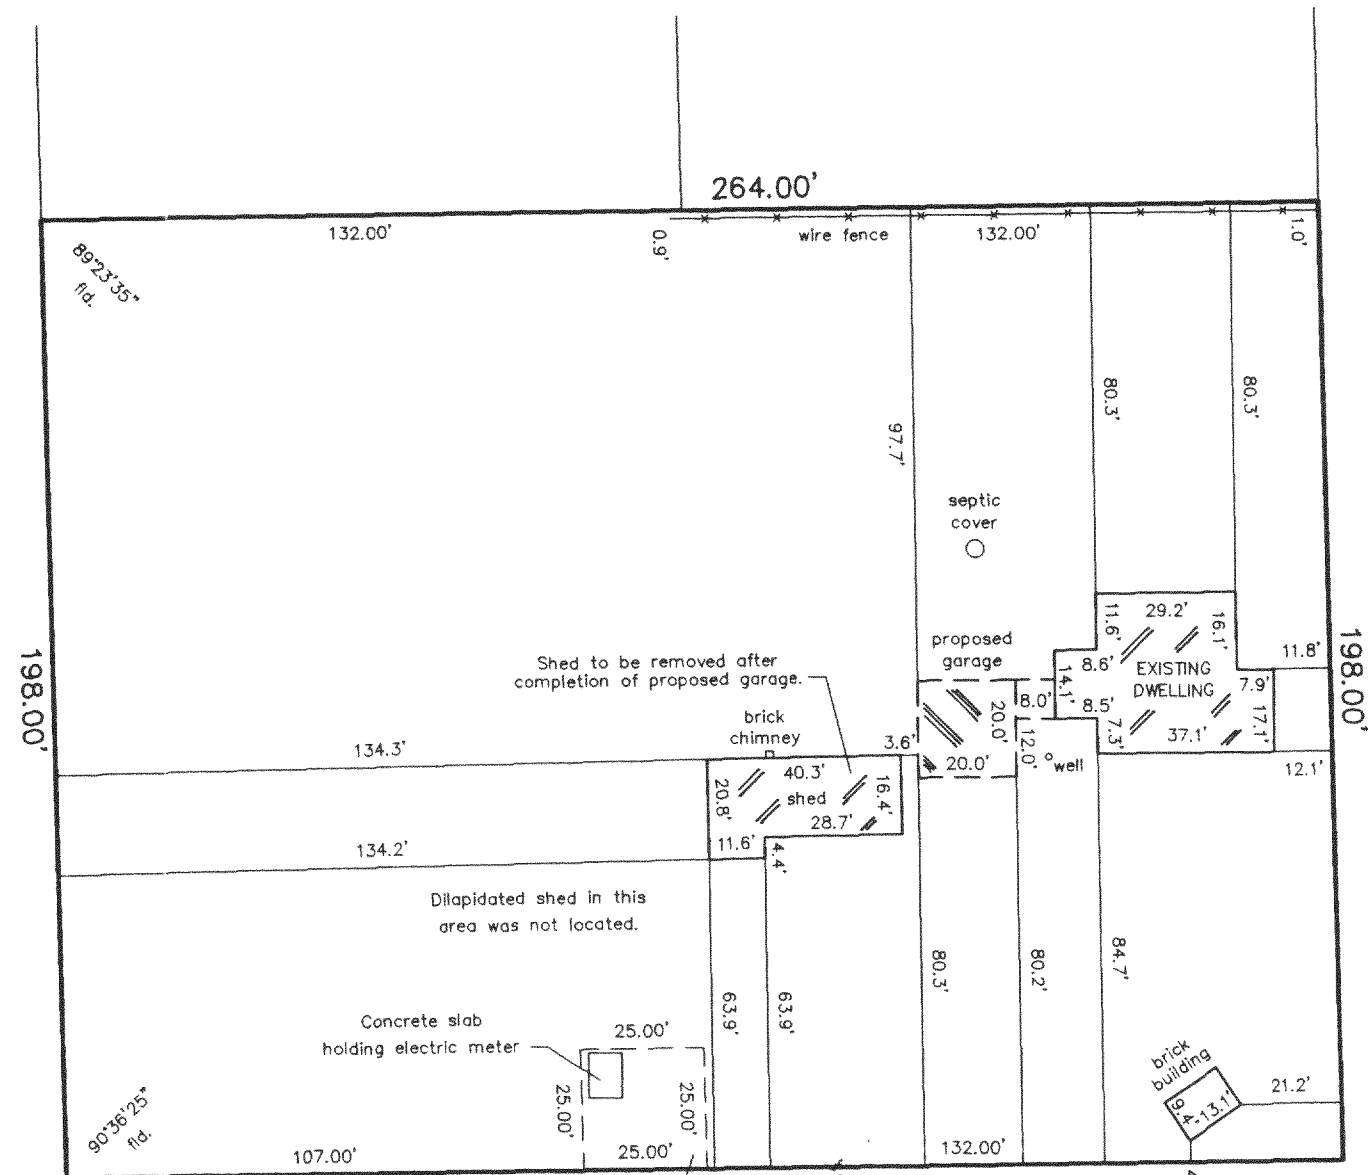


Easement as shown by previous survey by Jensen Surveying & Mapping S.C., dated February 1, 1988.

SPRINGFIELD ROAD


SOUTH LINE OF THE SOUTHWEST 1/4 OF SECTION 7-2-19

SOUTH 1/4 CORNER SECTION 7-2-18

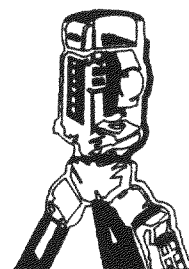

B.W. SURVEYING, INC.

LAND SURVEYS
MAPPING AND PLANNING
412 N. PINE STREET
BURLINGTON, WI 53105
(262)-767-0225

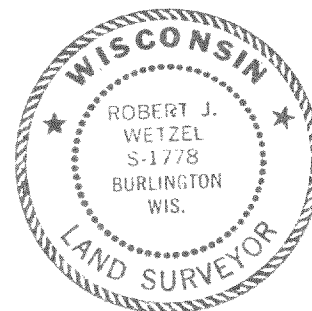

THIS IS NOT AN ORIGINAL PRINT
UNLESS THIS SEAL IS RED.

MONUMENTATION BY WRITTEN AGREEMENT WITH THE ABOVE NAMED CLIENT HAS BEEN WAIVED IN ACCORDANCE WITH A-E 7.01(2) OF THE WISCONSIN ADMINISTRATIVE CODE.

Robert J. Wetzel
ROBERT J. WETZEL S-1778

MAY 1, 2003
DATE

5856
JOB NUMBER

NVS-19

218-1398